


BEING A PORTION OF SECTION 3, TOWNSHIP 21 SOUTH, RANGE 61 EAST,
MOUNT DIABLO MERIDIAN, CLARK COUNTY, NEVADA

I, RICHARD G. WILSON, A PROFESSIONAL LAND SURVEYOR LICENSED
IN THE STATE OF NEVADA, AS AGENT FOR CCR PRECISION SURVEYING, LLC.,
DO HEREBY CERTIFY THAT:

1. THIS PLAT REPRESENTS THE RESULTS OF A SURVEY CONDUCTED UNDER MY DIRECT SUPERVISION AT THE INSTANCE OF LAS VEGAS VALLEY WATER DISTRICT.
2. LANDS SURVEYED LIE WITHIN SECTION 3, TOWNSHIP 21 SOUTH, RANGE 61 EAST, MOUNT DIABLO MERIDIAN, CLARK COUNTY, NEVADA AND THIS SURVEY WAS COMPLETED ON FEBRUARY 6, 2013.
3. THIS PLAT COMPLIES WITH THE APPLICABLE STATE STATUTES AND ANY LOCAL ORDINANCES IN EFFECT ON THE DATE THAT THE SURVEY WAS COMPLETED, AND THE SURVEY WAS CONDUCTED IN ACCORDANCE WITH CHAPTER 625 OF THE NEVADA ADMINISTRATIVE CODE.
4. THE MONUMENTS DEPICTED ON THE PLAT ARE OF THE CHARACTER SHOWN, OCCUPY THE POSITIONS INDICATED, AND ARE OF SUFFICIENT NUMBER AND DURABILITY.
5. THIS SURVEY WAS PERFORMED FOR POST-CONSTRUCTION RE-ESTABLISHMENT OF HUNTRIDGE MONUMENTATION AND IS NOT A SUBDIVISION.


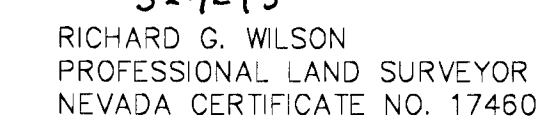


THE BASIS OF BEARINGS FOR THE SURVEY SHOWN HEREON IS NORTH 01° 42' 22" EAST BEING THE CENTERLINE OF 8TH STREET BETWEEN OAKLEY BLVD AND SWEENEY AVE. AS SHOWN ON FILE 80, PAGE 46 OF SURVEYS.

PLAT: BOOK 04, PAGE 18
PLAT: BOOK 03, PAGE 92
PLAT: BOOK 02, PAGE 26
PLAT: BOOK 01, PAGE 69
PLAT: BOOK 03, PAGE 04
PLAT: BOOK 03, PAGE 58
PLAT: BOOK 03, PAGE 72

THE PURPOSE OF THIS MONUMENT TIE MAP IS TO RE-ESTABLISH THE PREVIOUSLY ACCEPTED MONUMENTS LOST DUE TO HUNTRIDGE PHASE 6 CONSTRUCTION ACTIVITIES, UNLESS NOTED OTHERWISE.

ANY SUBSEQUENT CHANGES TO THIS MAP
SHOULD BE EXAMINED AND MAY BE DETERMINED
BY REFERENCE TO THE COUNTY RECORDER'S
CUMULATIVE MAP INDEX. N.R.S. 278.5695

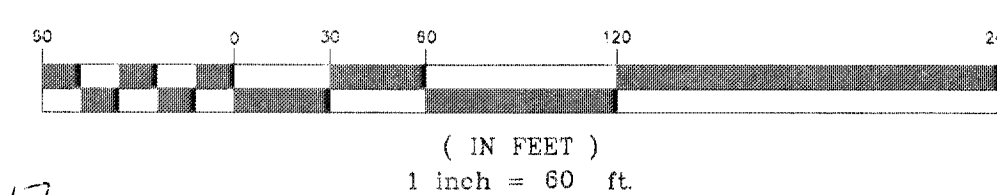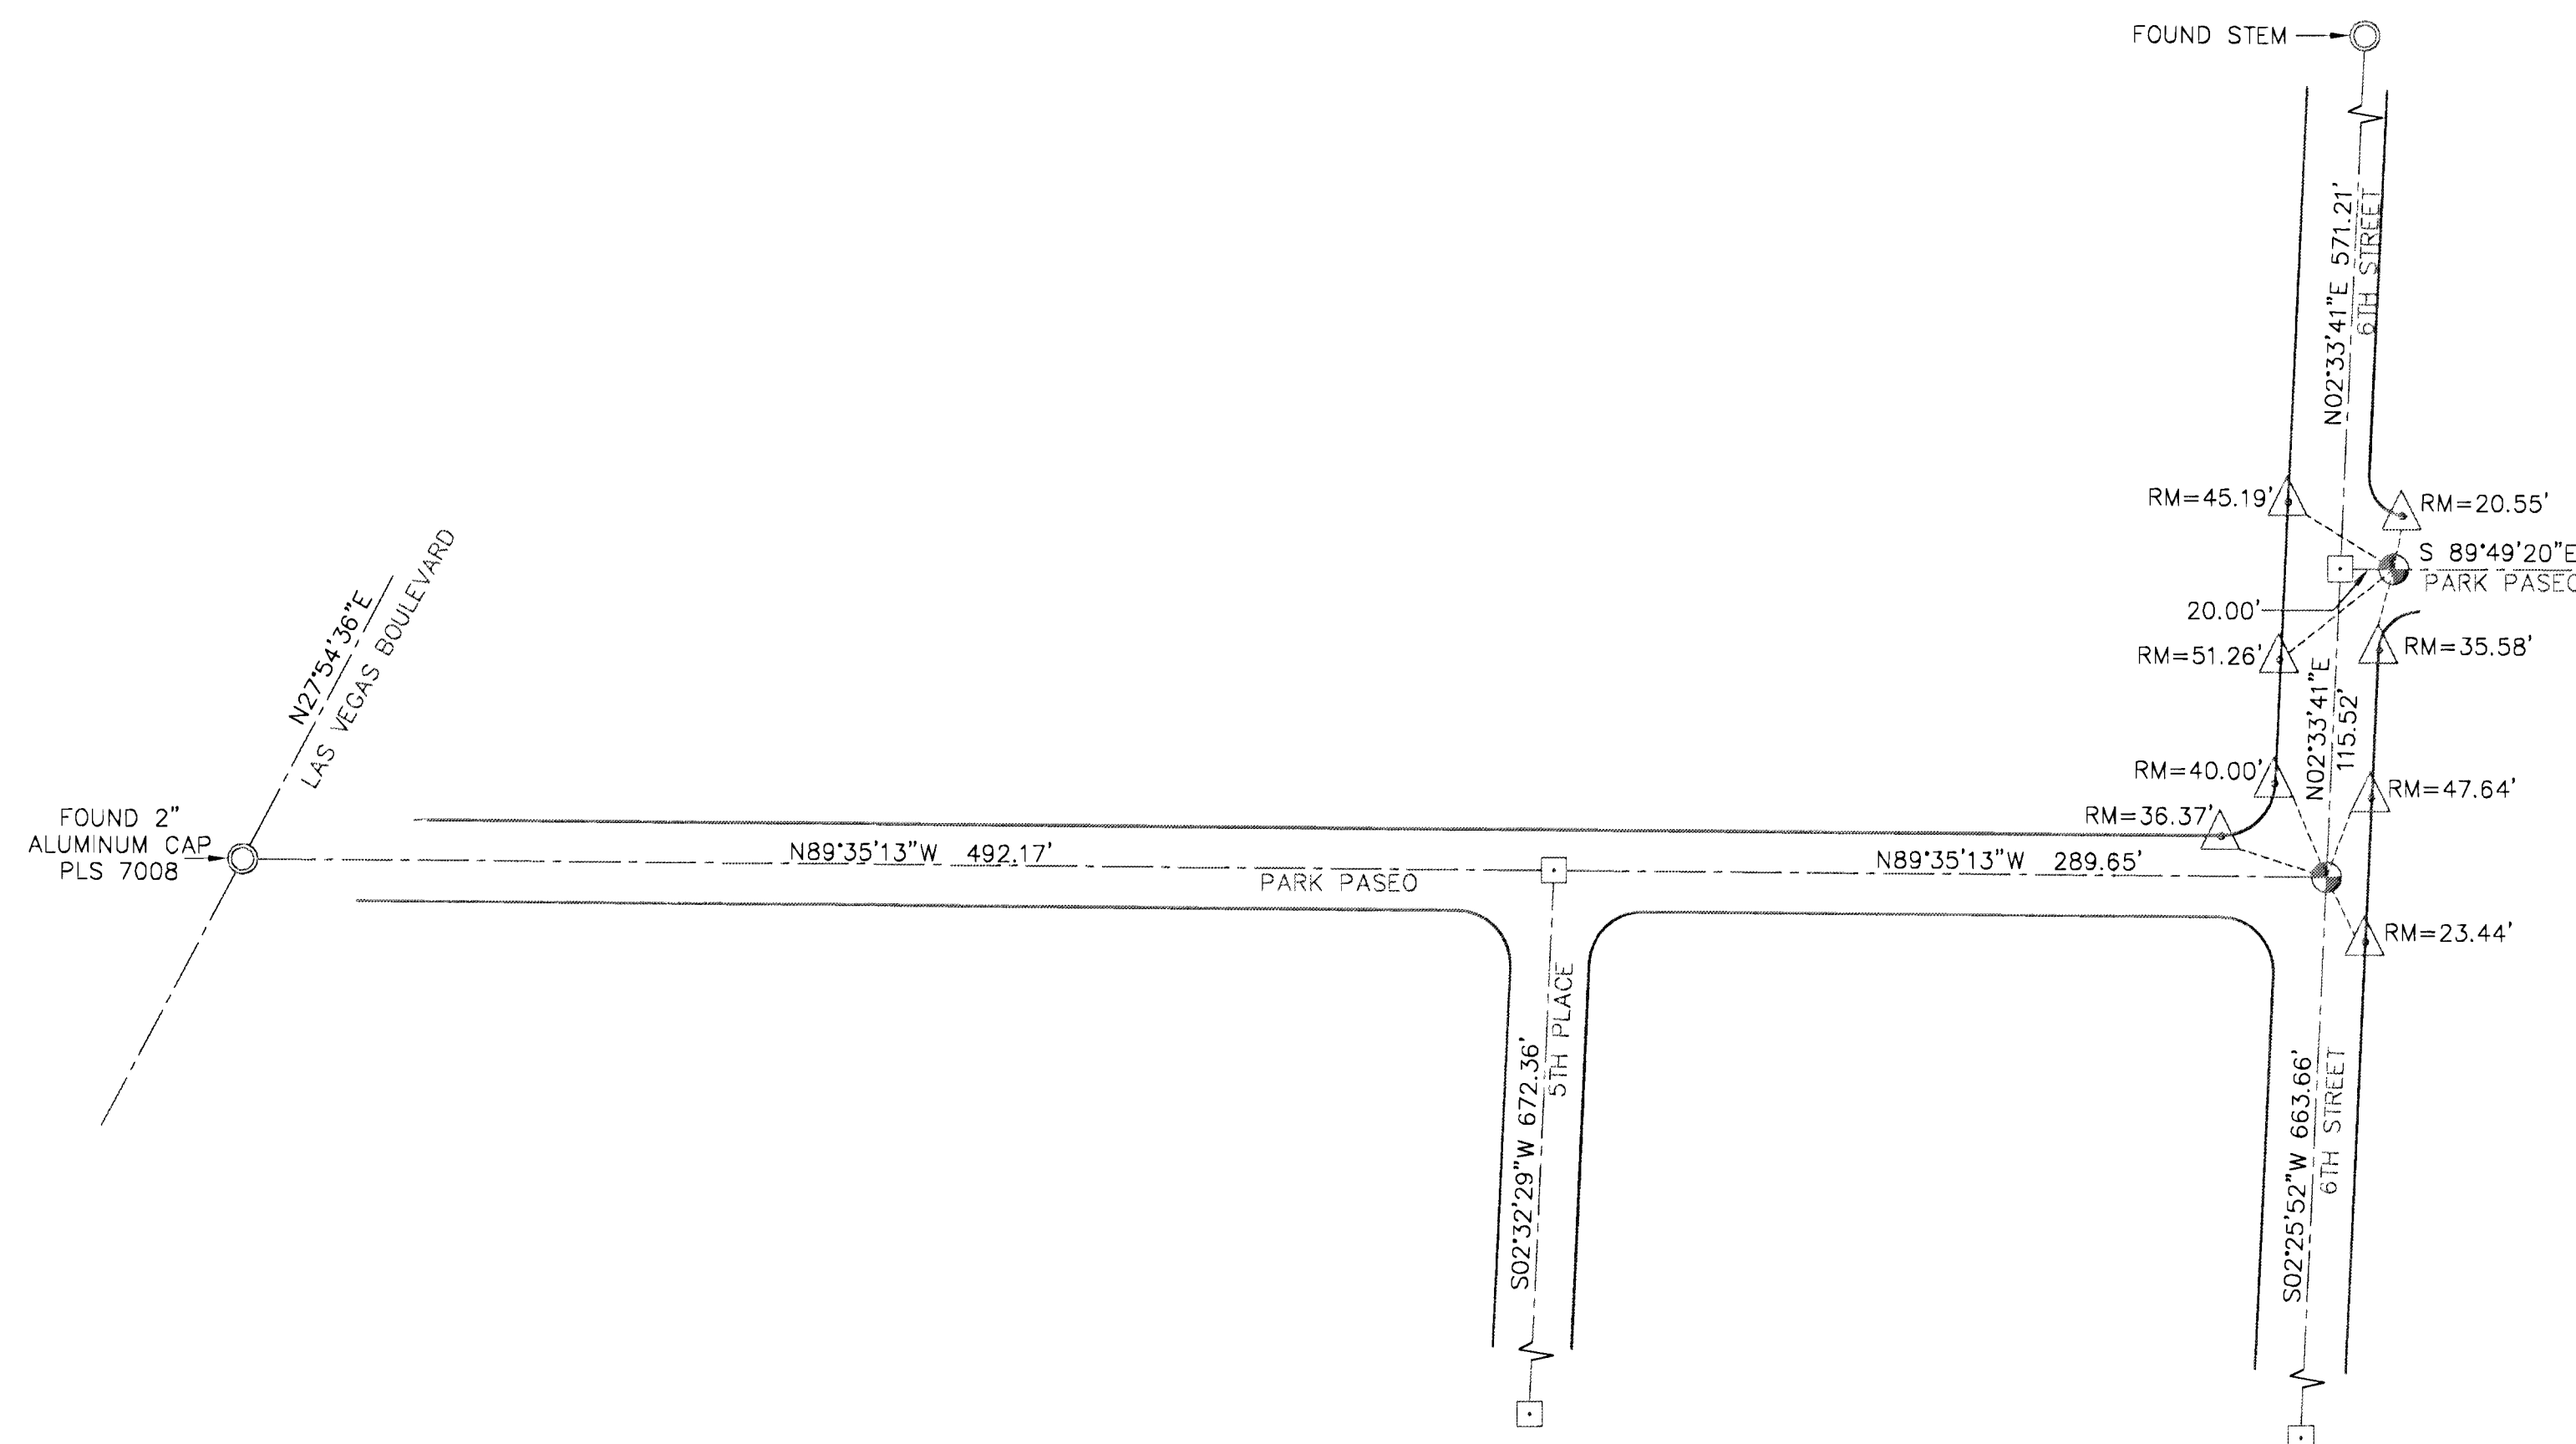

	CURB LINE
	CENTERLINE / CONTROL LINE
	SURVEY TIES
	FOUND MONUMENT AS DESCRIBED
	NOTHING FOUND, NOTHING SET POSITION CALCULATED
	SET 1 1/2-INCH ALUMINUM CAP STAMPED PLS 17460"
	SET RM 2-INCH ALUMINUM CAP

PROJECT NO.: 11-0067C
DRAFTED BY: RGW

BEING A PORTION OF
SECTION 3,
TOWNSHIP 21 SOUTH, RANGE 61 EAST,
MOUNT DIABLO MERIDIAN, CLARK COUNTY, NEVADA

4186 YAKIMA AVE.
LAS VEGAS, NV 89121
(702) 327-7137

SHEET 4
OF 4

NO. _____
 FILED AT THE REQUEST OF _____
 CCR PRECISION SURVEYING, LLC _____
 DATE _____ AT _____ M.
 FILE _____ PAGE _____
 OF SURVEYS
 OFFICIAL RECORDS BOOK NO. _____
 CLARK COUNTY, NEVADA RECORDS.
 DEBBIE CONWAY, RECORDER
 FEE \$ _____ DEPUTY _____

055-765