


# MONUMENT TIE MAP

## SUMMERLIN VILLAGE 23A PARCEL L - ANDALUSIA

AS SHOWN BY MAP THEREOF ON FILE IN THE CLARK COUNTY RECORDER'S OFFICE IN BOOK 143, PAGE 24 OF PLATS., LYING WITHIN SECTION 34, TOWNSHIP 20 SOUTH, RANGE 59 EAST, M.D.M., CITY OF LAS VEGAS, CLARK COUNTY, NEVADA

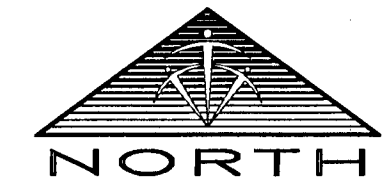

GRAPHIC SCALE



( IN FEET )  
1 inch = 40 ft.

### LEGEND


- STREET CENTER LINE
- SECTION LINE
- BOUNDARY LINE
- REFERENCE MONUMENT DISTANCE
- FOUND MONUMENT AS DESCRIBED
- FOUND TYPE IV-A REFERENCE MONUMENT STAMPED "PLS 14420"
- FOUND TYPE III MONUMENT STAMPED "PLS 14420"
- SET TYPE IV-A REFERENCE MONUMENT STAMPED "PLS 17449"

| LINE TABLE |             |        |
|------------|-------------|--------|
| LINE       | BEARING     | LENGTH |
| L1         | N17°39'19"E | 64.79  |
| L2         | S85°54'24"W | 51.01  |
| L3         | N72°34'47"E | 24.45  |
| L4         | S03°40'10"W | 21.00  |
| L5         | S04°16'33"E | 37.91  |

| CURVE TABLE |            |         |        |         |
|-------------|------------|---------|--------|---------|
| CURVE       | DELTA      | RADIUS  | LENGTH | TANGENT |
| C1          | 18°33'25"  | 1150.00 | 372.46 | 187.88  |
| C2          | 12°55'32"  | 500.00  | 112.80 | 56.64   |
| C3          | 5°49'37"   | 500.00  | 50.85  | 25.45   |
| C4          | 105°55'17" | 49.50   | 91.51  | 65.60   |
| C5          | 2°54'24"   | 1000.00 | 50.73  | 25.37   |
| C6          | 10°25'13"  | 1000.00 | 181.87 | 91.19   |
| C7          | 61°22'47"  | 64.50   | 69.10  | 38.28   |
| C8          | 2°40'01"   | 2700.00 | 125.68 | 62.85   |
| C9          | 9°27'45"   | 300.00  | 49.55  | 24.83   |
| C10         | 31°3'20"   | 1000.00 | 56.24  | 28.13   |
| C11         | 12°48'32"  | 500.00  | 111.78 | 56.12   |
| C12         | 90°00'00"  | 49.50   | 77.75  | 49.50   |
| C13         | 9°57'11"   | 2000.00 | 347.42 | 174.15  |
| C14         | 82°00'32"  | 49.50   | 70.85  | 43.04   |
| C15         | 8°35'17"   | 500.00  | 74.94  | 37.54   |
| C16         | 17°31'35"  | 500.00  | 152.95 | 77.08   |
| C18         | 5°42'33"   | 500.00  | 49.82  | 24.93   |
| C19         | 7°12'59"   | 500.00  | 62.97  | 31.53   |

### SURVEYOR'S CERTIFICATE

I, ROBERT J. FOLEY, A PROFESSIONAL LAND SURVEYOR LICENSED IN THE STATE OF NEVADA DO HEREBY CERTIFY THAT THE MONUMENTS DEPICTED ON THIS PLAT ARE OF THE CHARACTER SHOWN, OCCUPY THE POSITIONS INDICATED, ARE OF SUFFICIENT DURABILITY AND THE TIE DISTANCES ESTABLISHED ARE AS SHOWN HEREON. THIS SURVEY WAS COMPLETED ON NOVEMBER 20, 2013.

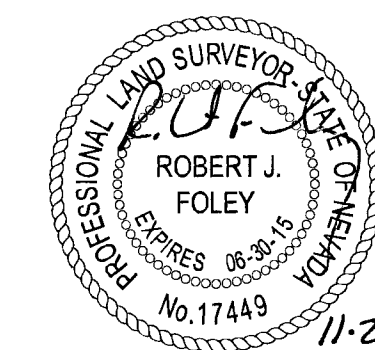


ROBERT J. FOLEY  
PROFESSIONAL LAND SURVEYOR  
NEVADA LICENSE NO. 17449

### MAP REFERENCES

BOOK 121 PAGE 12 OF PLATS  
BOOK 143 PAGE 24 OF PLATS


PERMIT# CLV-40301  
BOOK 143, PAGE 24 OF PLATS  
FMP-40443

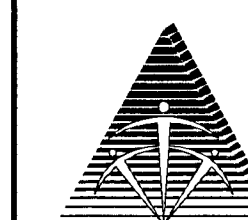

TRI-CORE  
SURVEYING, LLC

6761 WEST CHARLESTON BLVD.  
LAS VEGAS, NEVADA 89146  
TEL. (702) 821-1554 FAX (702) 870-4378

058-4975  
SHEET 1 OF 4

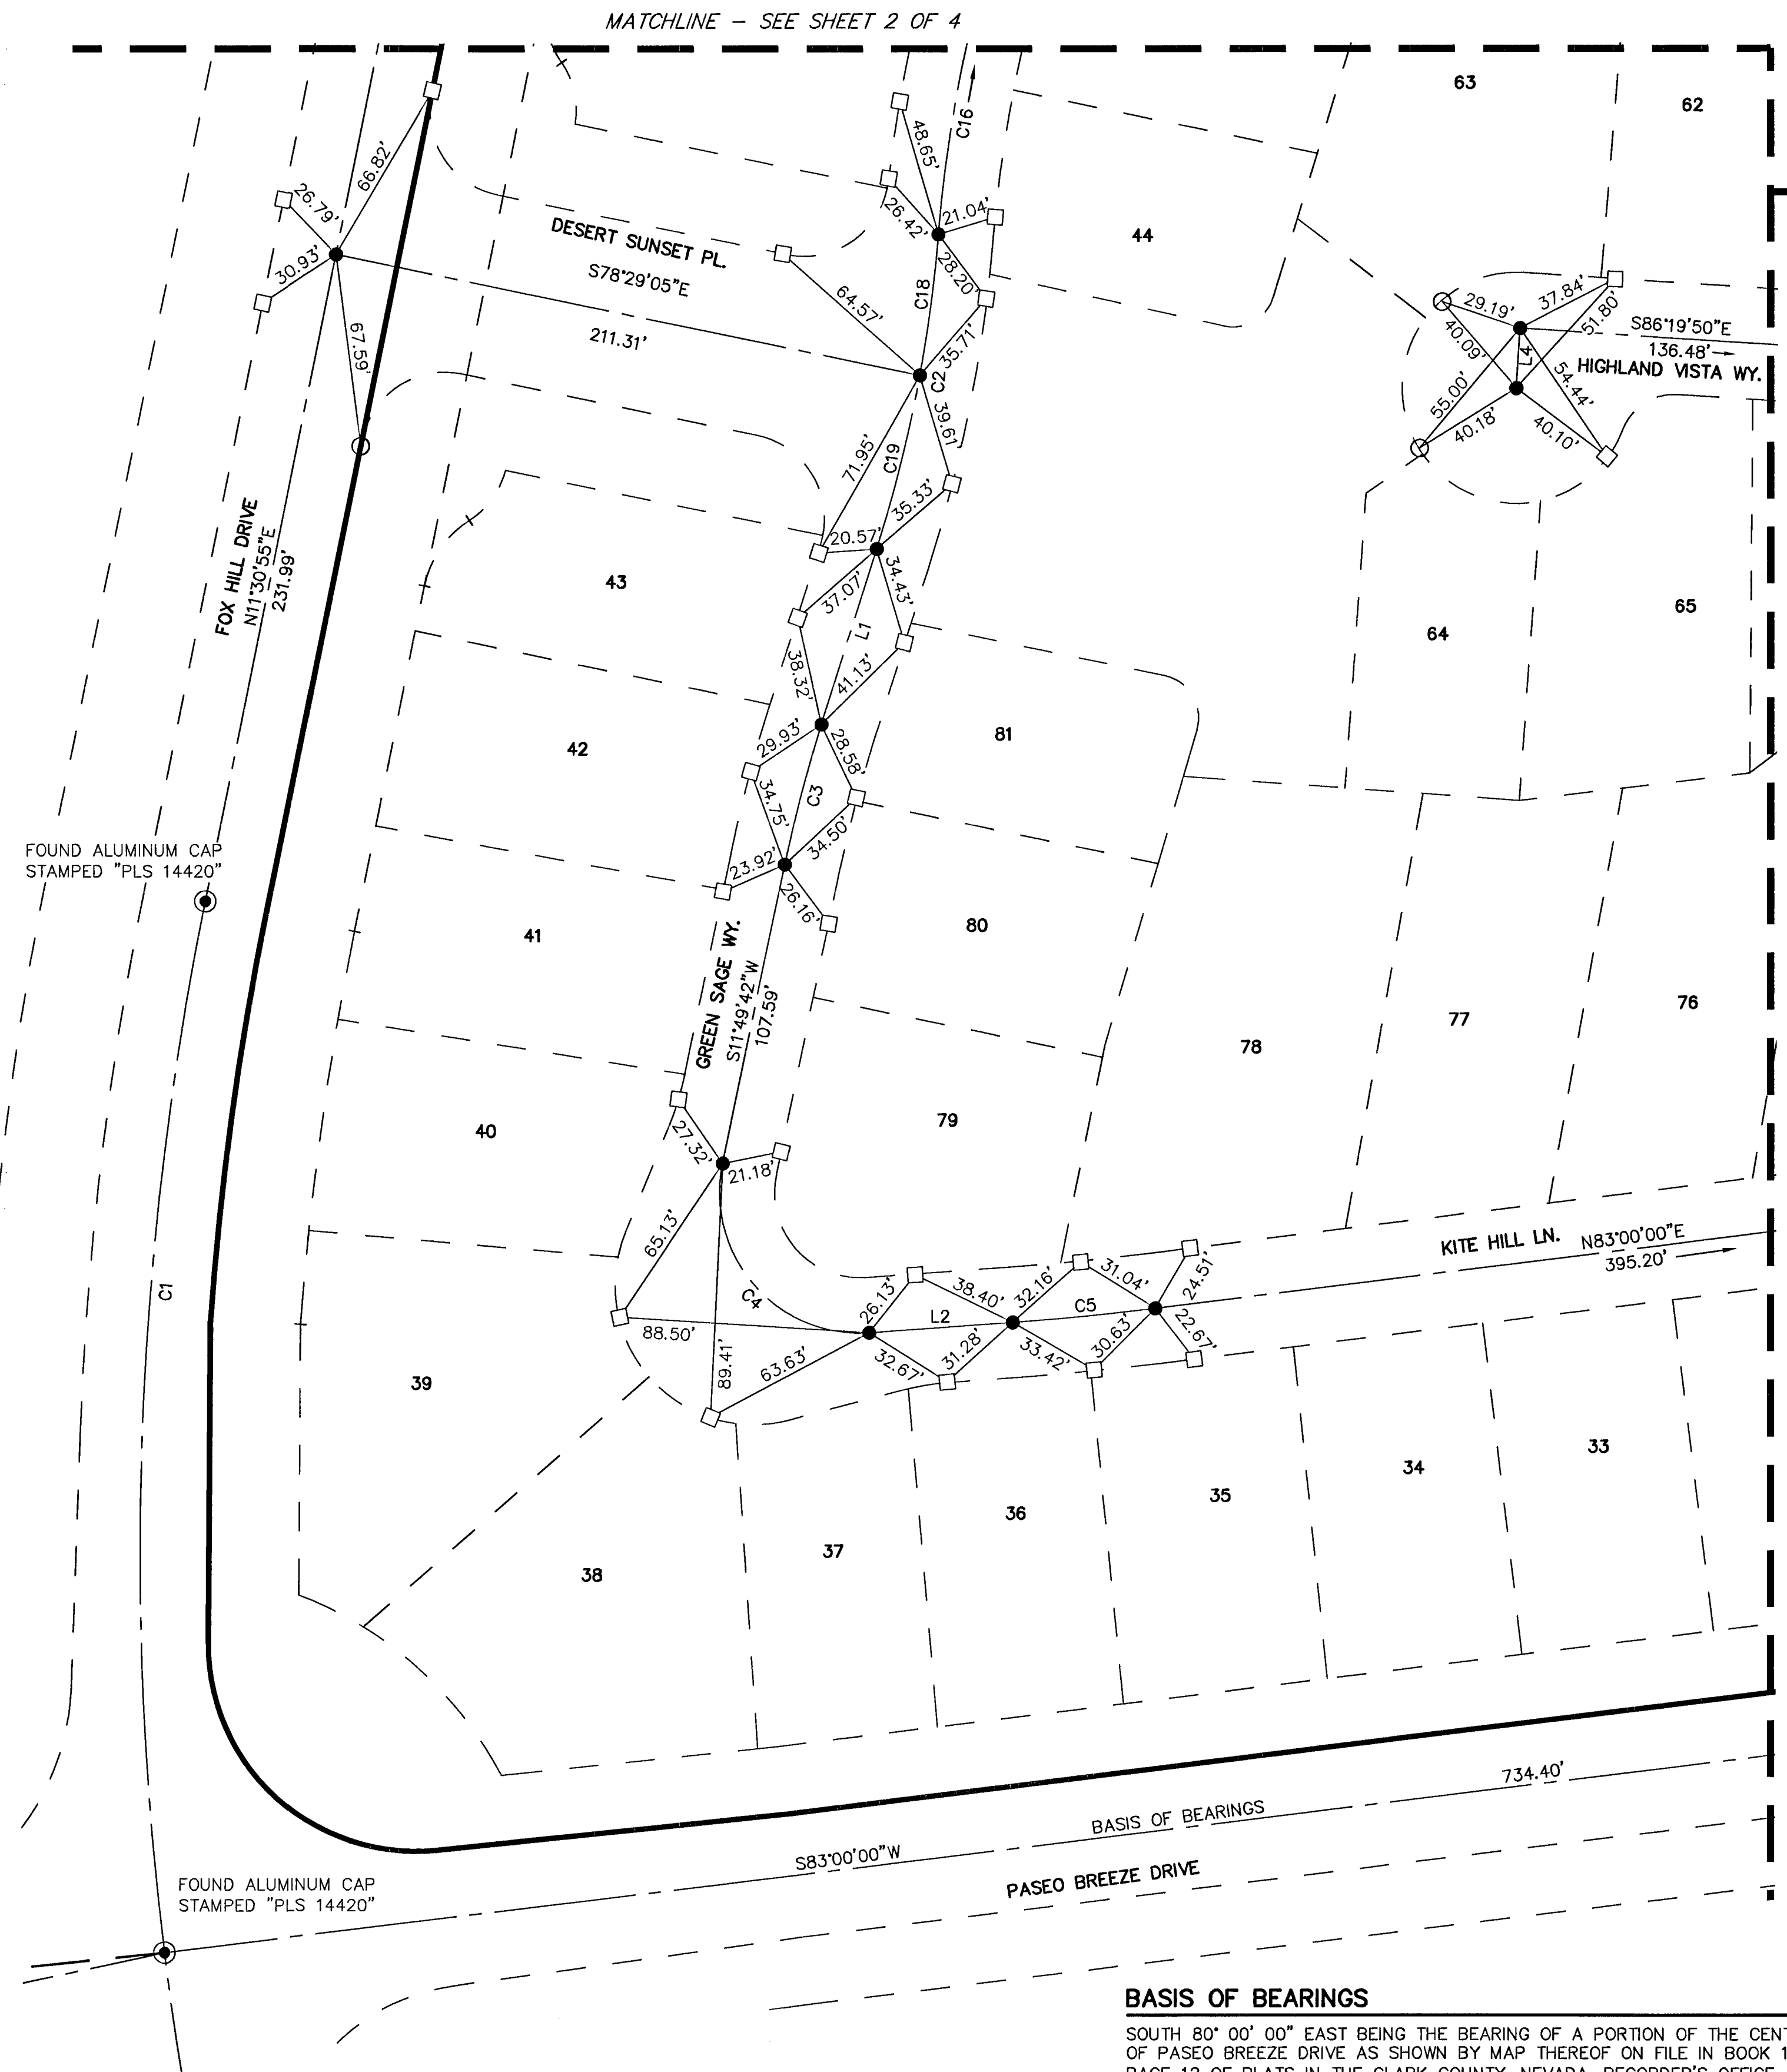

### BASIS OF BEARINGS

SOUTH 80° 00' 00" EAST BEING THE BEARING OF A PORTION OF THE CENTERLINE OF PASEO BREEZE DRIVE AS SHOWN BY MAP THEREOF ON FILE IN BOOK 121, PAGE 12 OF PLATS IN THE CLARK COUNTY, NEVADA, RECORDER'S OFFICE.