
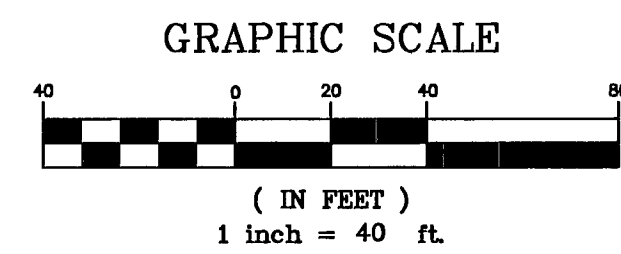


MONUMENT TIE MAP

SUMMERLIN VILLAGE 23A PARCEL L - ANDALUSIA

AS SHOWN BY MAP THEREOF ON FILE IN THE CLARK COUNTY RECORDER'S OFFICE IN BOOK 143, PAGE 24 OF PLATS. , LYING WITHIN SECTION 34, TOWNSHIP 20 SOUTH, RANGE 59 EAST, M.D.M., CITY OF LAS VEGAS, CLARK COUNTY, NEVADA

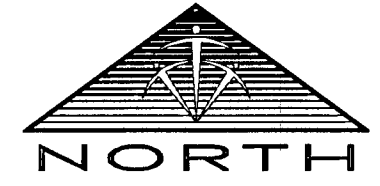

LEGEND


- STREET CENTER LINE
- - - SECTION LINE
- BOUNDARY LINE
- REFERENCE MONUMENT DISTANCE
- FOUND MONUMENT AS DESCRIBED
- FOUND TYPE IV-A REFERENCE MONUMENT STAMPED "PLS 14420"
- FOUND TYPE III MONUMENT STAMPED "PLS 14420"
- SET TYPE IV-A REFERENCE MONUMENT STAMPED "PLS 17449"

LINE TABLE		
LINE	BEARING	LENGTH
L1	N17°39'19"E	64.79
L2	S85°54'24"W	51.01
L3	N72°34'47"E	24.45
L4	S03°40'10"W	21.00
L5	S04°16'33"E	37.91

CURVE TABLE				
CURVE	DELTA	RADIUS	LENGTH	TANGENT
C1	18°33'25"	1150.00	372.46	187.88
C2	12°55'32"	500.00	112.80	56.64
C3	5°49'37"	500.00	50.85	25.45
C4	105°55'17"	49.50	91.51	65.60
C5	2°54'24"	1000.00	50.73	25.37
C6	10°25'13"	1000.00	181.87	91.19
C7	61°22'47"	64.50	69.10	38.28
C8	2°40'01"	2700.00	125.68	62.85
C9	9°27'45"	300.00	49.55	24.83
C10	3°13'20"	1000.00	56.24	28.13
C11	12°48'32"	500.00	111.78	56.12
C12	90°00'00"	49.50	77.75	49.50
C13	9°57'11"	2000.00	347.42	174.15
C14	82°00'32"	49.50	70.85	43.04
C15	8°35'17"	500.00	74.94	37.54
C16	17°31'35"	500.00	152.95	77.08
C18	5°42'33"	500.00	49.82	24.93
C19	7°12'59"	500.00	62.97	31.53

MATCHLINE - SEE SHEET 2 OF 4



MATCHLINE - SEE SHEET 4 OF 4

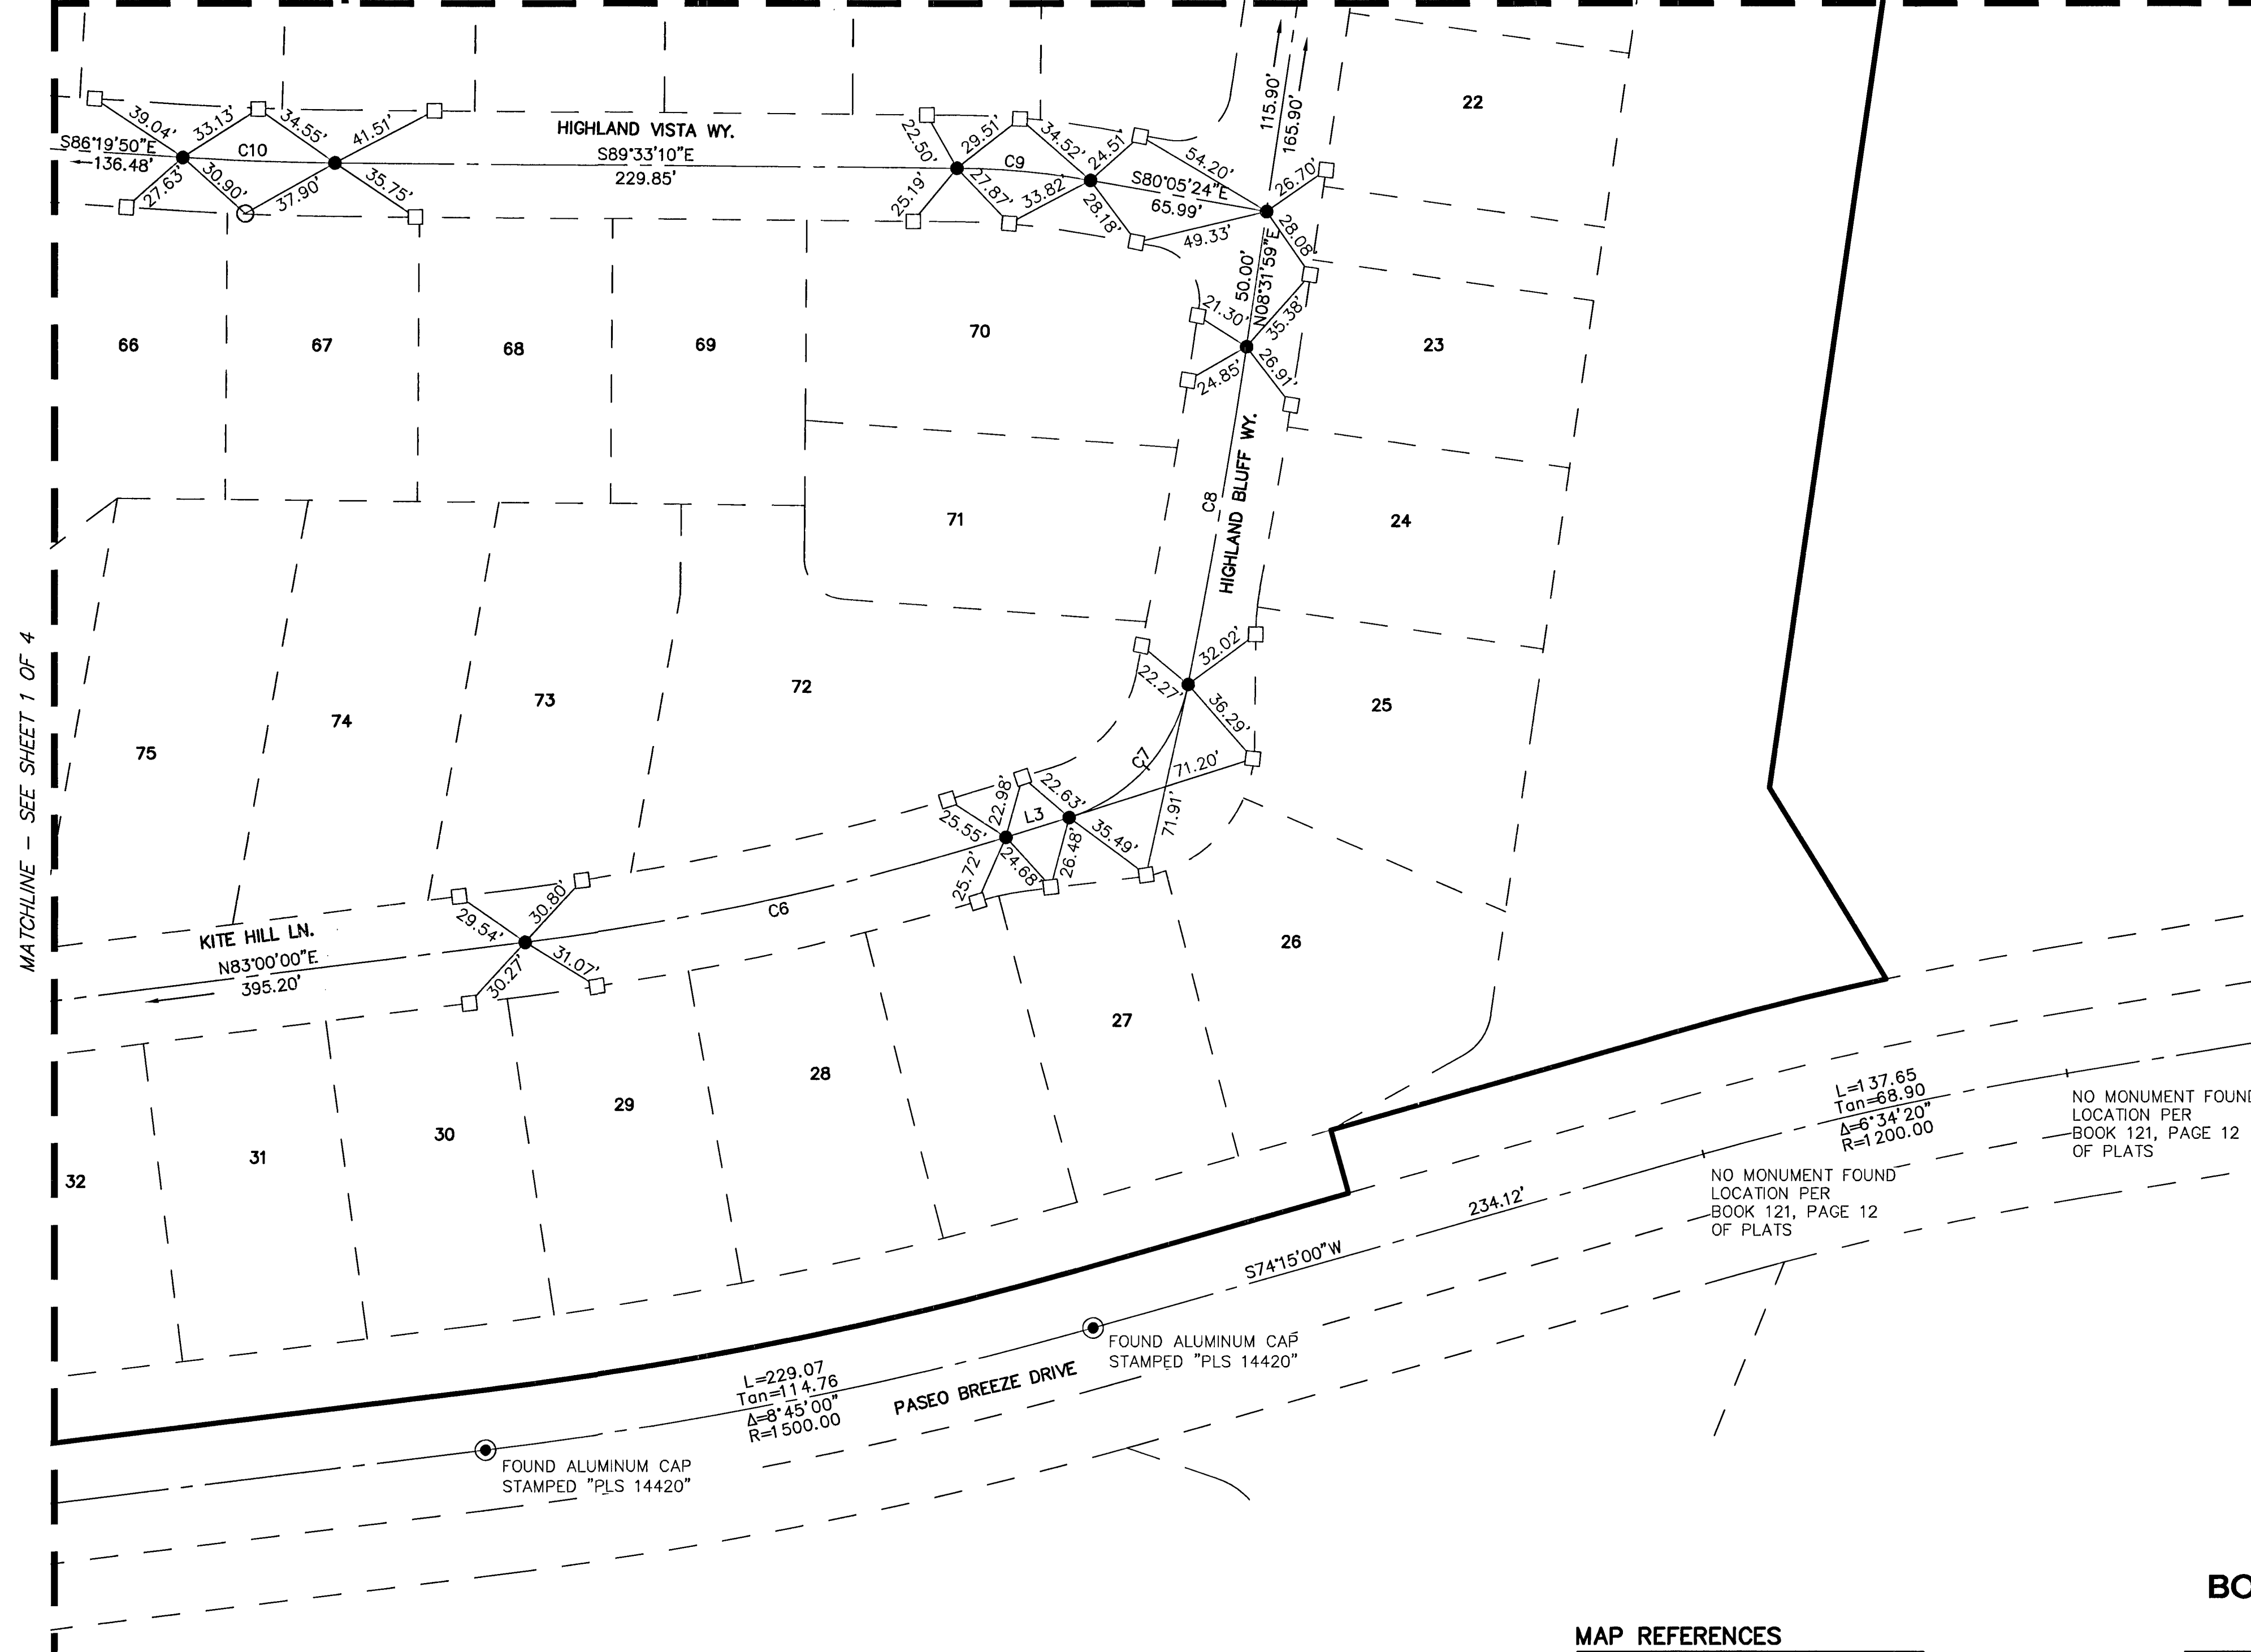

MAP REFERENCES

BOOK 121 PAGE 12 OF PLATS
BOOK 143 PAGE 24 OF PLATS

PERMIT# CLV-40301
BOOK 143, PAGE 24 OF PLATS
FMP-40443

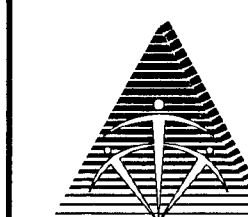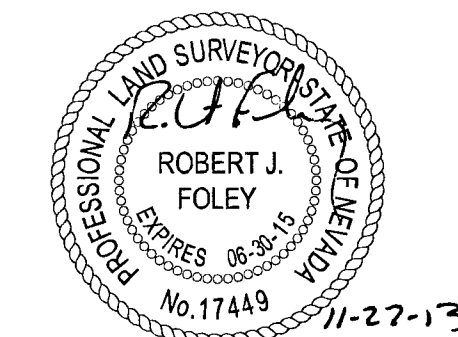

Tri-CORE
SURVEYING, LLC
6761 WEST CHARLESTON BLVD.
LAS VEGAS, NEVADA 89146
TEL. (702) 821-1554 FAX (702) 870-4378

058-4975
SHEET 3 OF 4