


MONUMENT TIE MAP

SUMMERLIN VILLAGE 23A PARCEL L - ANDALUSIA

AS SHOWN BY MAP THEREOF ON FILE IN THE CLARK COUNTY RECORDER'S OFFICE IN BOOK 143, PAGE 24 OF PLATS., LYING WITHIN SECTION 34, TOWNSHIP 20 SOUTH, RANGE 59 EAST, M.D.M., CITY OF LAS VEGAS, CLARK COUNTY, NEVADA

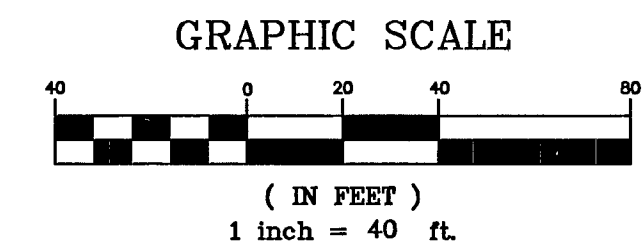


LEGEND


- STREET CENTER LINE
- SECTION LINE
- BOUNDARY LINE
- REFERENCE MONUMENT DISTANCE
- FOUND MONUMENT AS DESCRIBED
- FOUND TYPE IV-A REFERENCE MONUMENT STAMPED "PLS 14420"
- FOUND TYPE III MONUMENT STAMPED "PLS 14420"
- SET TYPE IV-A REFERENCE MONUMENT STAMPED "PLS 17449"

LINE TABLE		
LINE	BEARING	LENGTH
L1	N17°39'19"E	64.79
L2	S85°54'24"W	51.01
L3	N72°34'47"E	24.45
L4	S03°40'10"W	21.00
L5	S04°16'33"E	37.91

CURVE TABLE				
CURVE	DELTA	RADIUS	LENGTH	TANGENT
C1	18°33'25"	1150.00	372.46	187.88
C2	12°56'32"	500.00	112.80	56.64
C3	5°48'37"	500.00	50.85	25.45
C4	105°55'17"	49.50	91.51	65.60
C5	2°54'24"	1000.00	50.73	25.37
C6	10°25'13"	1000.00	181.87	91.19
C7	61°22'47"	64.50	69.10	38.28
C8	2°40'01"	2700.00	125.68	62.85
C9	9°27'45"	300.00	49.55	24.83
C10	3°13'20"	1000.00	56.24	28.13
C11	12°48'32"	500.00	111.78	56.12
C12	90°00'00"	49.50	77.75	49.50
C13	9°57'11"	2000.00	347.42	174.15
C14	82°00'32"	49.50	70.85	43.04
C15	8°35'17"	500.00	74.94	37.54
C16	17°31'35"	500.00	152.95	77.08
C18	5°42'33"	500.00	49.82	24.93
C19	7°12'59"	500.00	62.97	31.53

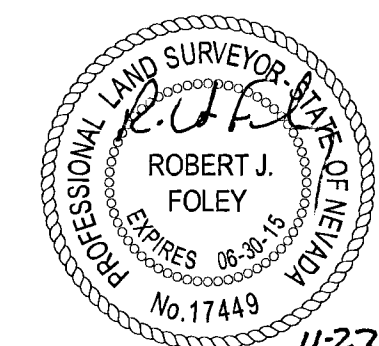

PERMIT# CLV-40301
BOOK 143, PAGE 24 OF PLATS
FMP-40443

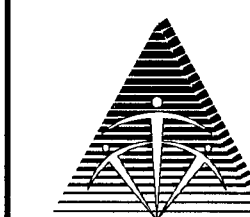

TRI-CORE
SURVEYING, LLC
6761 WEST CHARLESTON BLVD.
LAS VEGAS, NEVADA 89146
TEL. (702) 821-1554 FAX (702) 870-4378

058-4975
SHEET 4 OF 4

MAP REFERENCES

BOOK 121 PAGE 12 OF PLATS
BOOK 143 PAGE 24 OF PLATS

