




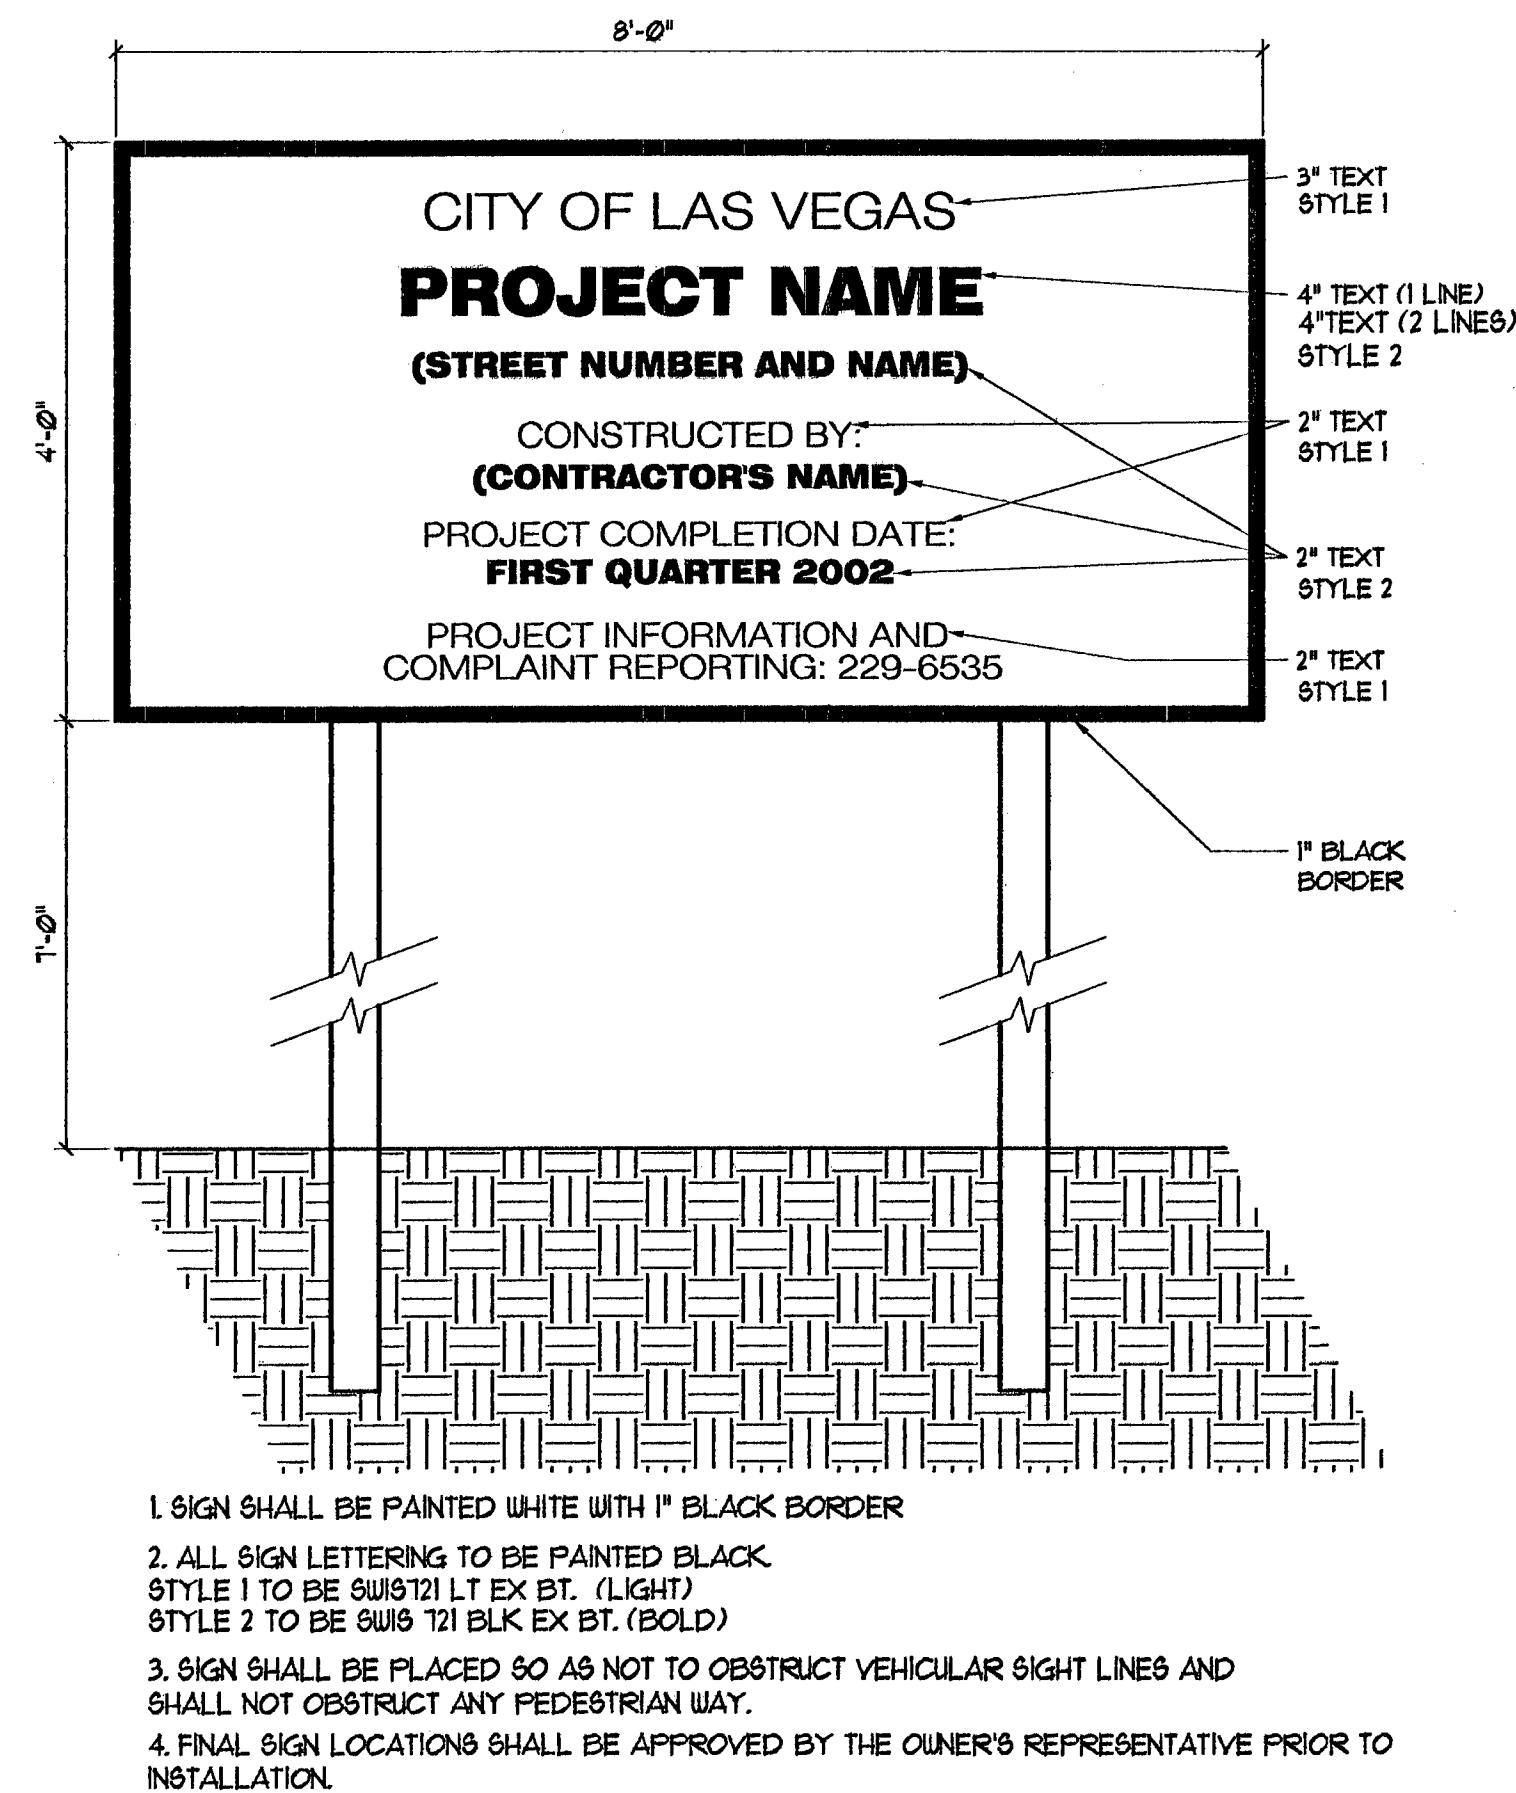

3 **PROJECT SIGN**
Scale: 3/4" = 1'-0"
ST01500-01

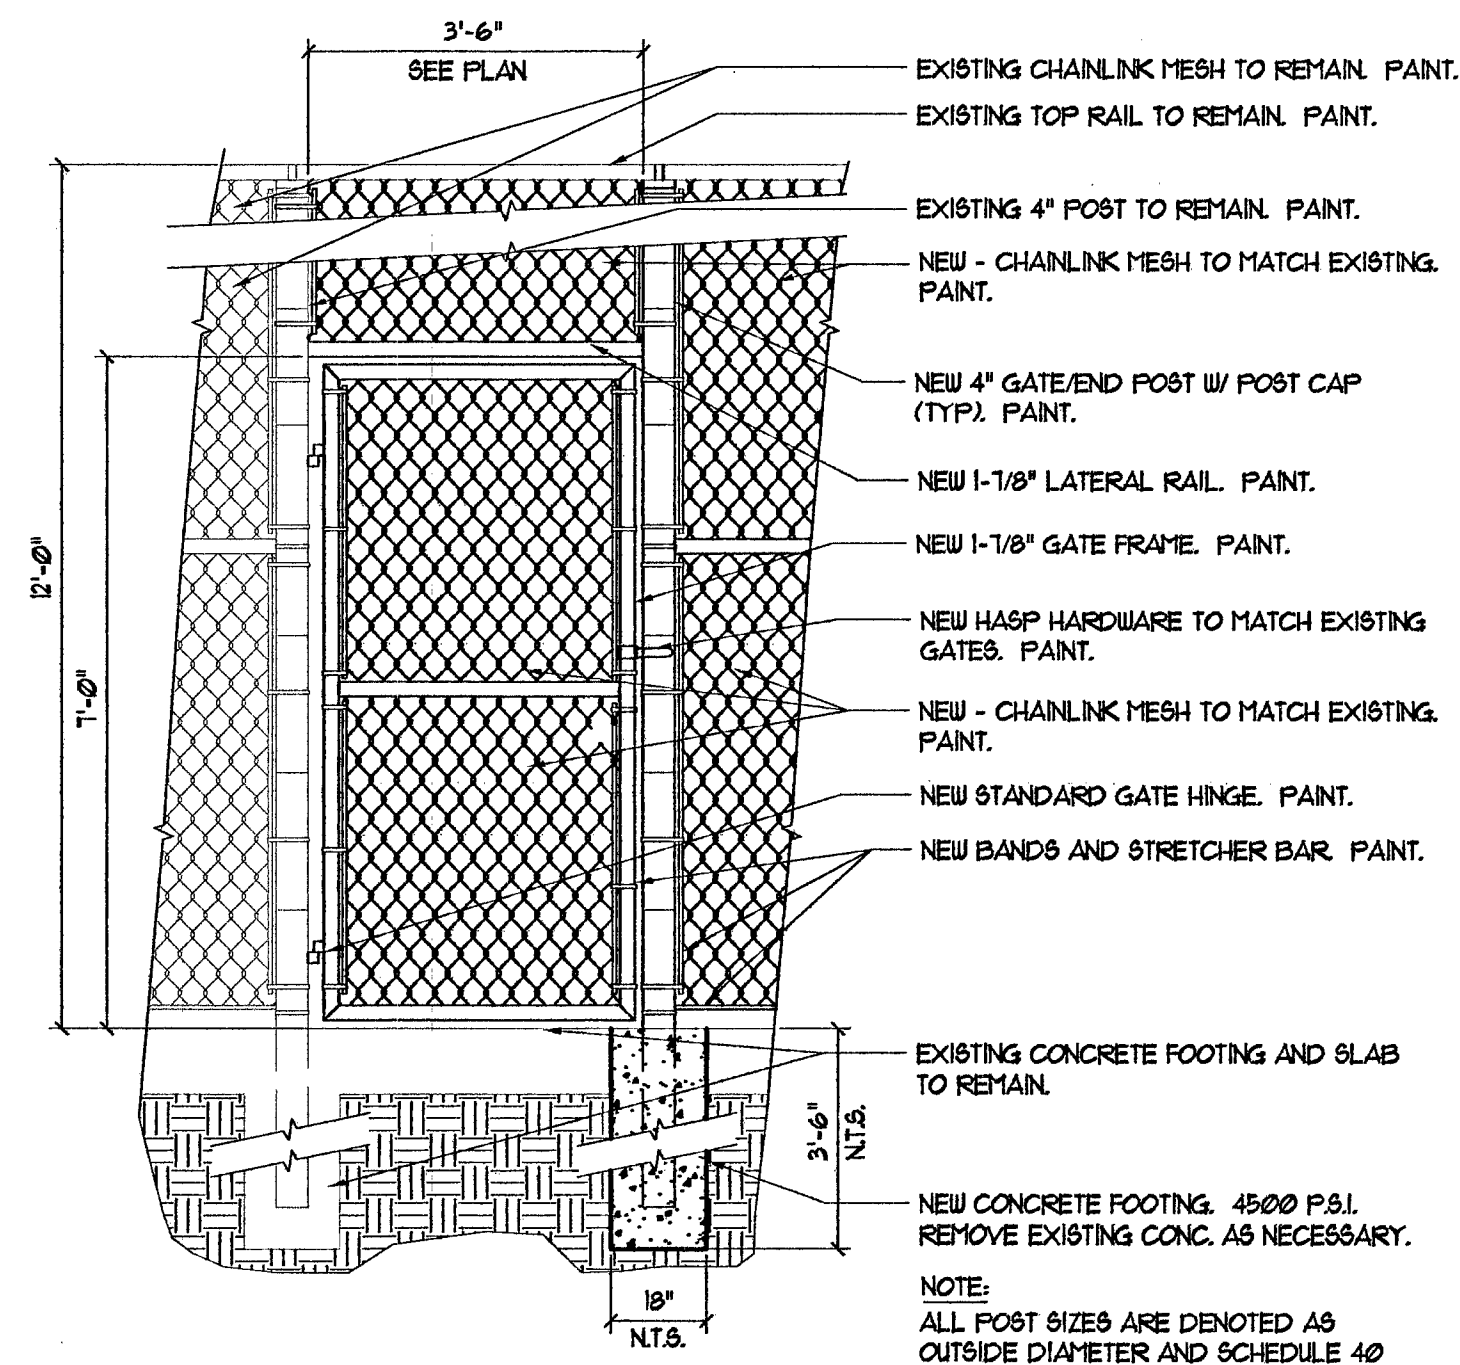


2 **Tennis Court Fence Gate Elevation**
Scale: 1/2" = 1'-0"
ST01202-42

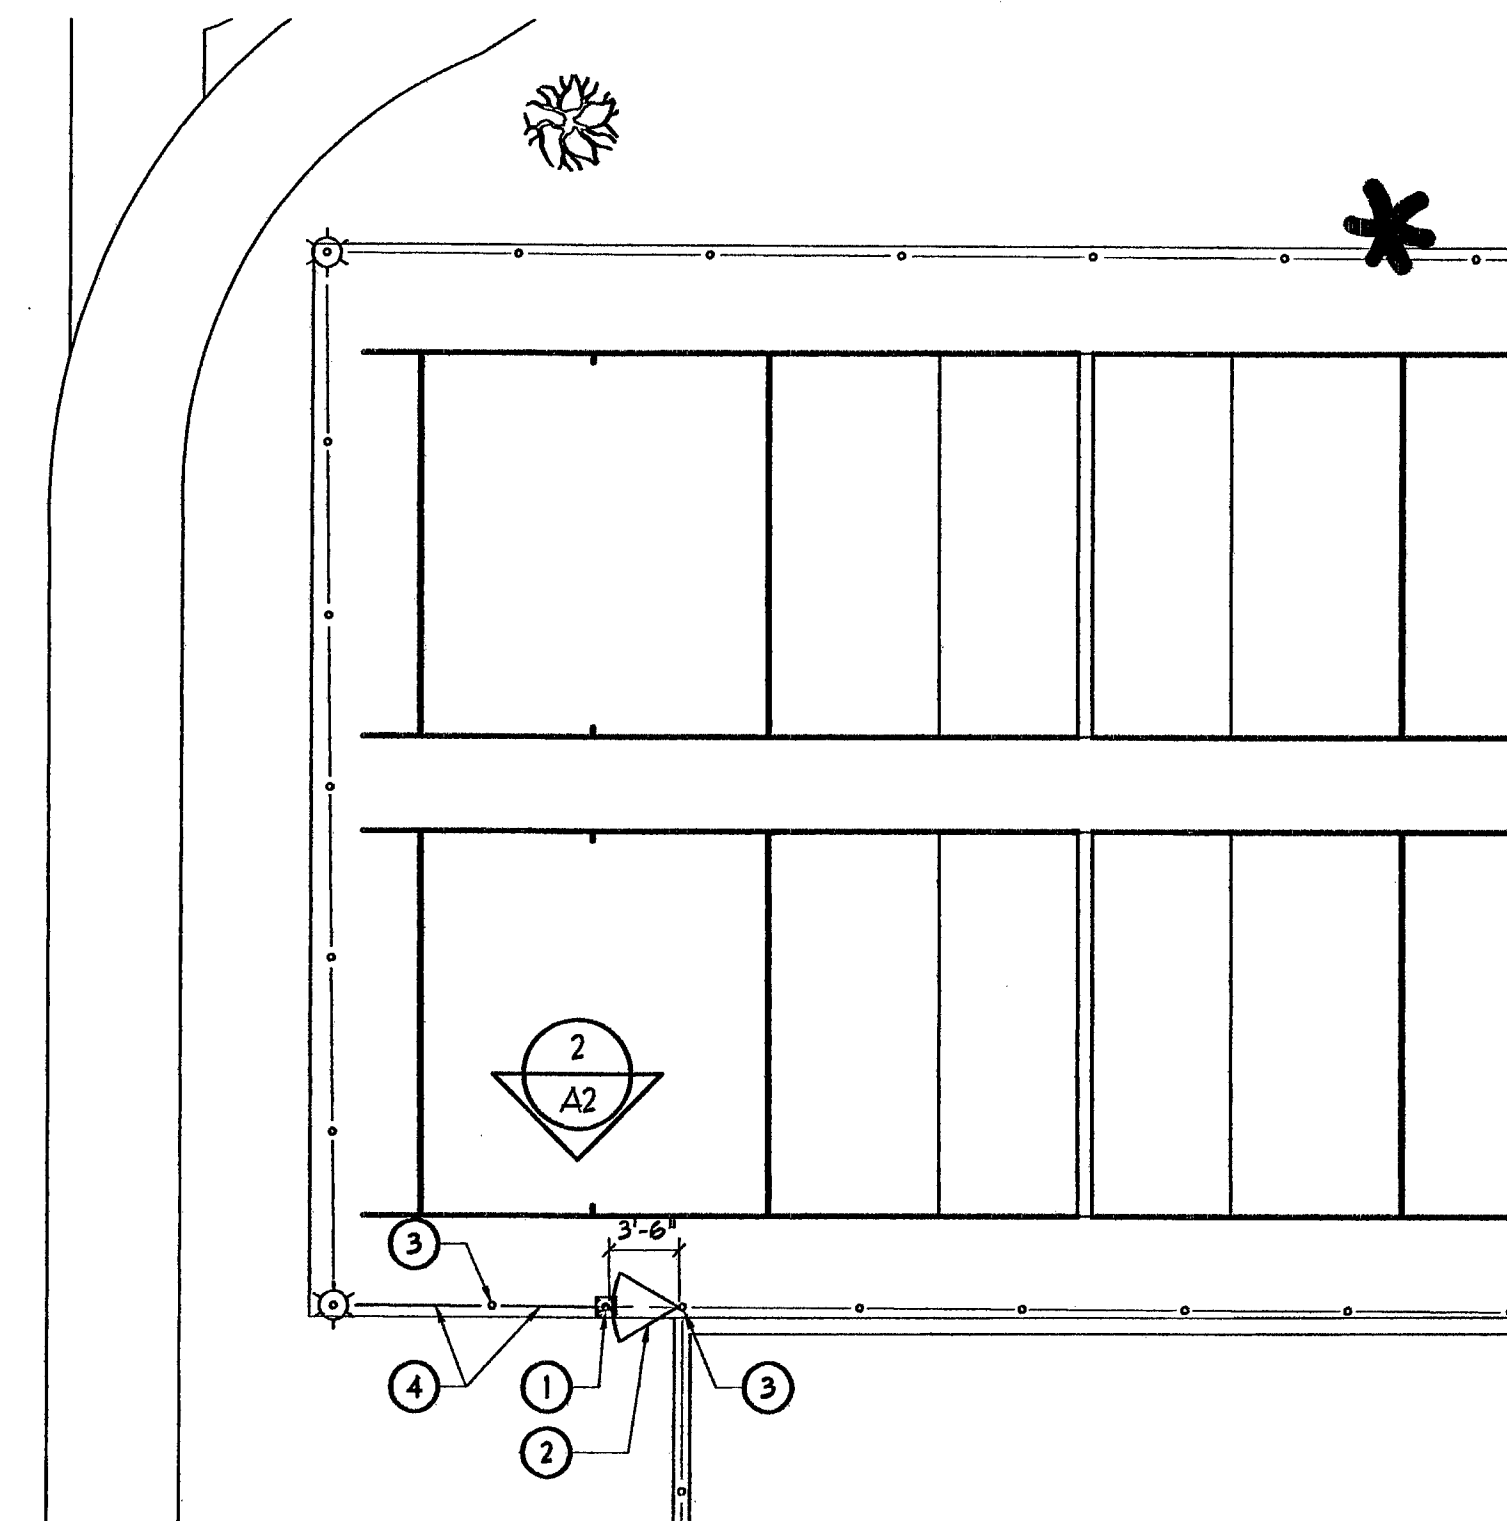

1 **Enlarged Plan of New Chain-link Fence and Gate**
Scale: 1" = 10'-0"

Key Notes:

1. SAW-CUT EXISTING CONCRETE SLAB AS REQUIRED FOR NEW CONCRETE FOOTING AND FENCE POST. REF. DETAIL 2/A2.
2. NEW GATE. REF. DETAIL 2/A2.
3. EXISTING FENCE POST TO REMAIN.
4. NEW CHAINLINK MESH. REF. SPECS.

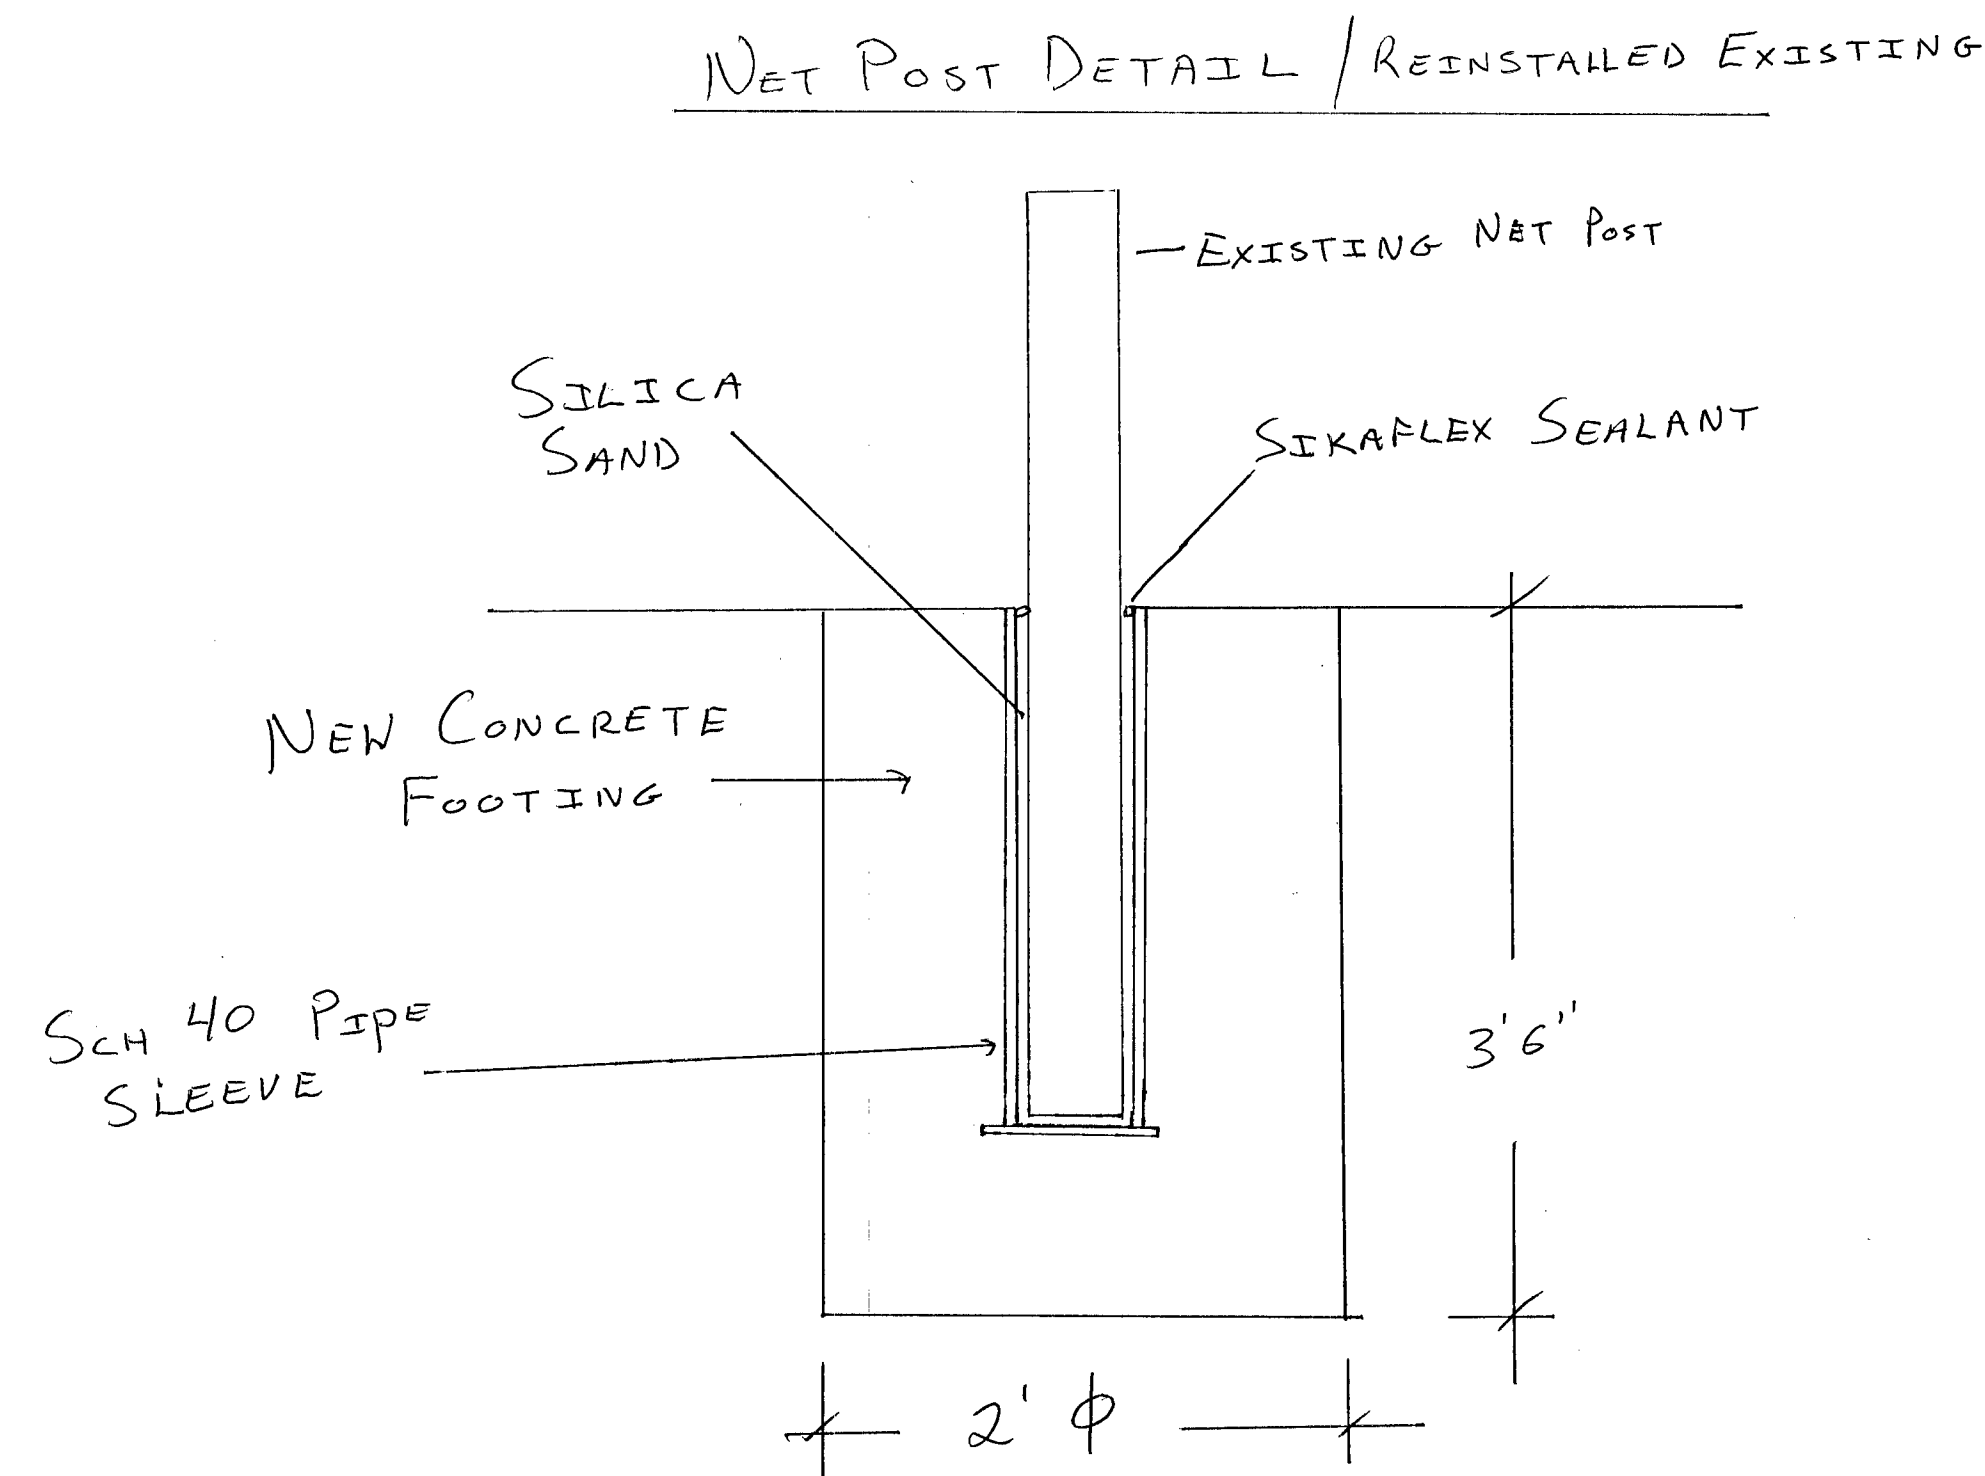

REVISIONS	DATE	BY	APP'D
CONSULTANT			

OWNER: CITY OF LAS VEGAS
DEPARTMENT OF PUBLIC WORKS
ARCHITECTURAL SERVICES

400 EAST STEWART AVENUE
LAS VEGAS, NEVADA 89101
PHONE: (702) 229-6535
FAX: (702) 384-4846
TDD: (702) 386-2108

DRAWN	bbreed
TITLE	btaraba2
DATE	10/23/01
SCALE	1" = 10'-0"
DWG NO	07.5341.11
CITY DWG NO	65027-5

SHEET NO	6056
	A2

6056 A2