


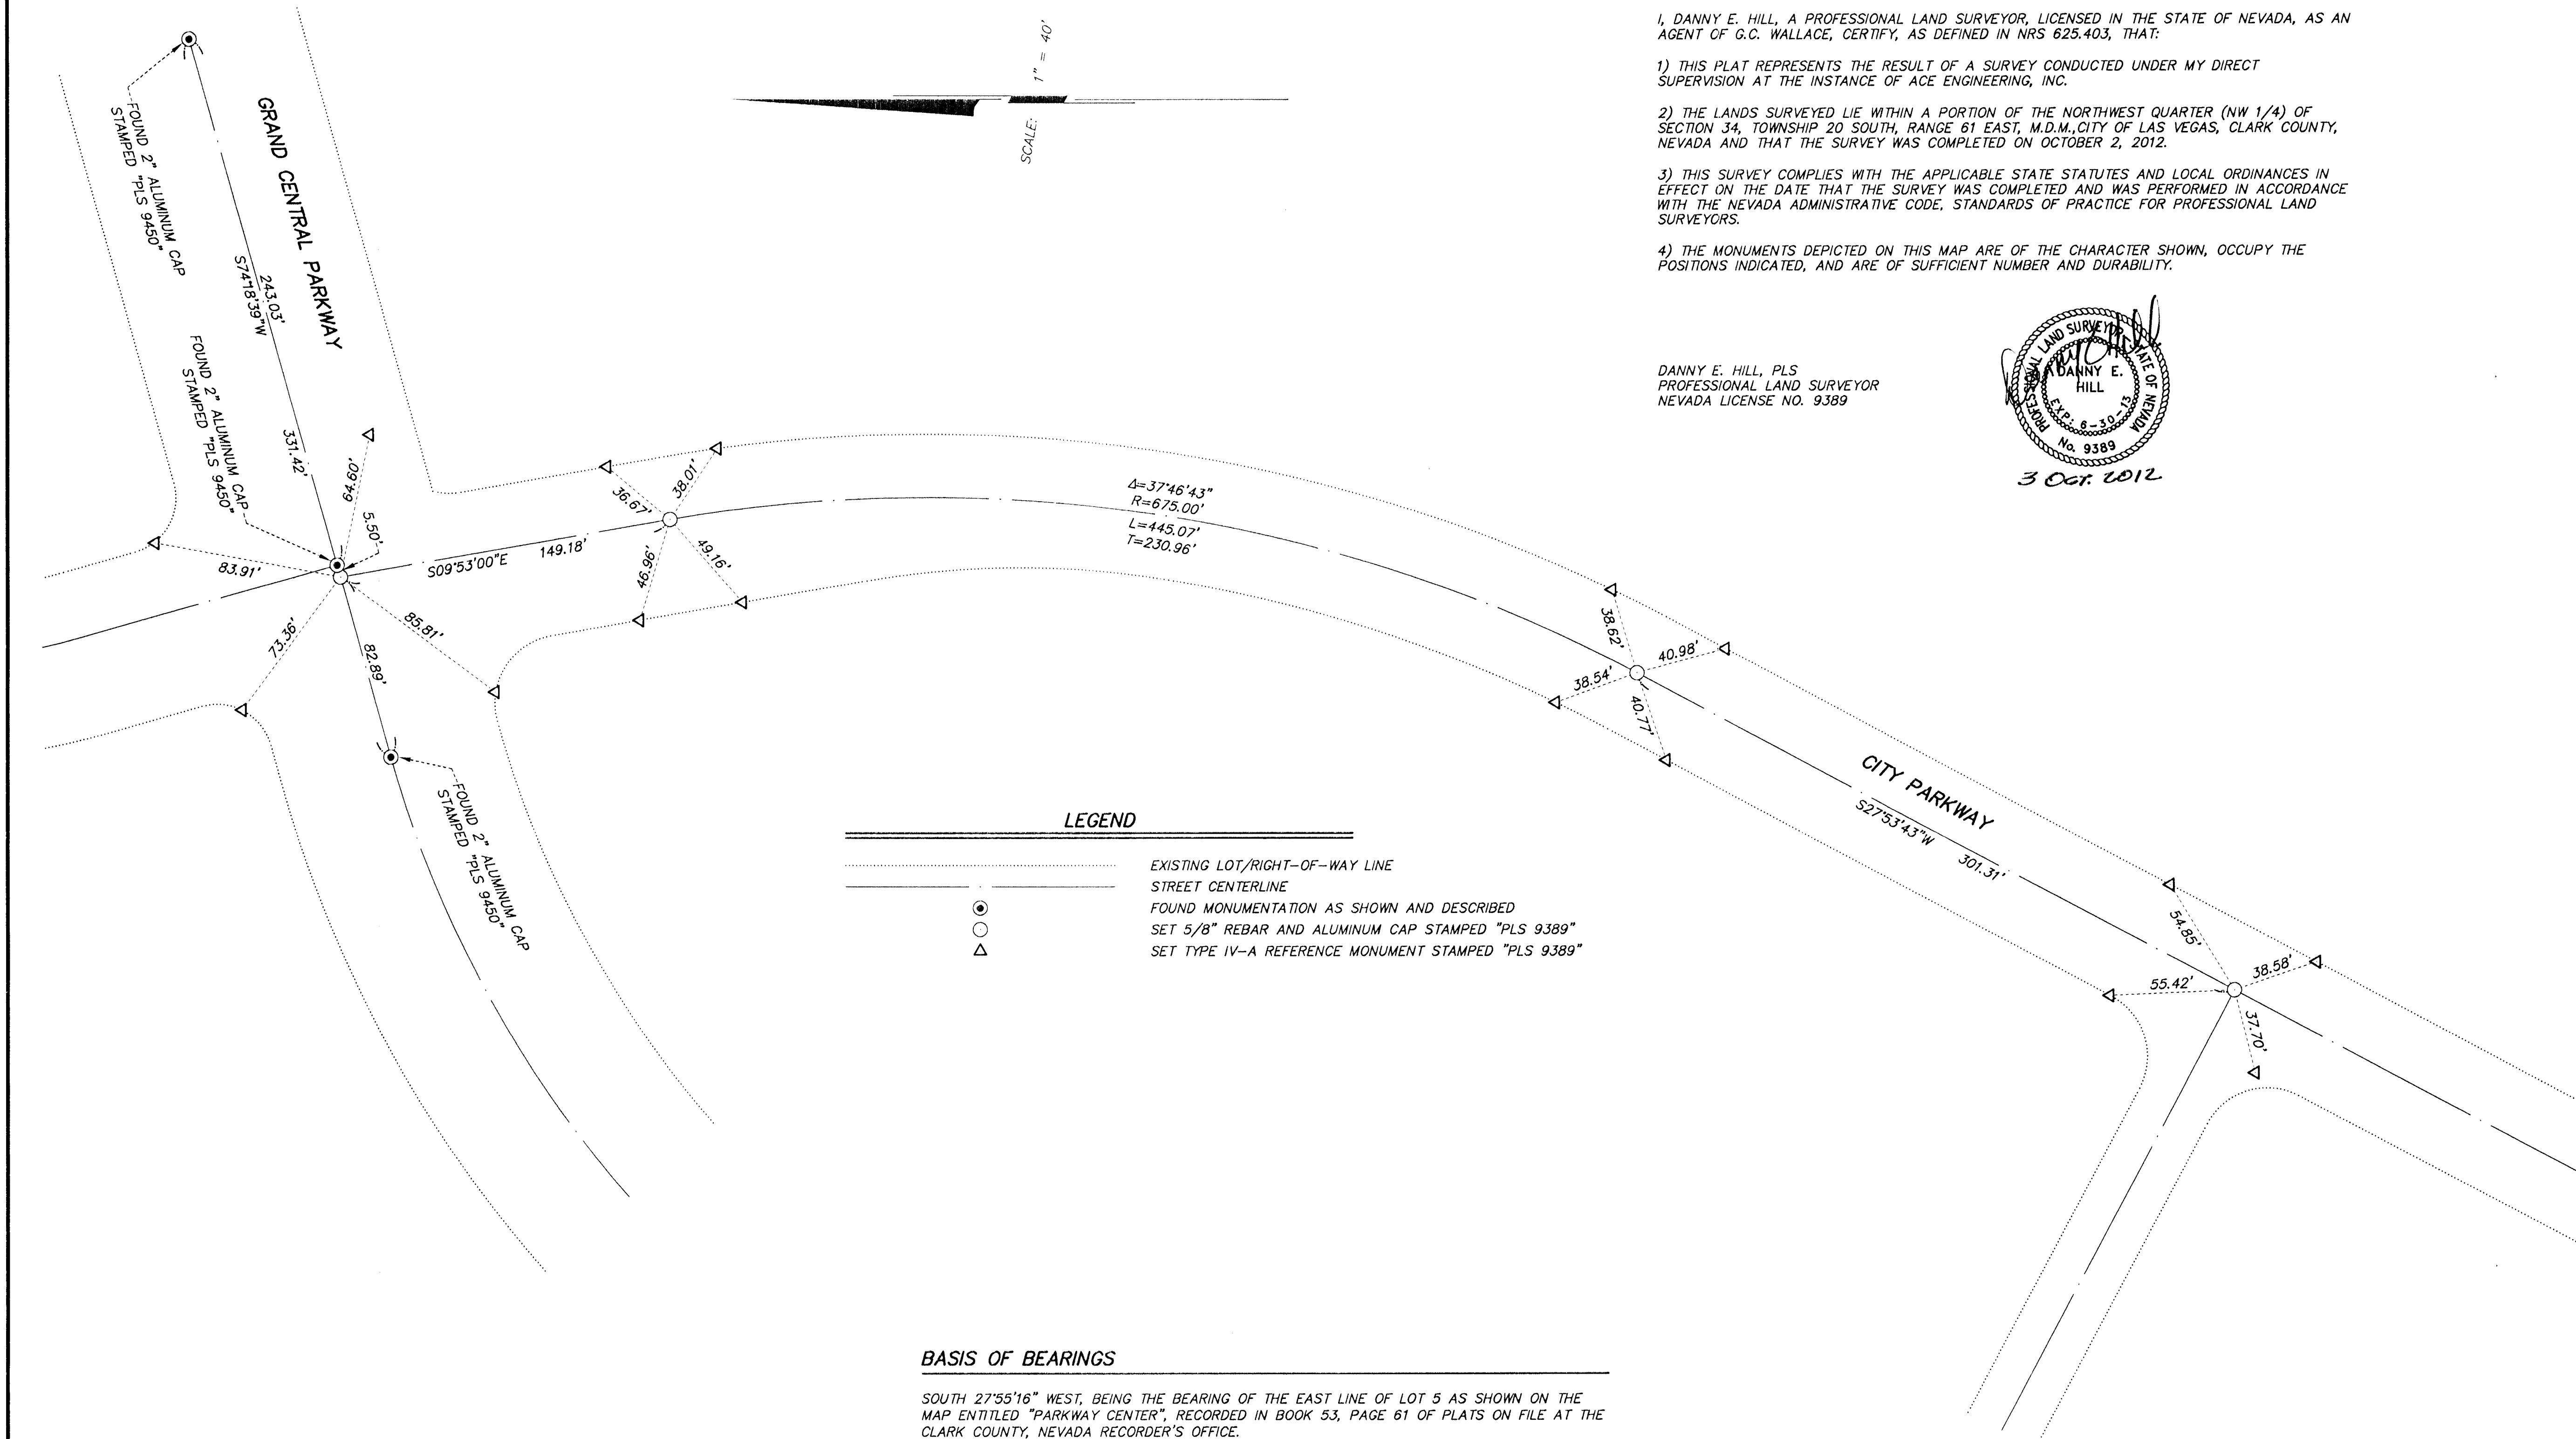


SURVEYOR'S CERTIFICATE

I, DANNY E. HILL, A PROFESSIONAL LAND SURVEYOR, LICENSED IN THE STATE OF NEVADA, AS AN AGENT OF G.C. WALLACE, CERTIFY, AS DEFINED IN NRS 625.403, THAT:

- 1) THIS PLAT REPRESENTS THE RESULT OF A SURVEY CONDUCTED UNDER MY DIRECT SUPERVISION AT THE INSTANCE OF ACE ENGINEERING, INC.
- 2) THE LANDS SURVEYED LIE WITHIN A PORTION OF THE NORTHWEST QUARTER (NW 1/4) OF SECTION 34, TOWNSHIP 20 SOUTH, RANGE 61 EAST, M.D.M., CITY OF LAS VEGAS, CLARK COUNTY, NEVADA AND THAT THE SURVEY WAS COMPLETED ON OCTOBER 2, 2012.
- 3) THIS SURVEY COMPLIES WITH THE APPLICABLE STATE STATUTES AND LOCAL ORDINANCES IN EFFECT ON THE DATE THAT THE SURVEY WAS COMPLETED AND WAS PERFORMED IN ACCORDANCE WITH THE NEVADA ADMINISTRATIVE CODE, STANDARDS OF PRACTICE FOR PROFESSIONAL LAND SURVEYORS.
- 4) THE MONUMENTS DEPICTED ON THIS MAP ARE OF THE CHARACTER SHOWN, OCCUPY THE POSITIONS INDICATED, AND ARE OF SUFFICIENT NUMBER AND DURABILITY.

DANNY E. HILL, PLS
PROFESSIONAL LAND SURVEYOR
NEVADA LICENSE NO. 9389

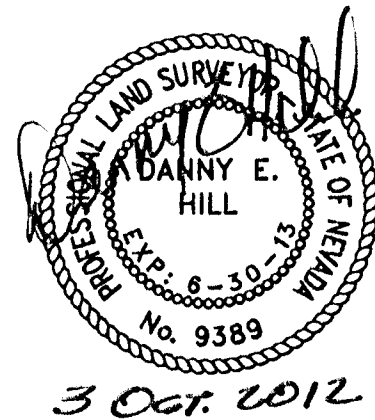

LEGEND

- EXISTING LOT/RIGHT-OF-WAY LINE
- STREET CENTERLINE
- FOUND MONUMENTATION AS SHOWN AND DESCRIBED
- SET 5/8" REBAR AND ALUMINUM CAP STAMPED "PLS 9389"
- SET TYPE IV-A REFERENCE MONUMENT STAMPED "PLS 9389"

BASIS OF BEARINGS

SOUTH 27°55'16" WEST, BEING THE BEARING OF THE EAST LINE OF LOT 5 AS SHOWN ON THE MAP ENTITLED "PARKWAY CENTER", RECORDED IN BOOK 53, PAGE 61 OF PLATS ON FILE AT THE CLARK COUNTY, NEVADA RECORDER'S OFFICE.

COUNTY RECORDER'S NOTE

ANY SUBSEQUENT CHANGES TO THIS MAP SHOULD BE EXAMINED AND MAY BE DETERMINED BY REFERENCE TO THE COUNTY RECORDER'S CUMULATIVE MAP INDEX. NRS 278.5695.

RECORD OF SURVEY FOR A PORTION OF CITY PARKWAY	INSTRUMENT NO. <u>02074</u> OFFICIAL RECORDS BOOK NO. <u>20121008</u> FILED AT THE REQUEST OF G.C. WALLACE INC. DATE <u>10-8-12</u> AT <u>14:40 PM</u> FILE <u>187</u> PAGE <u>0053</u>
A PORTION OF THE NORTHWEST QUARTER (NW 1/4) OF SECTION 34, TOWNSHIP 20 SOUTH, RANGE 61 EAST, M.D.M., CITY OF LAS VEGAS, CLARK COUNTY, NEVADA	OF SURVEYS CLARK COUNTY, NEVADA RECORDS DEBBIE CONWAY, RECORDER FEE \$ <u>24.00</u> DEPUTY <u>SAD</u>
G. C. WALLACE COMPANIES ENGINEERS PLANNERS SURVEYORS 1555 S. RAINBOW BLVD. LAS VEGAS, NV 89146 T: 702.804.2000 • F: 702.804.2299 • GCWALLACE.COM	

055-763

4-43544