
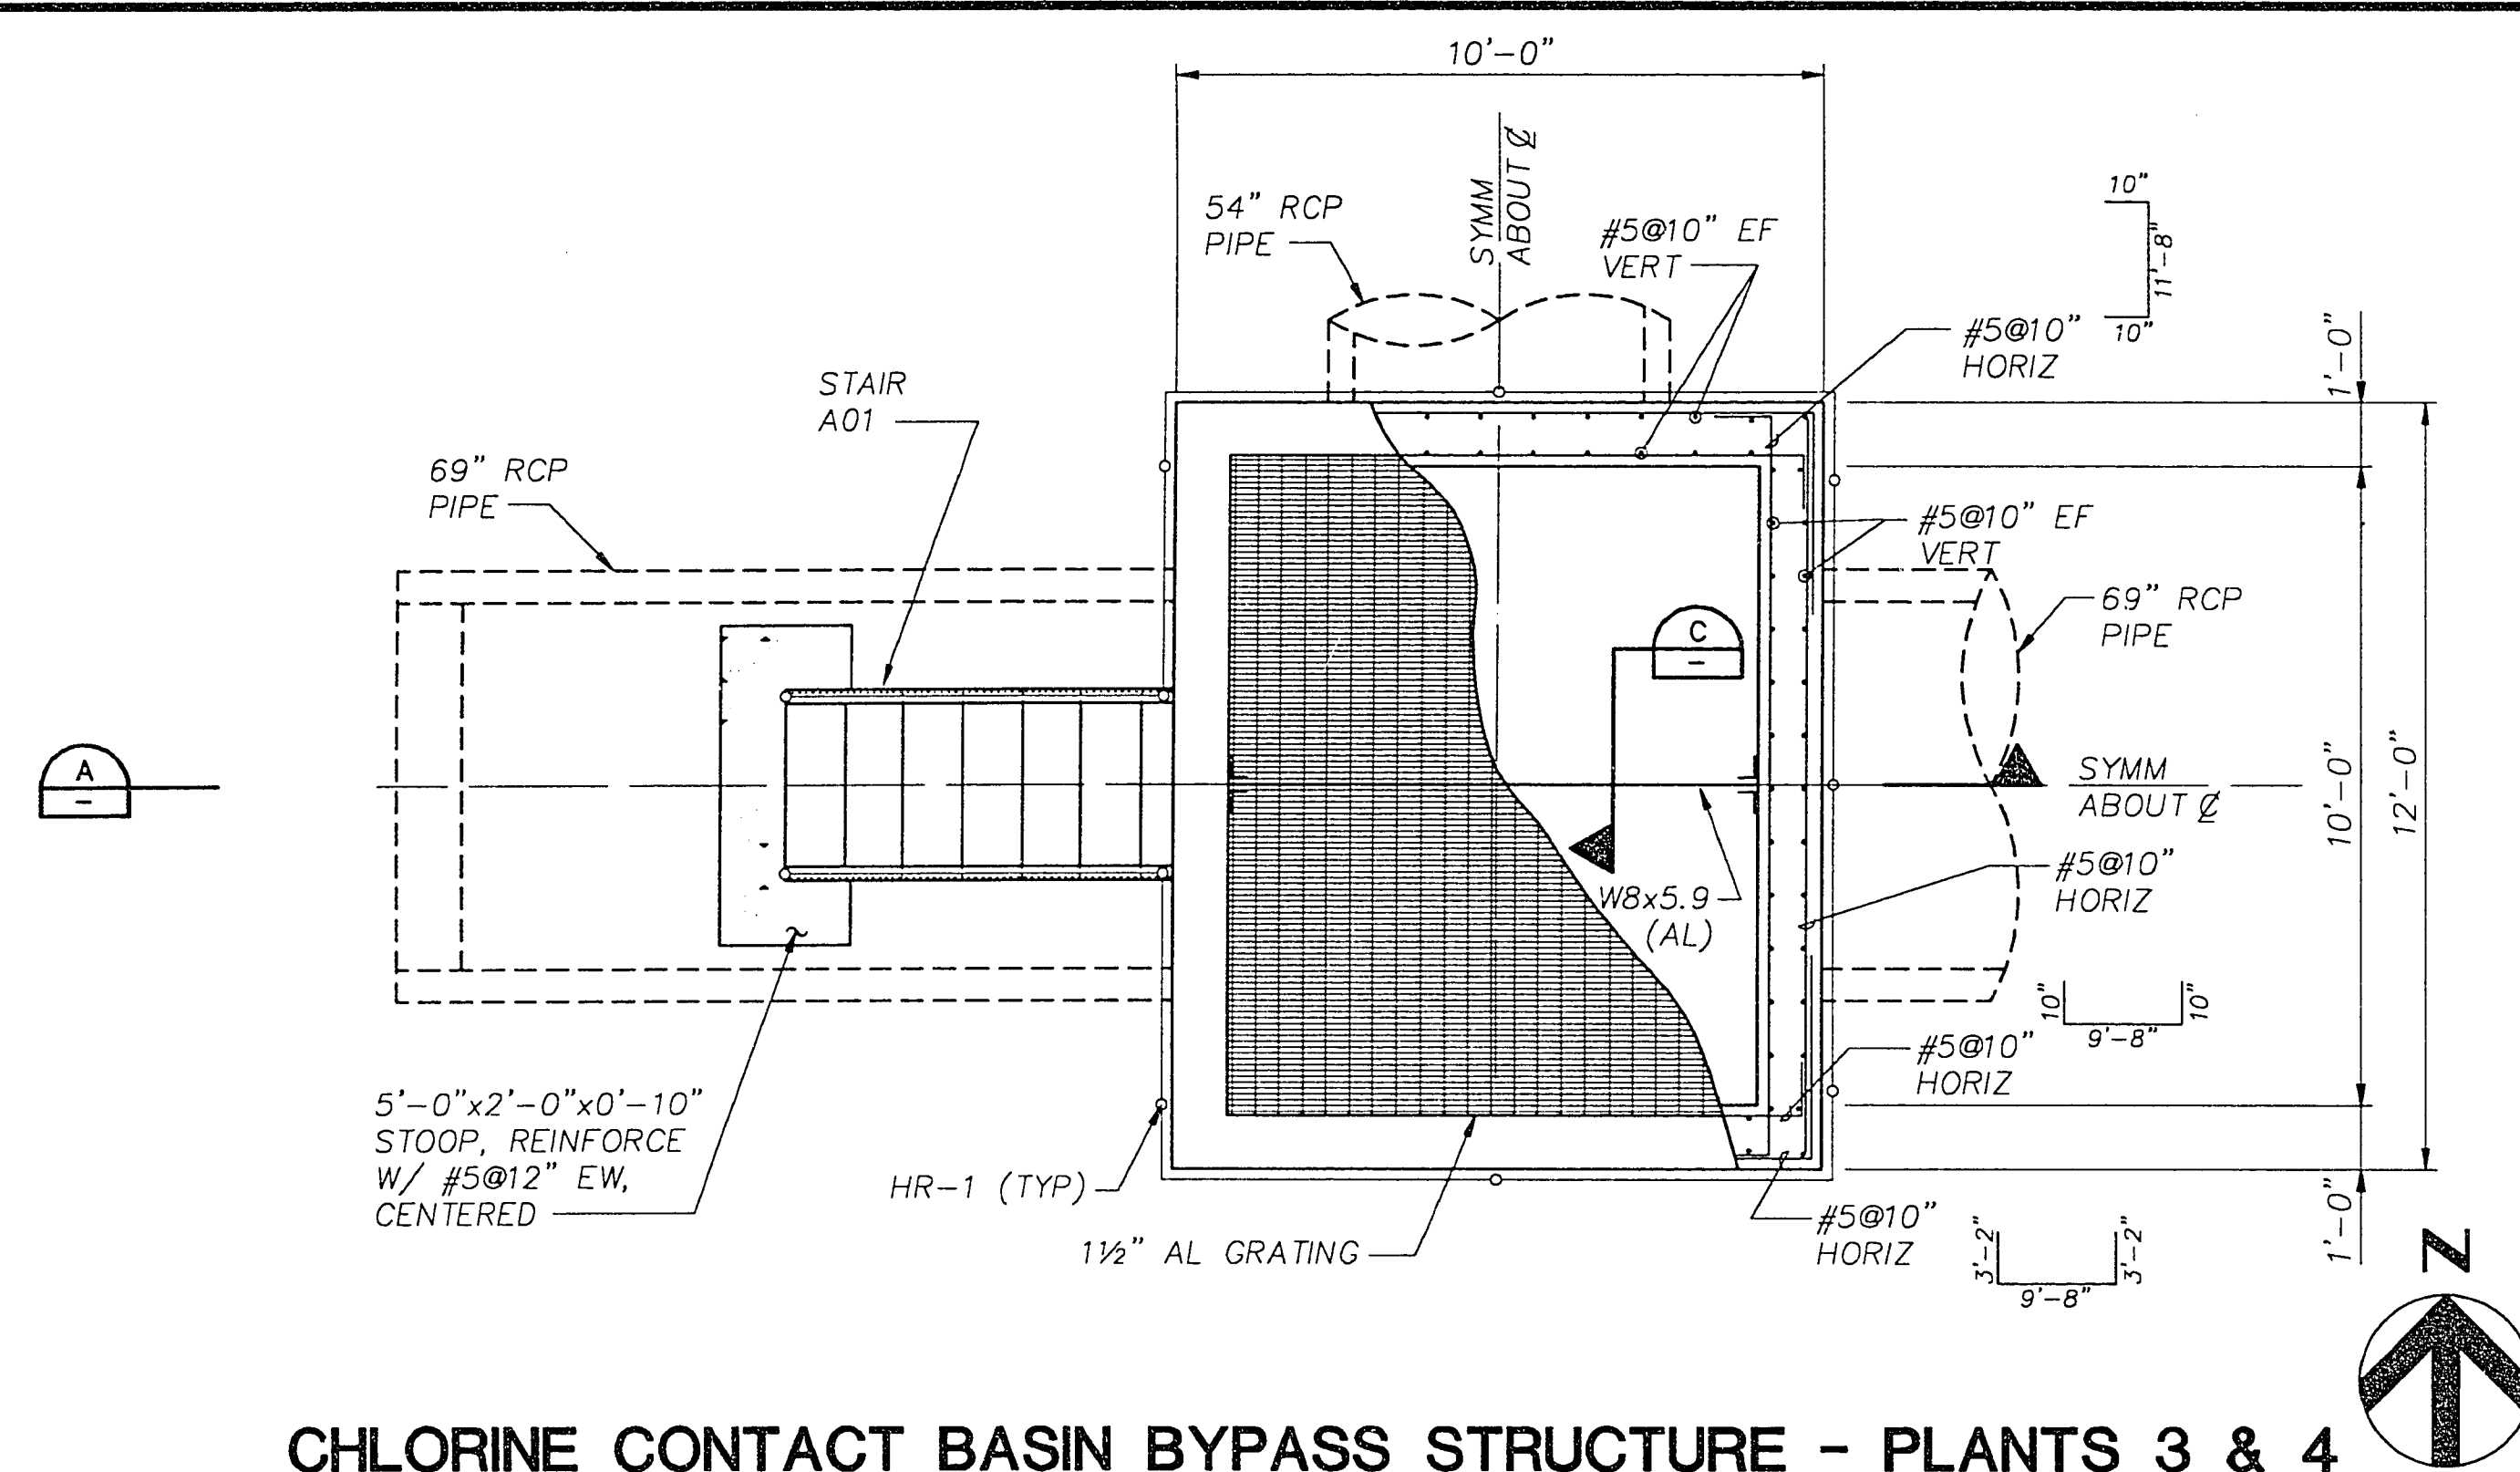
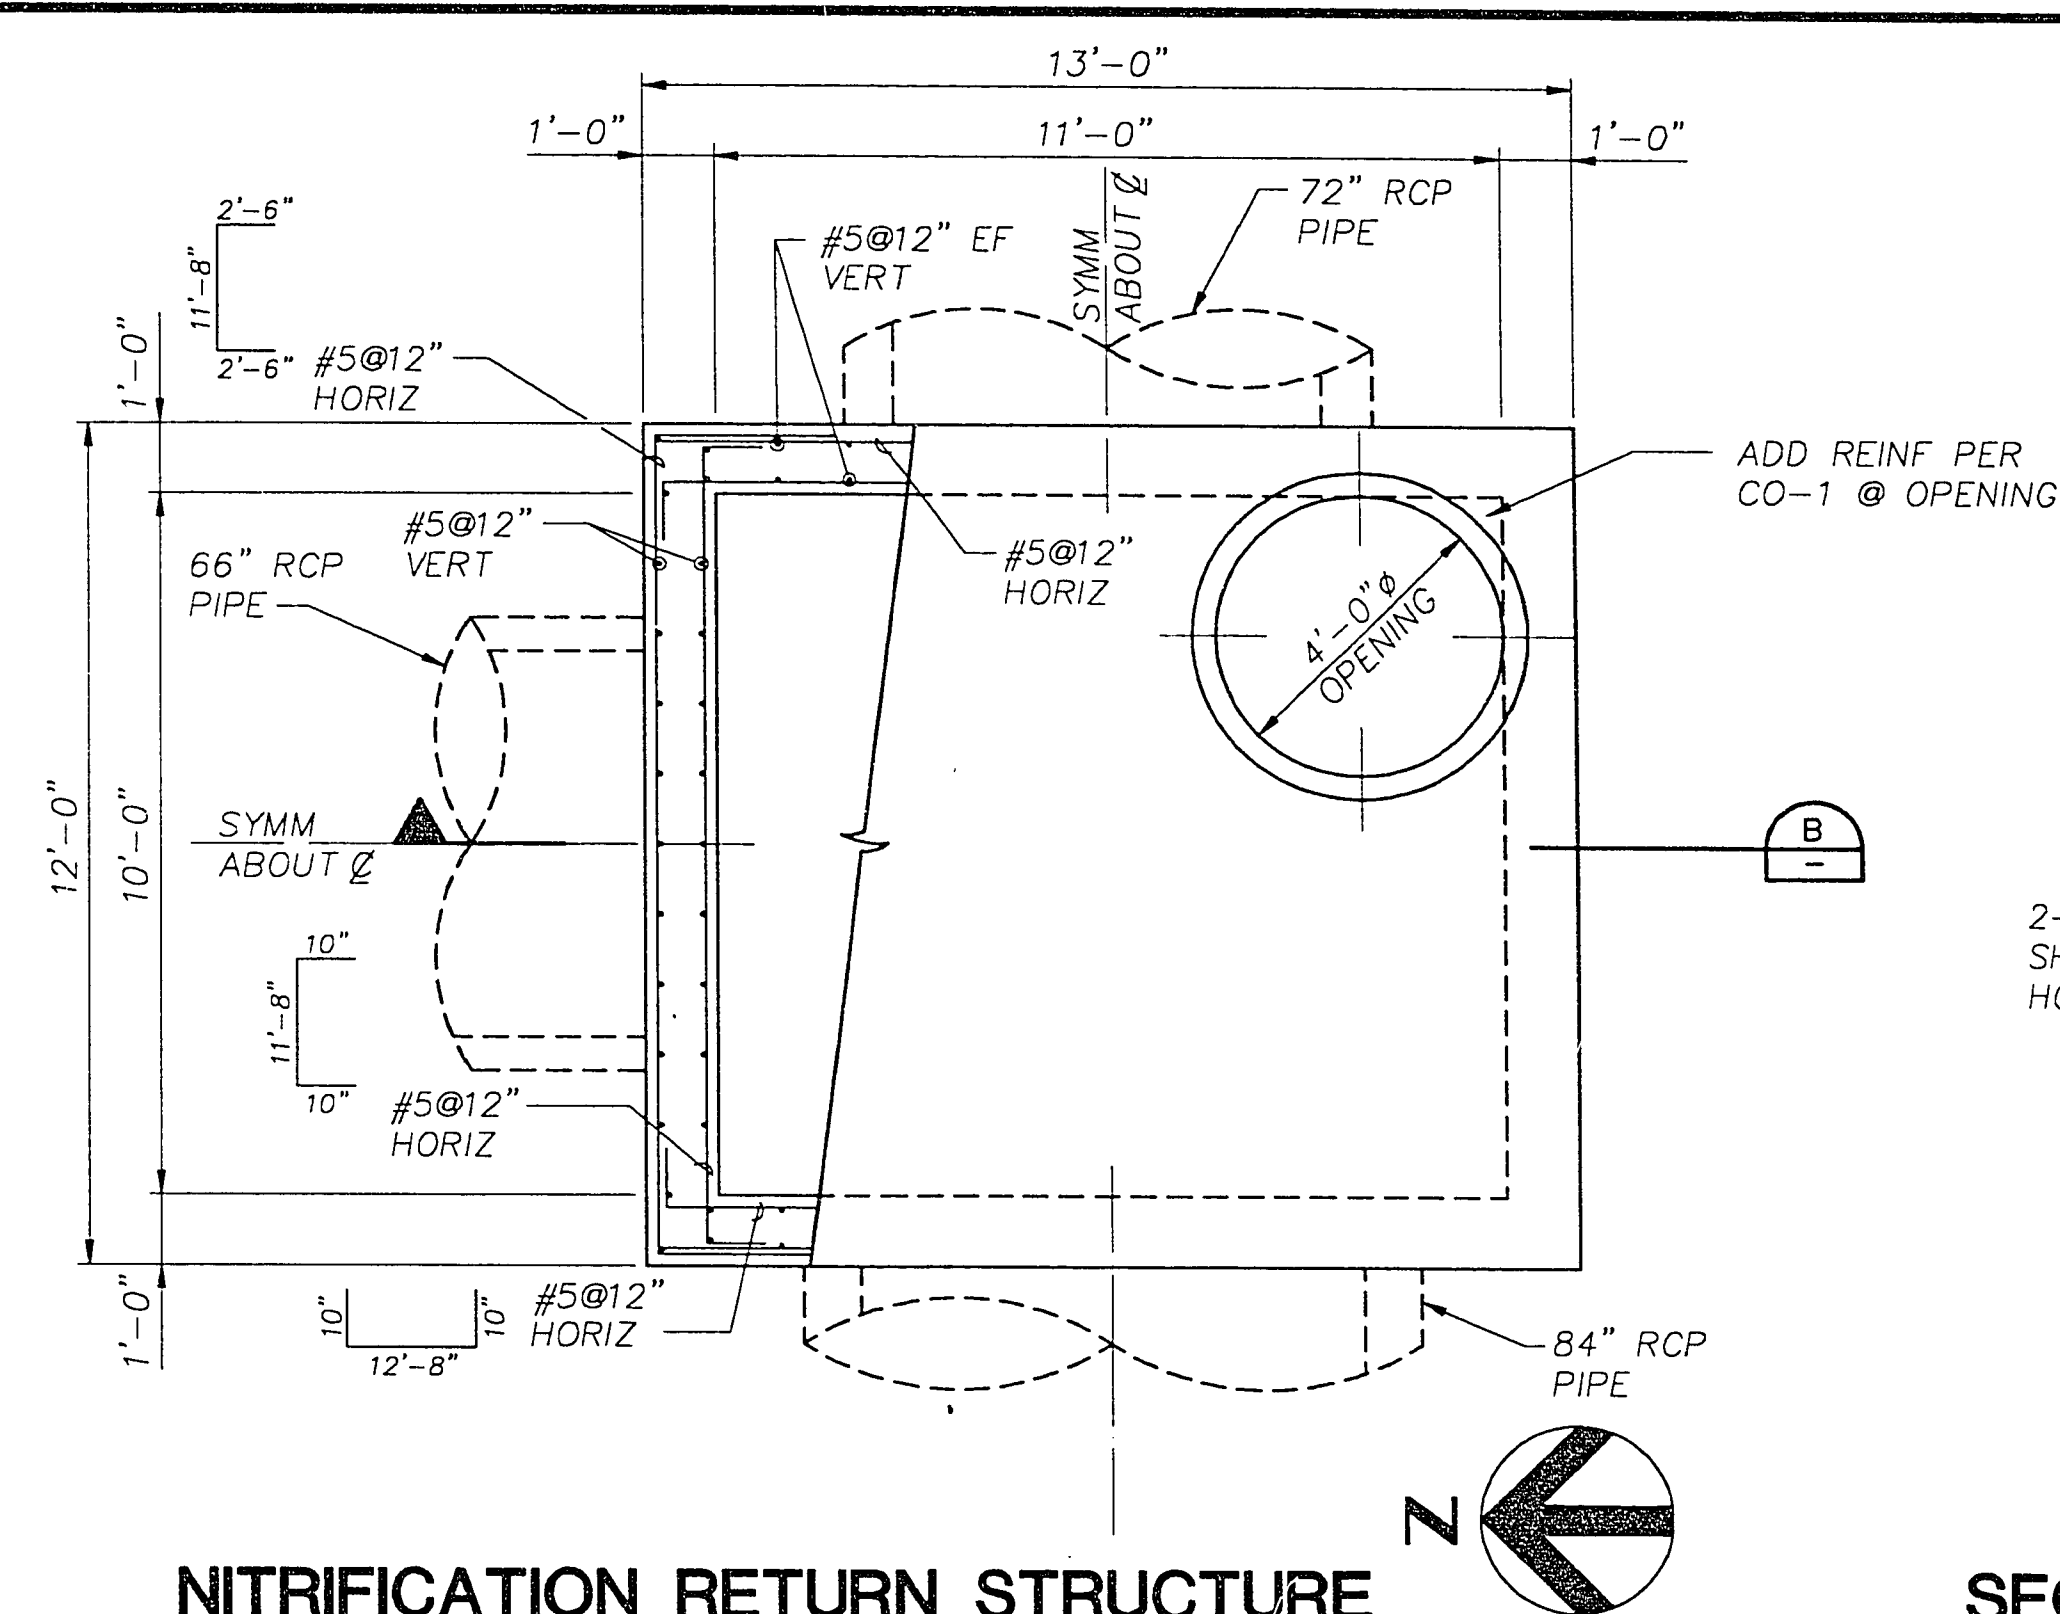


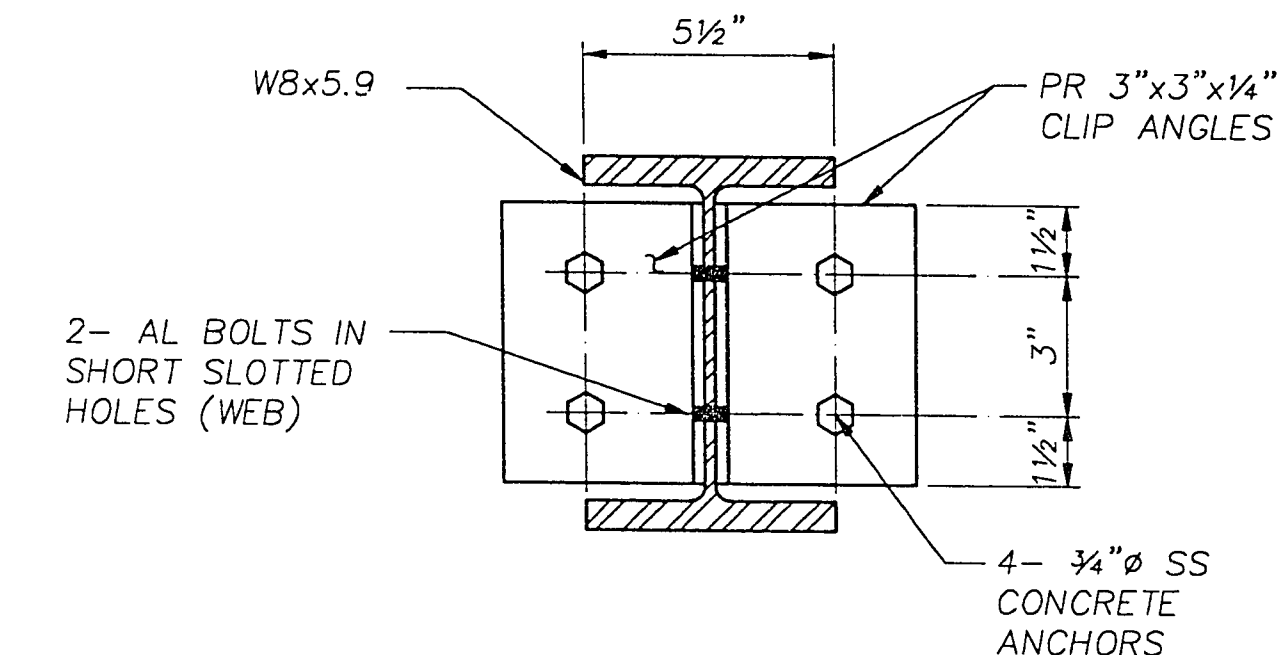


### CHLORINE CONTACT BASIN BYPASS STRUCTURE - PLANTS 3 & 4

$$\frac{3}{8}'' = 1' - 0''$$


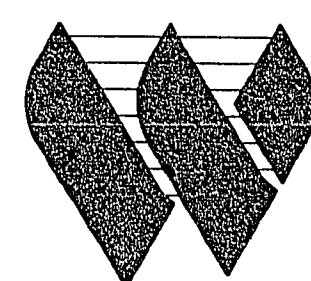
## NITRIFICATION RETURN STRUCTURE

$$\frac{3}{8}'' = 1' - 0''$$


## SECTION
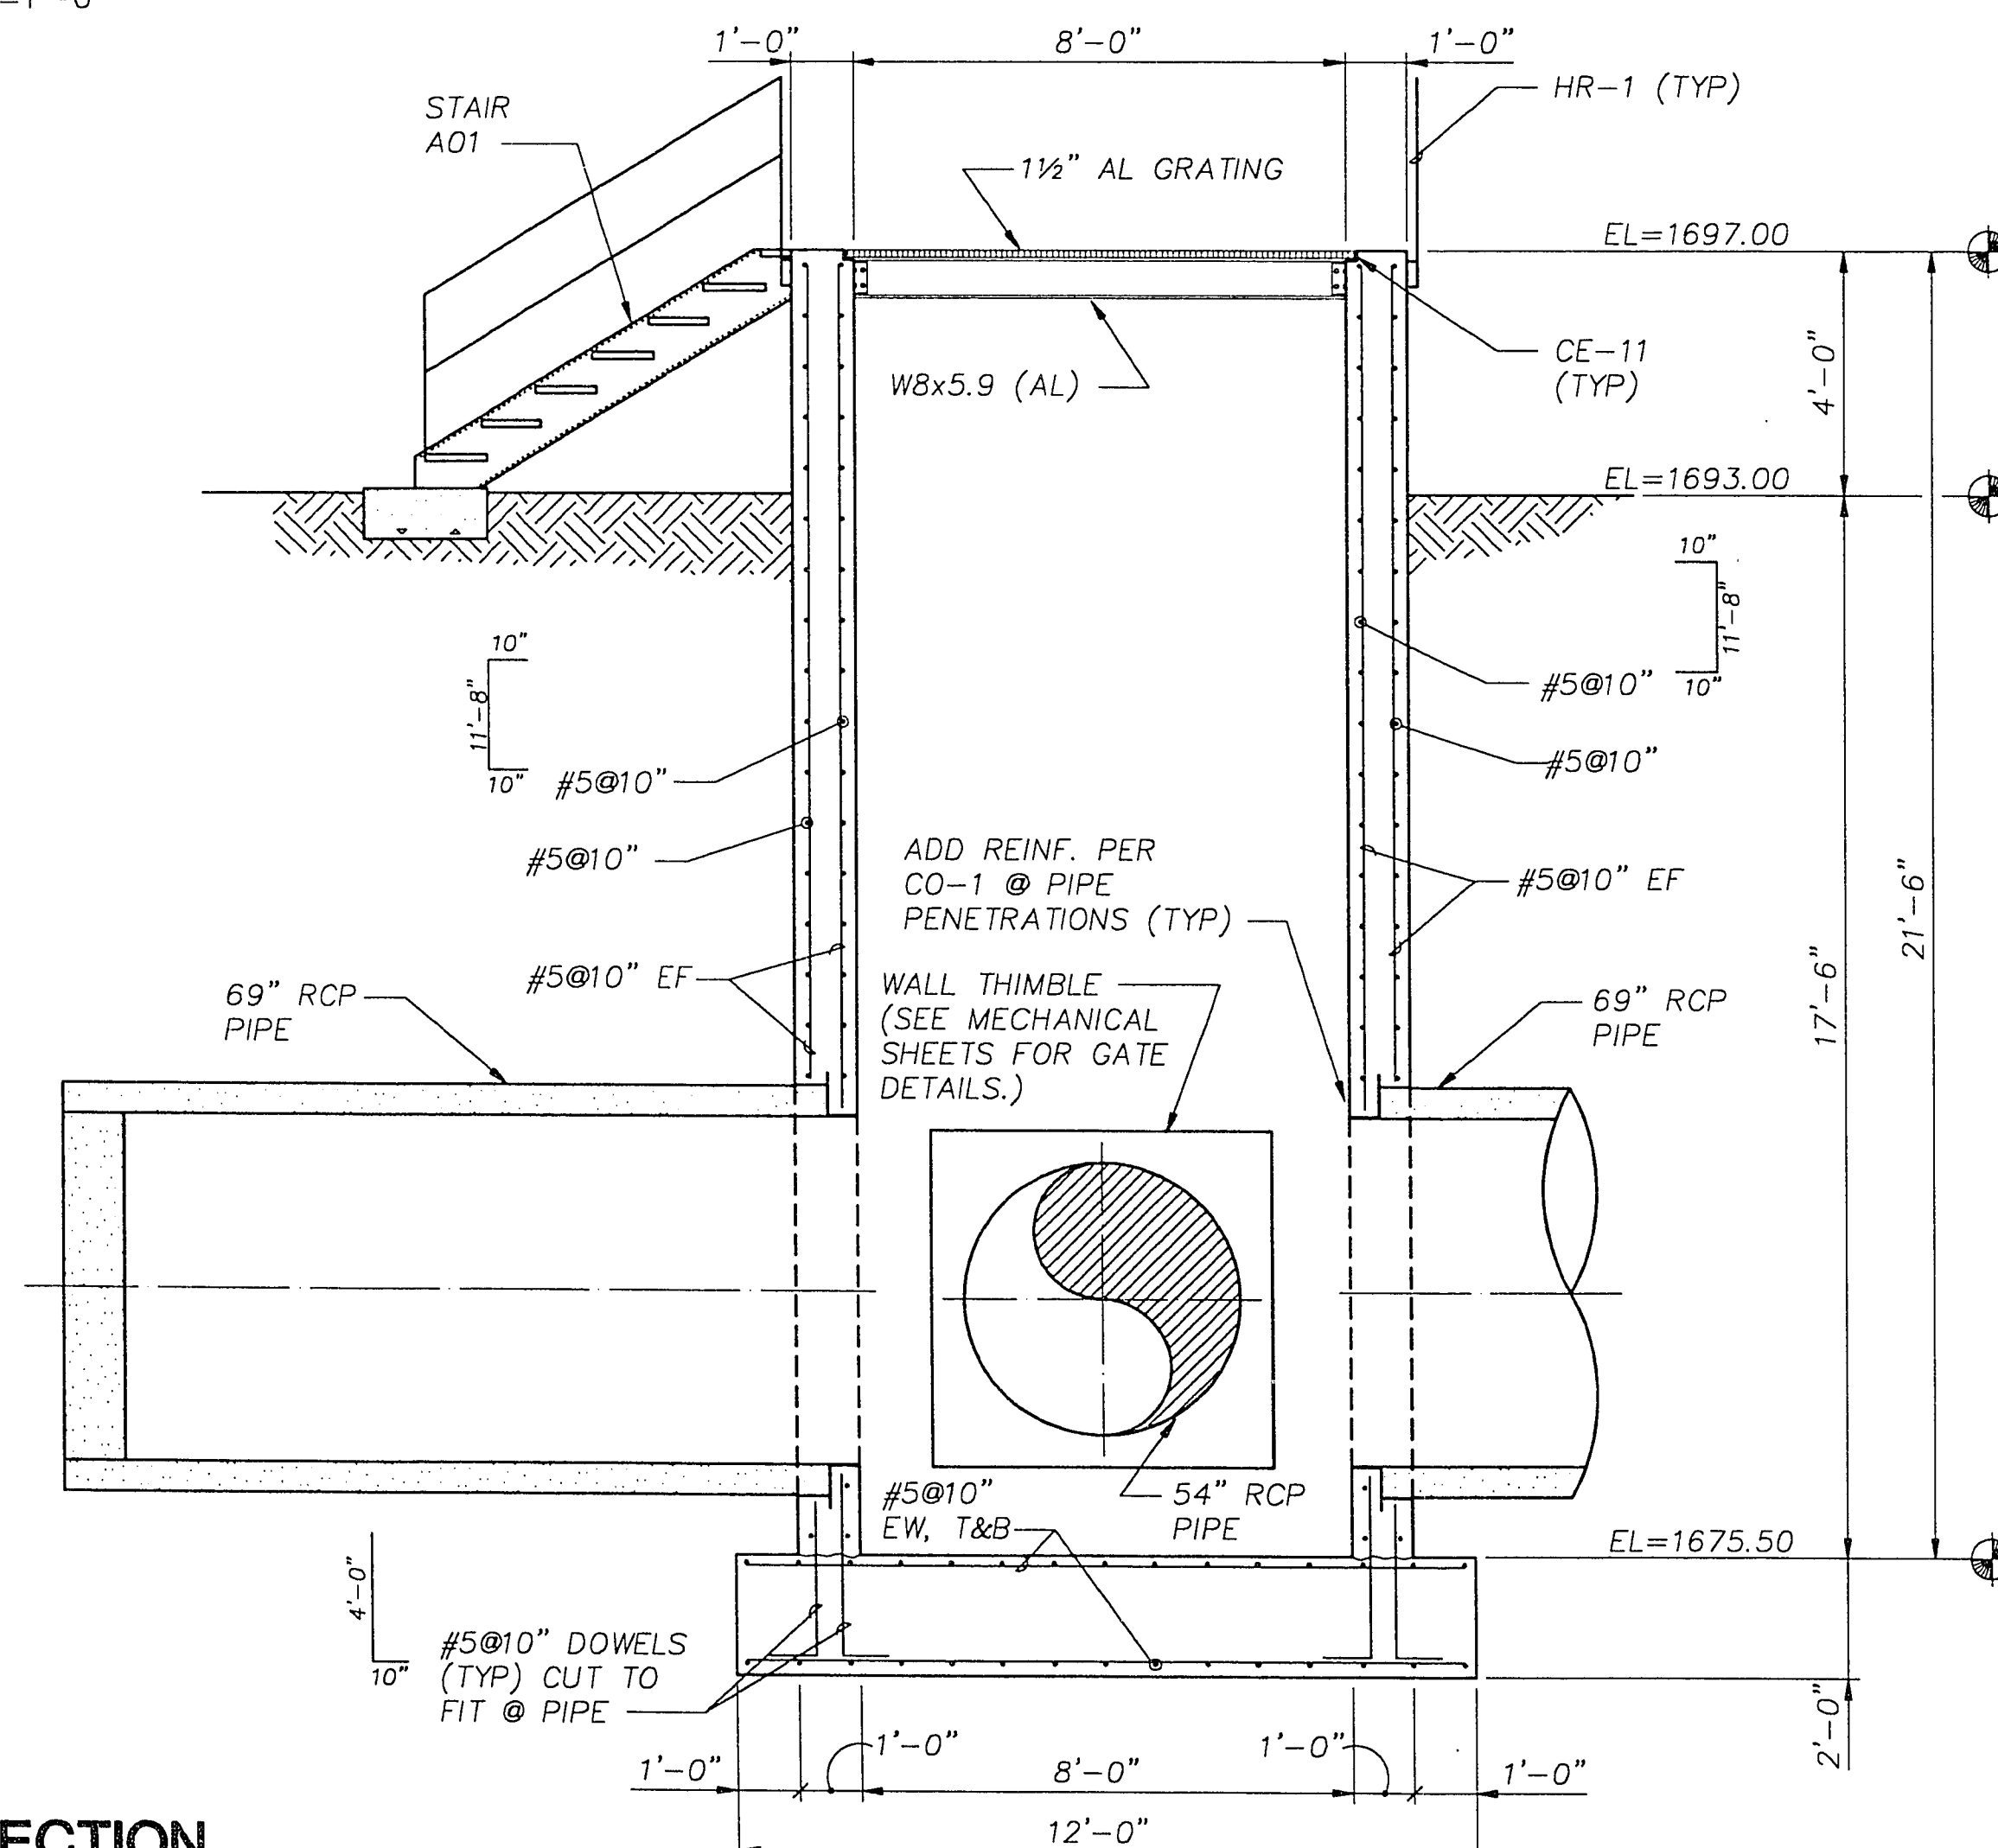
$$3'' = 1' - 0''$$


## SECTION



$$\frac{3}{8}'' = 1' - 0''$$


**G.C. WALLACE, INC.**  
Engineering/Architecture



HDR Engineering, Inc.

|           |                                             |        |      |      |             |            |  |  |
|-----------|---------------------------------------------|--------|------|------|-------------|------------|--|--|
|           |                                             |        |      |      |             |            |  |  |
|           |                                             |        |      |      |             |            |  |  |
|           |                                             |        |      |      |             |            |  |  |
| 3         | CORRECTED ACCORDING TO CONSTRUCTION RECORDS | 7/1/94 | LKE  | EFH  | MIL         | MJH        |  |  |
| O         | ISSUED FOR CONSTRUCTION                     | 6/1/92 | JH   | CLS  | CRD         | JBG        |  |  |
| A         | ISSUED FOR BIDS                             | 1/6/92 | JH   | CLS  | CRD         | JBG        |  |  |
| Issue No. | Description                                 | Date   | Dwn. | Chd. | Resp. Engr. | Proj. Mgr. |  |  |

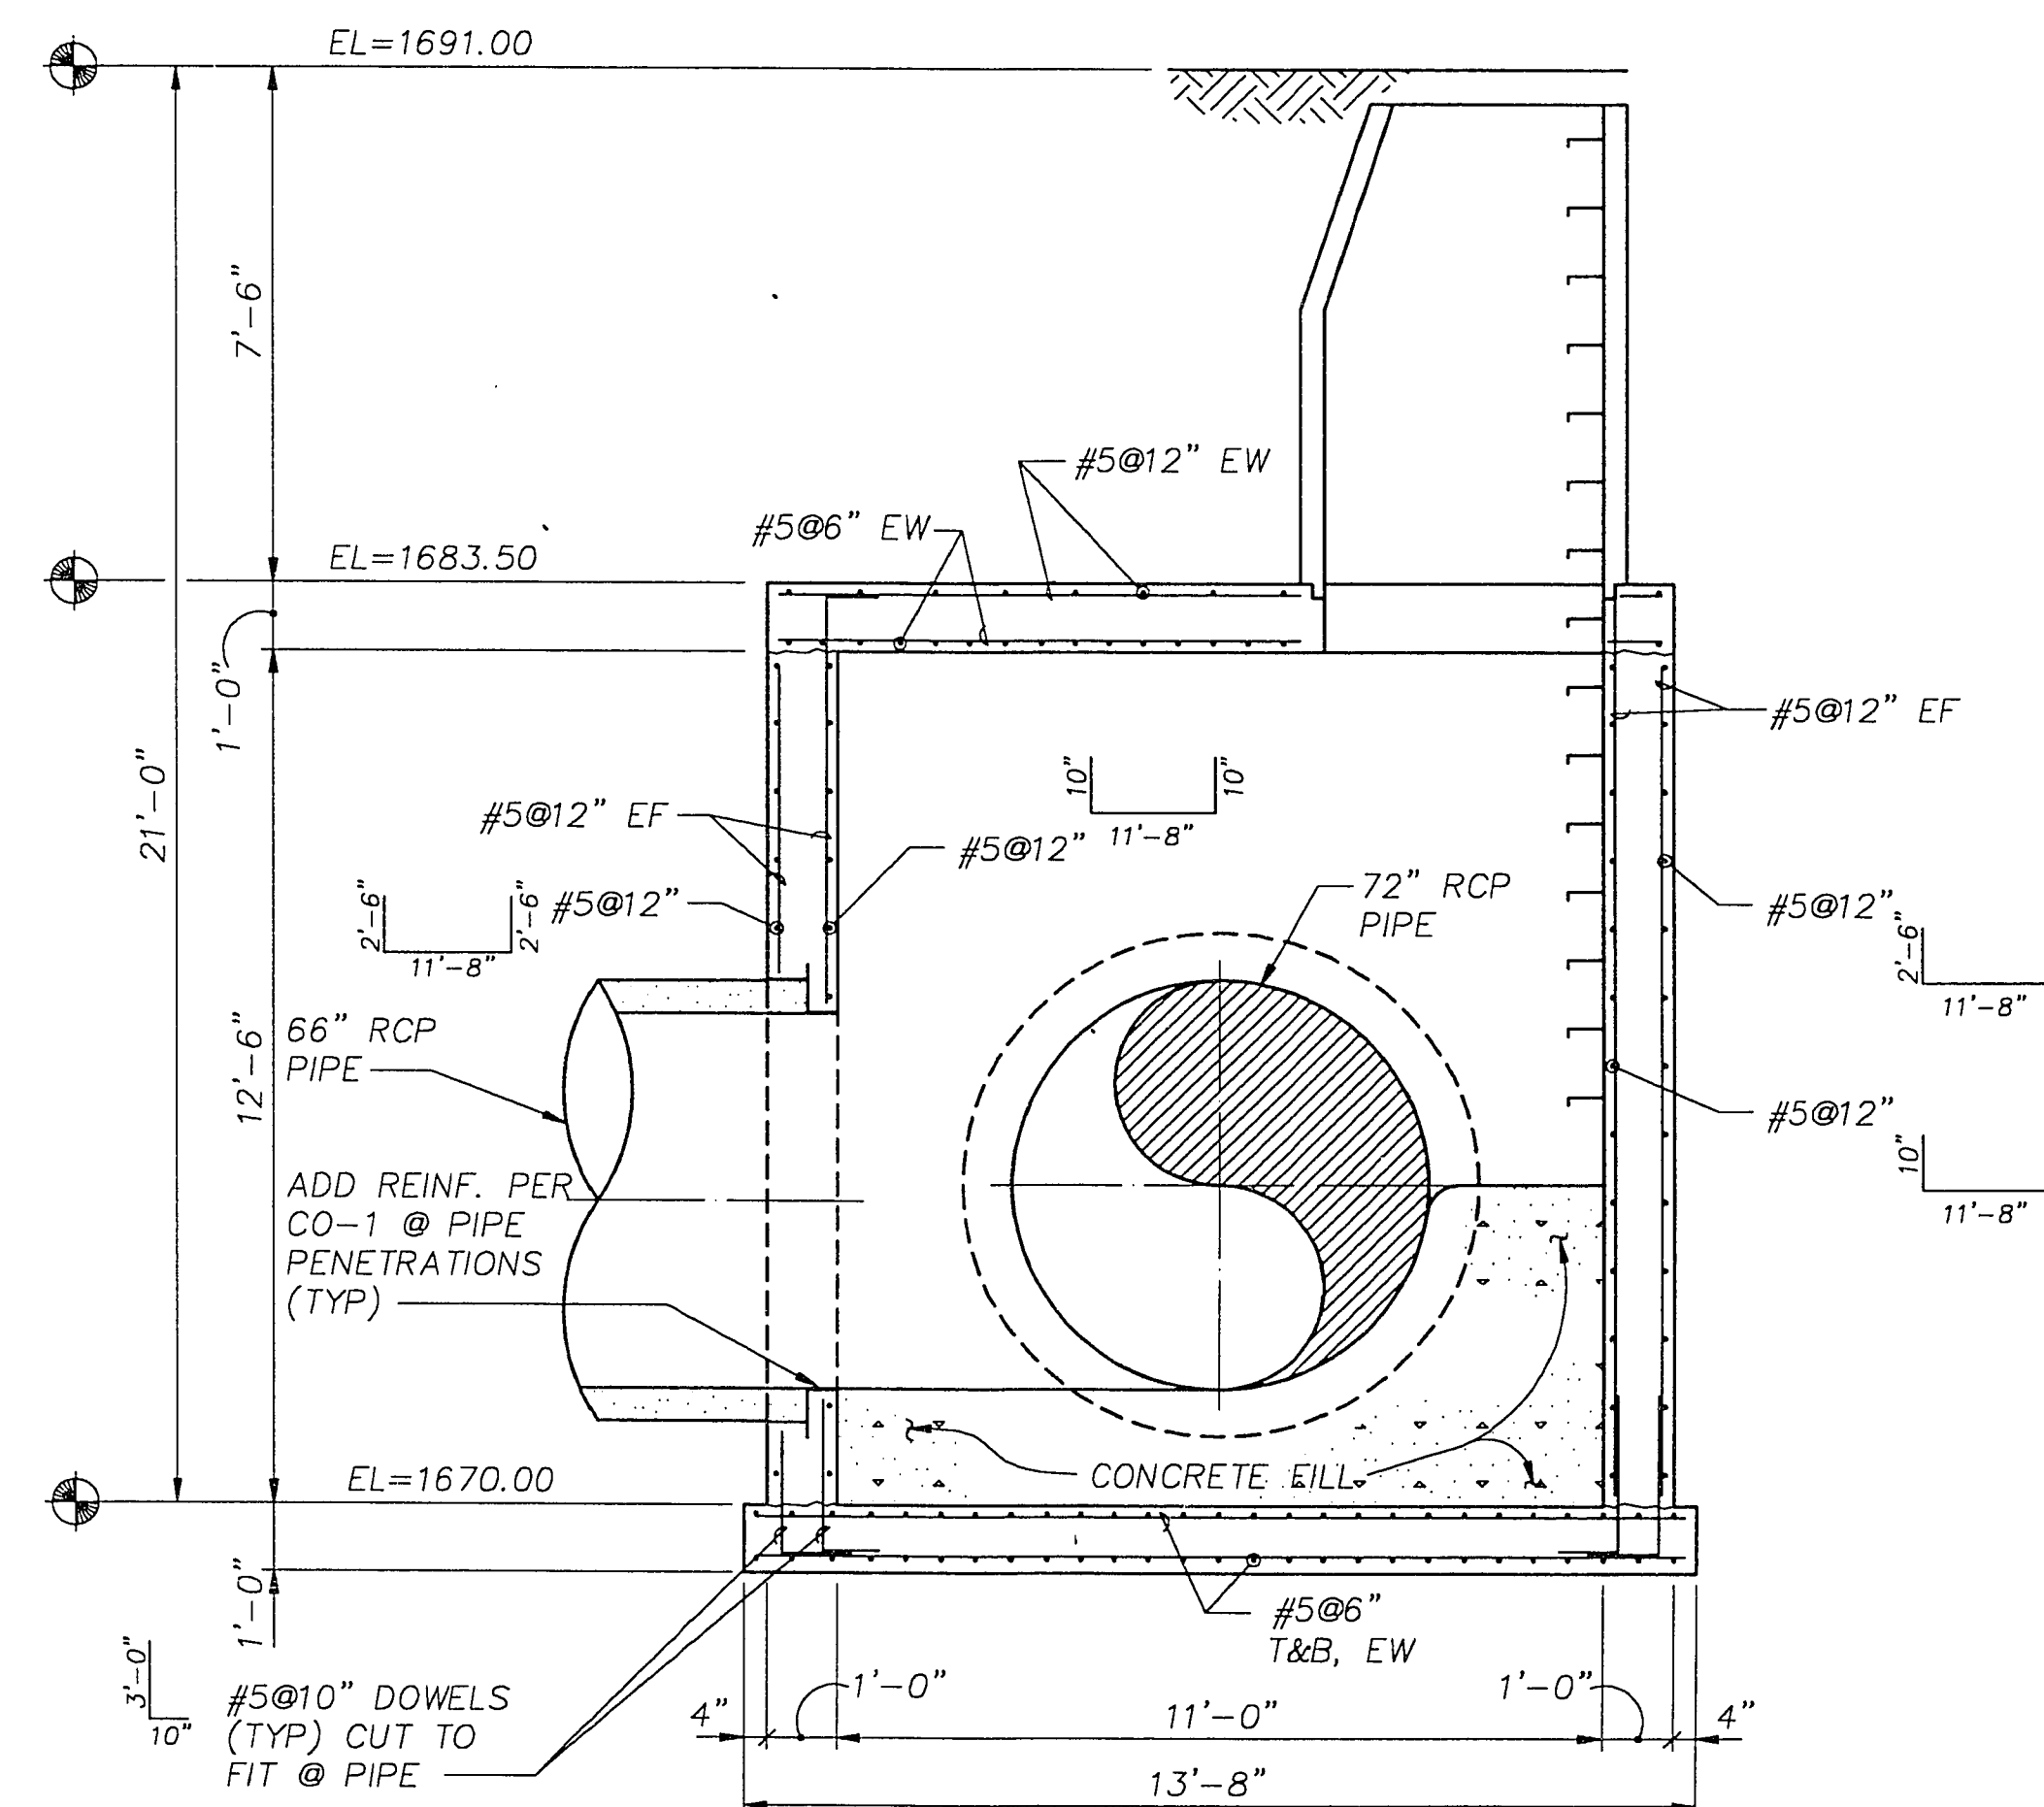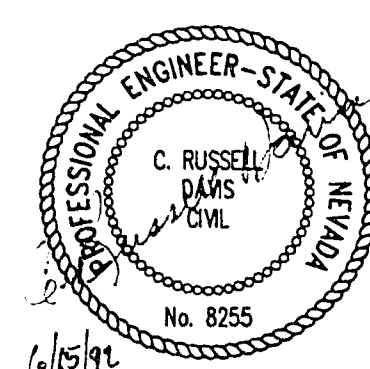

## SECTION

$$\frac{3}{8}'' = 1' - 0'$$

|                          |                     |
|--------------------------|---------------------|
| Project Manager          |                     |
| <b>JEFFREY B. GLOVER</b> |                     |
| Architect                | IsC/Process         |
| Civil                    | Mechanical          |
| Electrical               | Structural          |
|                          | <b>R. DAVIS</b>     |
|                          | Drawn By            |
|                          | <b>J. HIRSHOUER</b> |

City of Las Vegas

**Water Pollution Control Facility  
Nitrification / Filtration Facilities**

Contract 16  
EFFLUENT FILTRATION COMPLEX

YARD STRUCTURES

### C.C.B. BYPASS STRUCTURE-PLANTS 3 & 4 NITRIFICATION RETURN STRUCTURE

|                   |                              |                                   |            |
|-------------------|------------------------------|-----------------------------------|------------|
| Date<br>JUNE 1992 | Project No.<br>00120-083-141 | Drawing No.<br>S-005<br>60 of 274 | Issue<br>3 |
| Scale<br>AS SHOWN |                              |                                   |            |

9-1-60

311.33