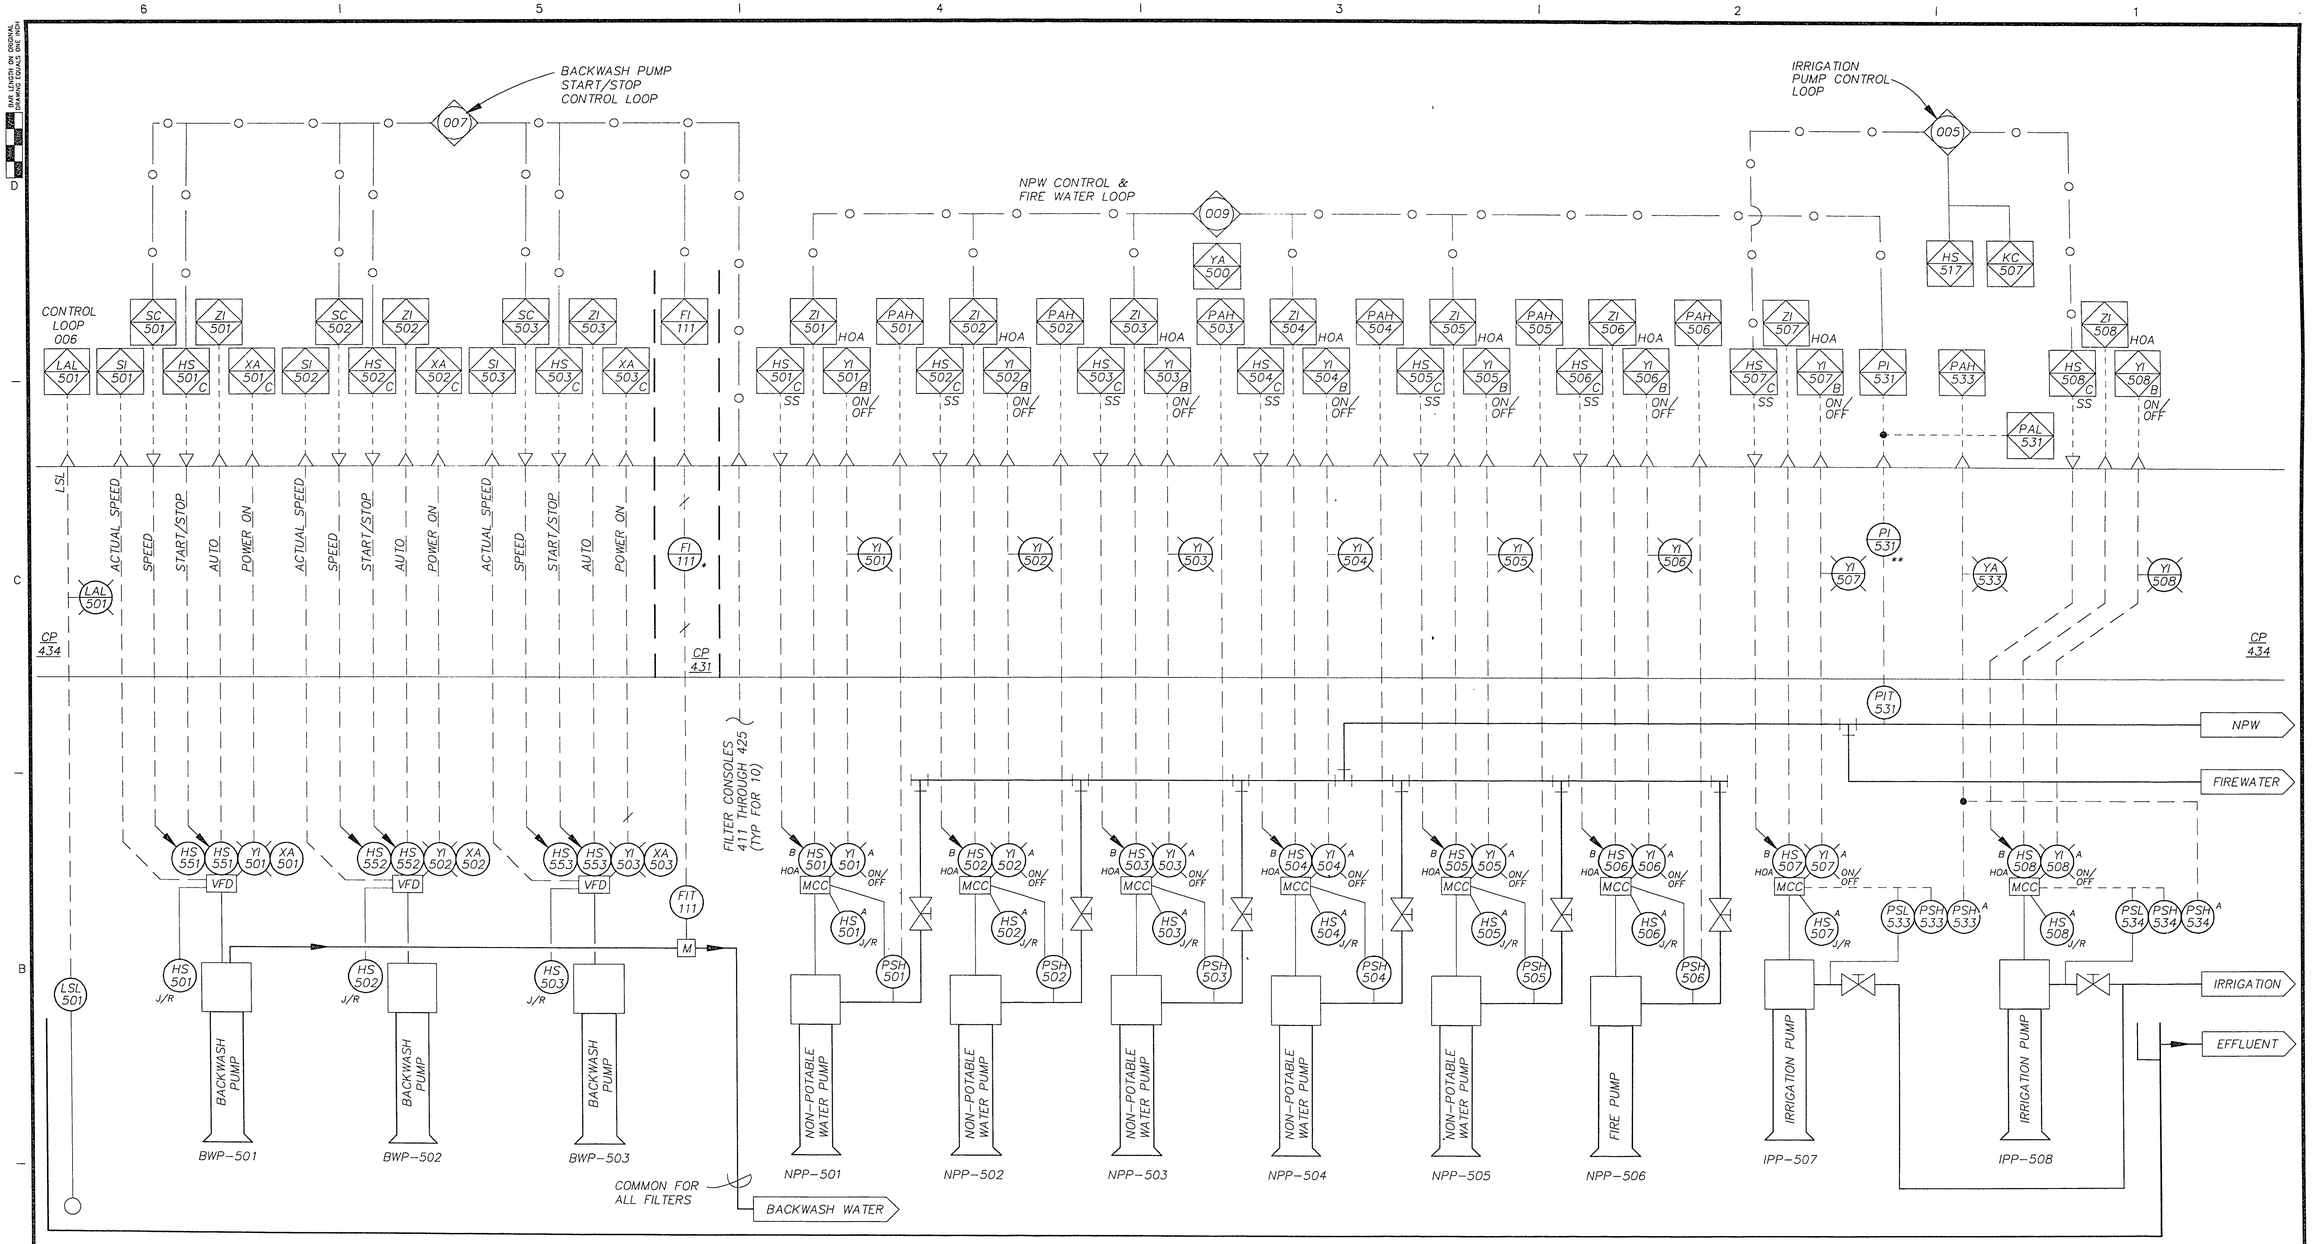

▲ BACKWASH RATE CONTROL

* LOCATED ON BACKWASH CONTROL PANEL

** LOCATED ON NPW CONTROL PANEL

Cl_2 CONTACT BASIN

SEE TESCO CONTROLS AS-BUILTS, SHTS T-14087-01 THRU T-14087-409

HDR

HDR Engineering, Inc.

Issue No.	Description	Date	Drwn.	Chkd.	Resp. Engr.	Proj. Mgr.
3	CORRECTED ACCORDING TO CONSTRUCTION RECORDS	7/1/94	LKE	THK	PSC	MJH
2	ISSUED FOR CONSTRUCTION	6/8/92	BMP	LDS	LDS	JBG
△	ADDENDUM #2	2/24/92	RCB	LDS	LDS	JBG
A	ISSUED FOR BIDS	1/6/92	RCB	LDS	LDS	JBG

Project Manager: JEFFREY B. GLOVER
Architect
I&C/Process
Civil
Mechanical
Electrical: L. SMITHEY
Structural
Drawn By: R. BURNS

City of Las Vegas
Water Pollution Control Facility
Nitrification / Filtration Facilities
Contract 16
EFFLUENT FILTRATION COMPLEX

NPW & BACKWASH PUMPS

Date: JUNE 1992
Scale: NONE
Project No.: 00120-083-141
Drawing No.: I-05
263 of 274
Issue: 3

311.33