
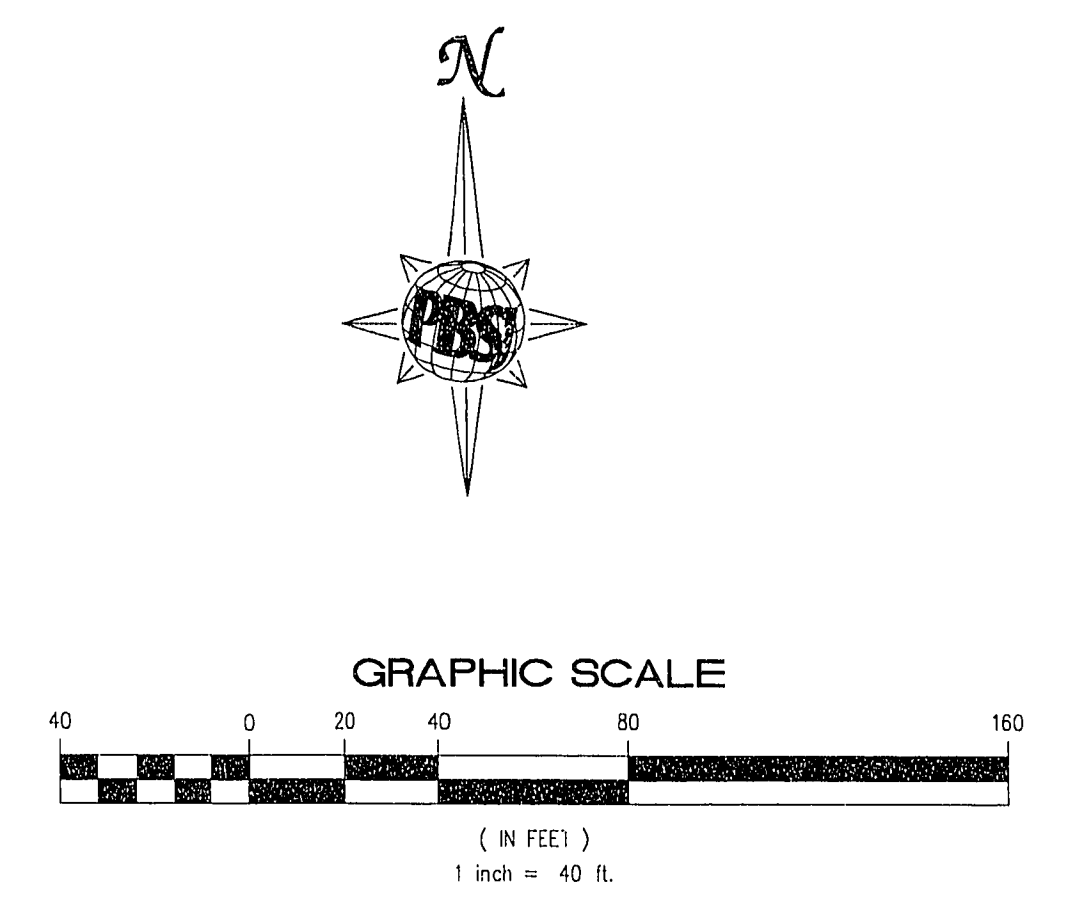
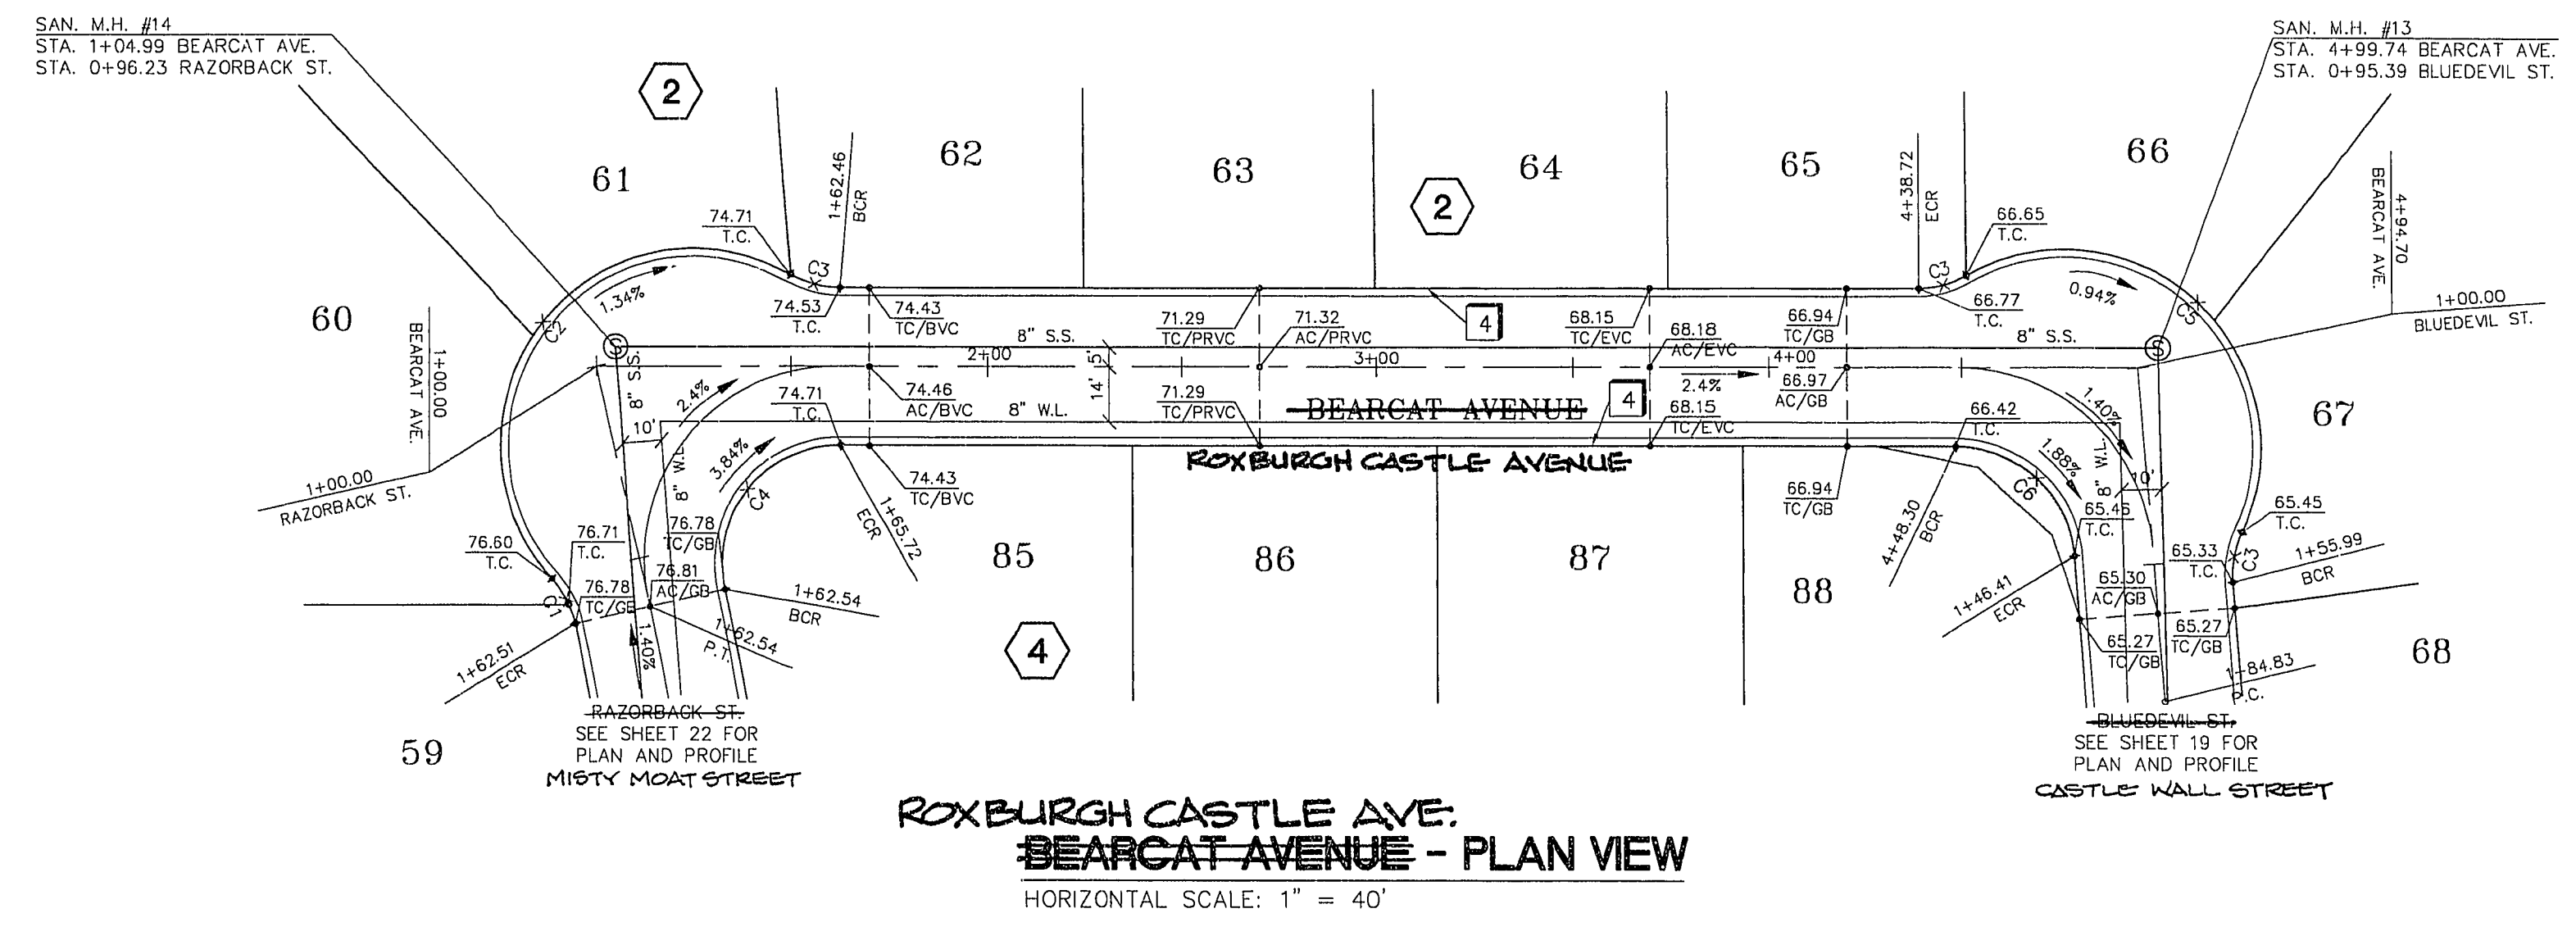


Avoid cutting underground utility lines. It's costly.
Call before you Dig
 1-800-227-2600

BACK OF CURB CURVE DATA

No.	RADIUS	DELTA	LENGTH	TANGENT
C1	25.00'	29°59'40"	13.09'	6.70'
C2	50.00'	162°37'20"	141.91'	327.17'
C3	25.00'	29°55'35"	13.06'	6.68'
C4	30.00'	102°41'54"	53.77'	37.51'
C5	50.00'	145°34'46"	127.04'	161.42'
C6	30.00'	85°43'36"	44.89'	27.84'



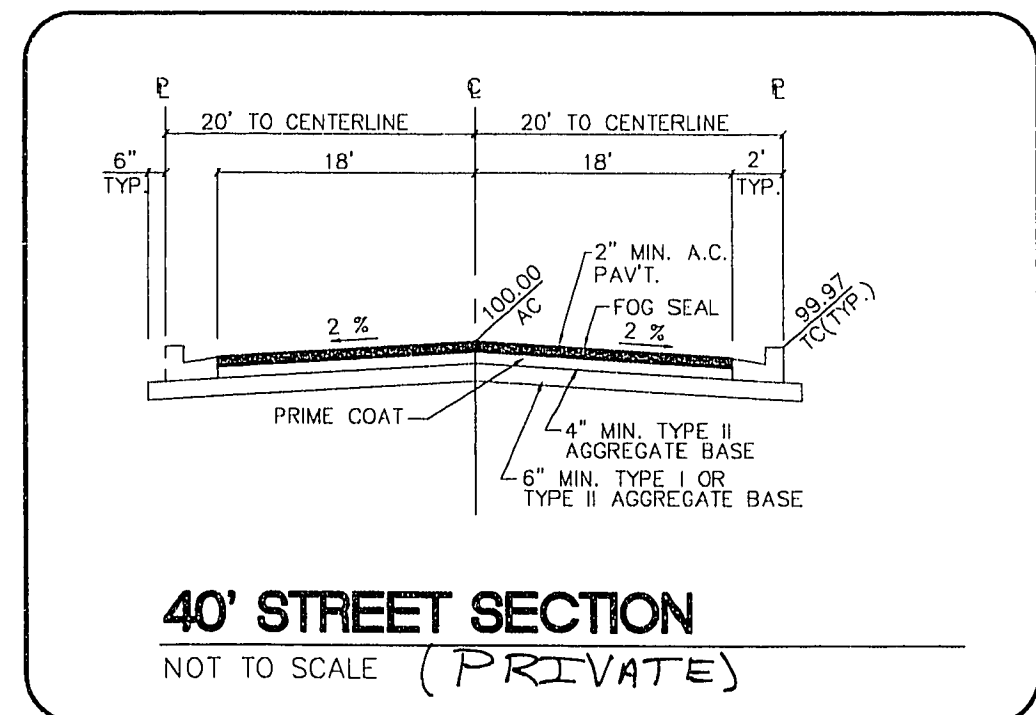


CONSTRUCTION NOTES

1. CONSTRUCT 8" CONCRETE CROSS GUTTER PER CLARK COUNTY AREA STANDARD DWG. NO. 228.
2. CONSTRUCT SIDEWALK RAMP (CASE 1) PER CLARK COUNTY AREA STANDARD DWG. NO. 235. (TRANSITION LENGTHS A & B SHOWN ON PLAN, Z=3.5')
3. CONSTRUCT 5' WIDE CONCRETE SIDEWALK PER CLARK COUNTY AREA STANDARD DWG. NO. 234.
4. CONSTRUCT "L" TYPE CURB & GUTTER PER CLARK COUNTY AREA STANDARD DWG. NO. 216.
5. INSTALL TEMPORARY END OF ROAD MARKERS PER SEC. 3C-4 MUTCD.

GENERAL NOTES

1. ADD 2500' TO PLAN VIEW ELEVATIONS.
2. ALL STATIONING IS CENTERLINE STATIONING UNLESS OTHERWISE NOTED.
3. SEWER LENGTHS ARE FROM CENTER OF MANHOLE TO CENTER OF MANHOLE.

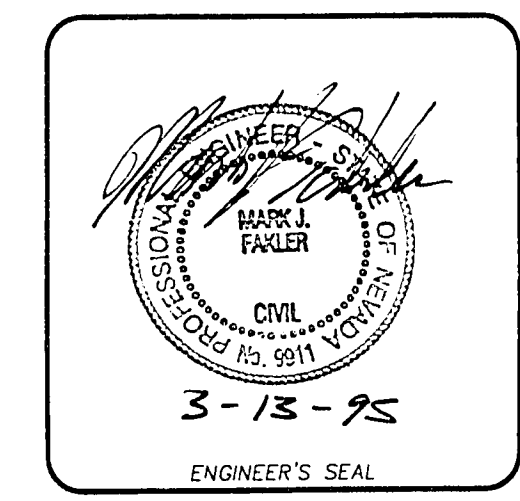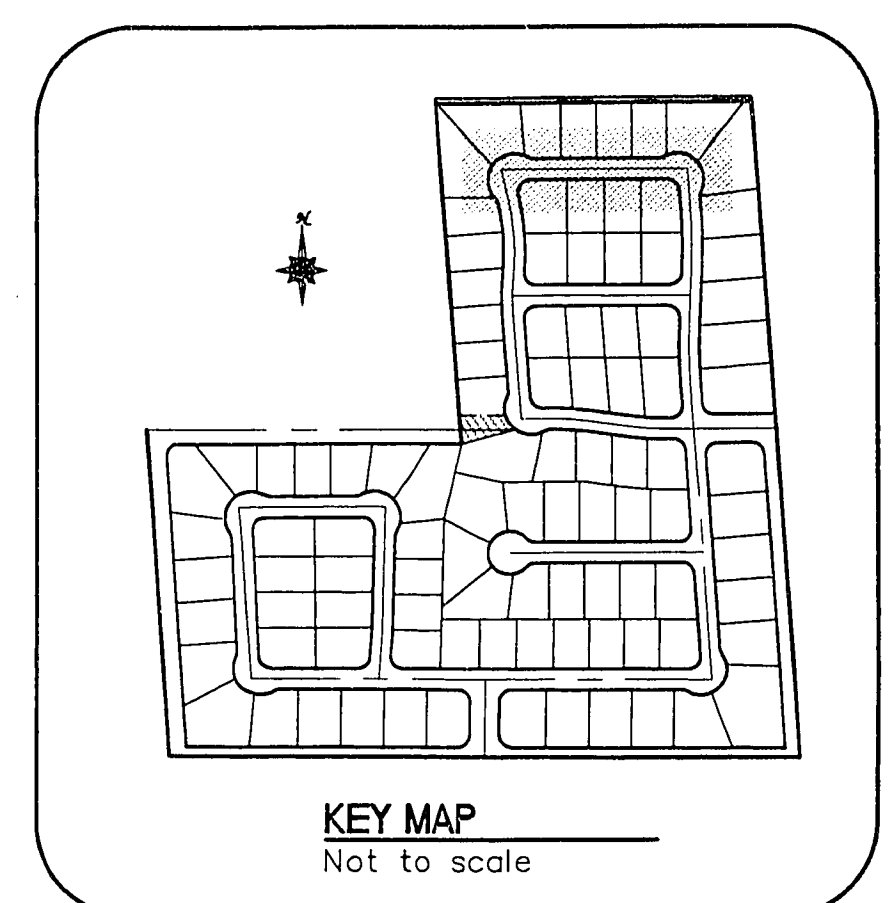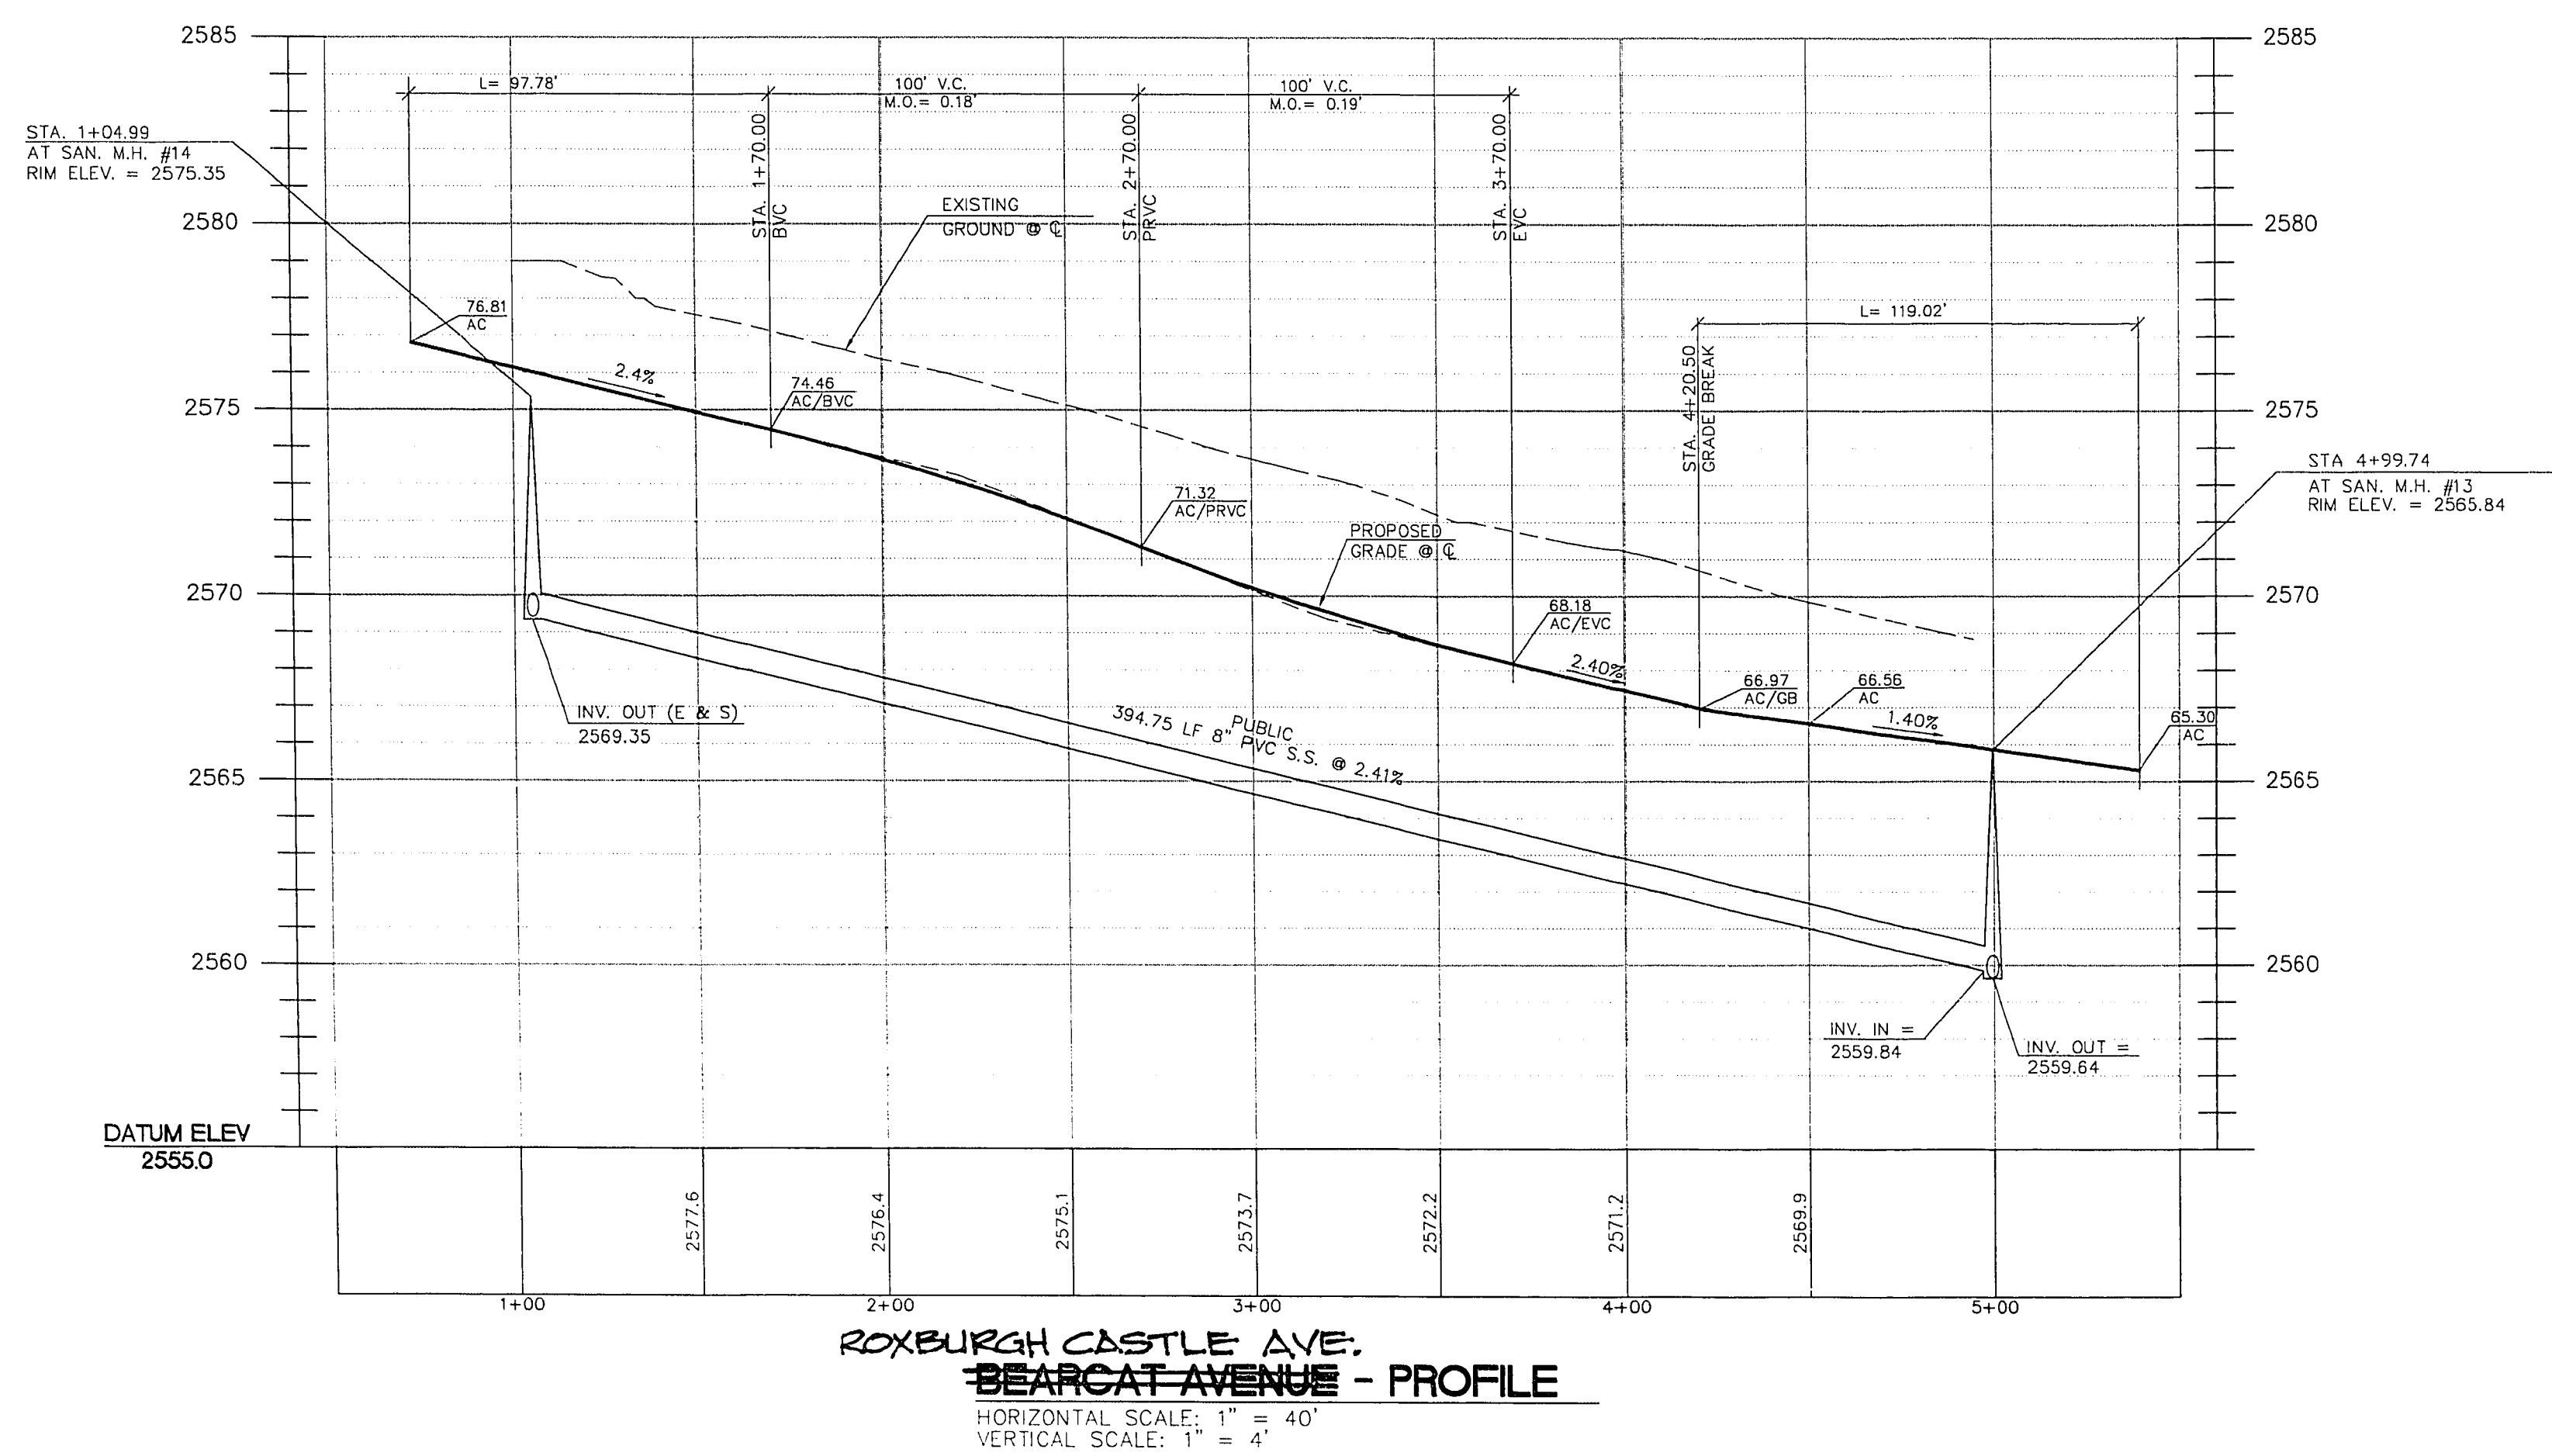

Date	Appr.	Date	Revisions	No.

Scale: 1" = 40'
 File No.: 707IMP
 Drawn by: pas
 Checked by: MIF
 Date: 02/07/95

Job Number: 7174.707
 Sheet Number: 21 OF 25

PLANT DATE: 02/07/95

POST, BUCKLEY, SCHUH & JERNIGAN
 ENGINEERING, PLANNING, SURVEYING, CONSTRUCTION SERVICES
 600 West Charleston Blvd., Suite 400, Las Vegas, Nevada 89102
 Phone: 702/735-0644, Fax: 702/735-7258

CASTLE GATE

ROXBURGH CASTLE AVE. BEARCAT AVENUE
 PLAN AND PROFILE