


I, L. A. Harris, A DULY REGISTERED ENGINEER AND LAND SURVEYOR, do hereby certify that this map truly and correctly represents the results of a survey made under my supervision and completed on the 27th day of May, 1955 of and for the City of Las Vegas, Nevada.

L. A. Harris  
REGISTERED ENGINEER AND LAND SURVEYOR  
NEVADA R.E. 24

APPROVED this 27th day of July, 1955

James E. Wade  
CITY ENGINEER  
NEVADA R.E. 280

SCALE

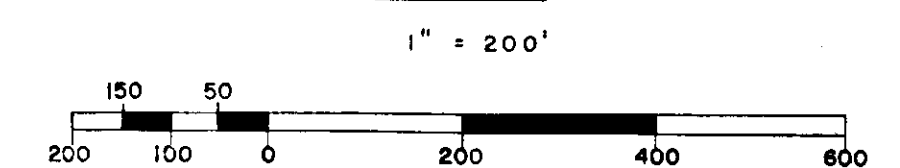

Basis of Bearings is C 1/4 Sec. line, Sec. 21, T. 20 S., R. 61 E., M.D.B. & M., as recorded in File 1 of Surveys, Page 77, on file in the Office of the County Recorder, Clark County, Nevada.

- MONUMENTS FOUND
- MONUMENTS SET

53093

*City of Las Vegas*  
7-28-55 2:04 P.M.  
FILE 5 30

CLARK COUNTY  
PAID  
DR MK

*City of Las Vegas*  
JUL 20 1955

CITY OF LAS VEGAS, NEVADA ENGINEERING DEPT.			
Boundary Survey of the S 1/2, SW 1/4, SE 1/4 and the S 1/2, N 1/2, SW 1/4, SE 1/4, of Section 21, T. 20 S., R. 61 E. Annexed to the City of Las Vegas, Nevada under Ord. No. 655			
DRAWN BY: <u>J. Stark</u>	CHECKED BY: <u>J. E. S.</u>	APPROVED:	FIELD BOOK REF.
DATE <u>7-6-55</u>	DATE <u>7-27-55</u>	DATE <u>7-27-55</u>	<u>55-1 P. 96</u>

11 053-12  
File - 5 30