


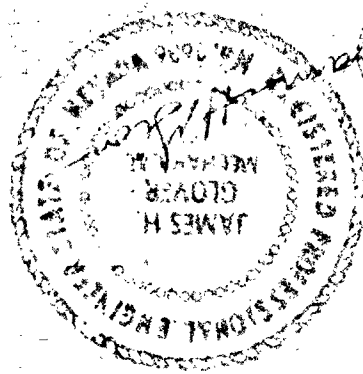


sheet no. M-1
checked by P54
drawn by DAM
date 7/19/81

job no.
sheet title:
SMOKE REMOVAL SYSTEM PLAN
FOR: CITY OF LAS VEGAS
JAIL ANNEX RENOVATION

GRUZEN & SILVERMAN
KEITH FARRIS & ASSOCIATES
architecture planning interiors
844 E. Sahara Las Vegas, NV (702) 737-7444

JAMES H. GLOVER
AND ASSOCIATES
consulting engineers
Las Vegas, Nevada

SMOKE REMOVAL SYSTEM PLAN
SCALE: 1/8"=1'-0"

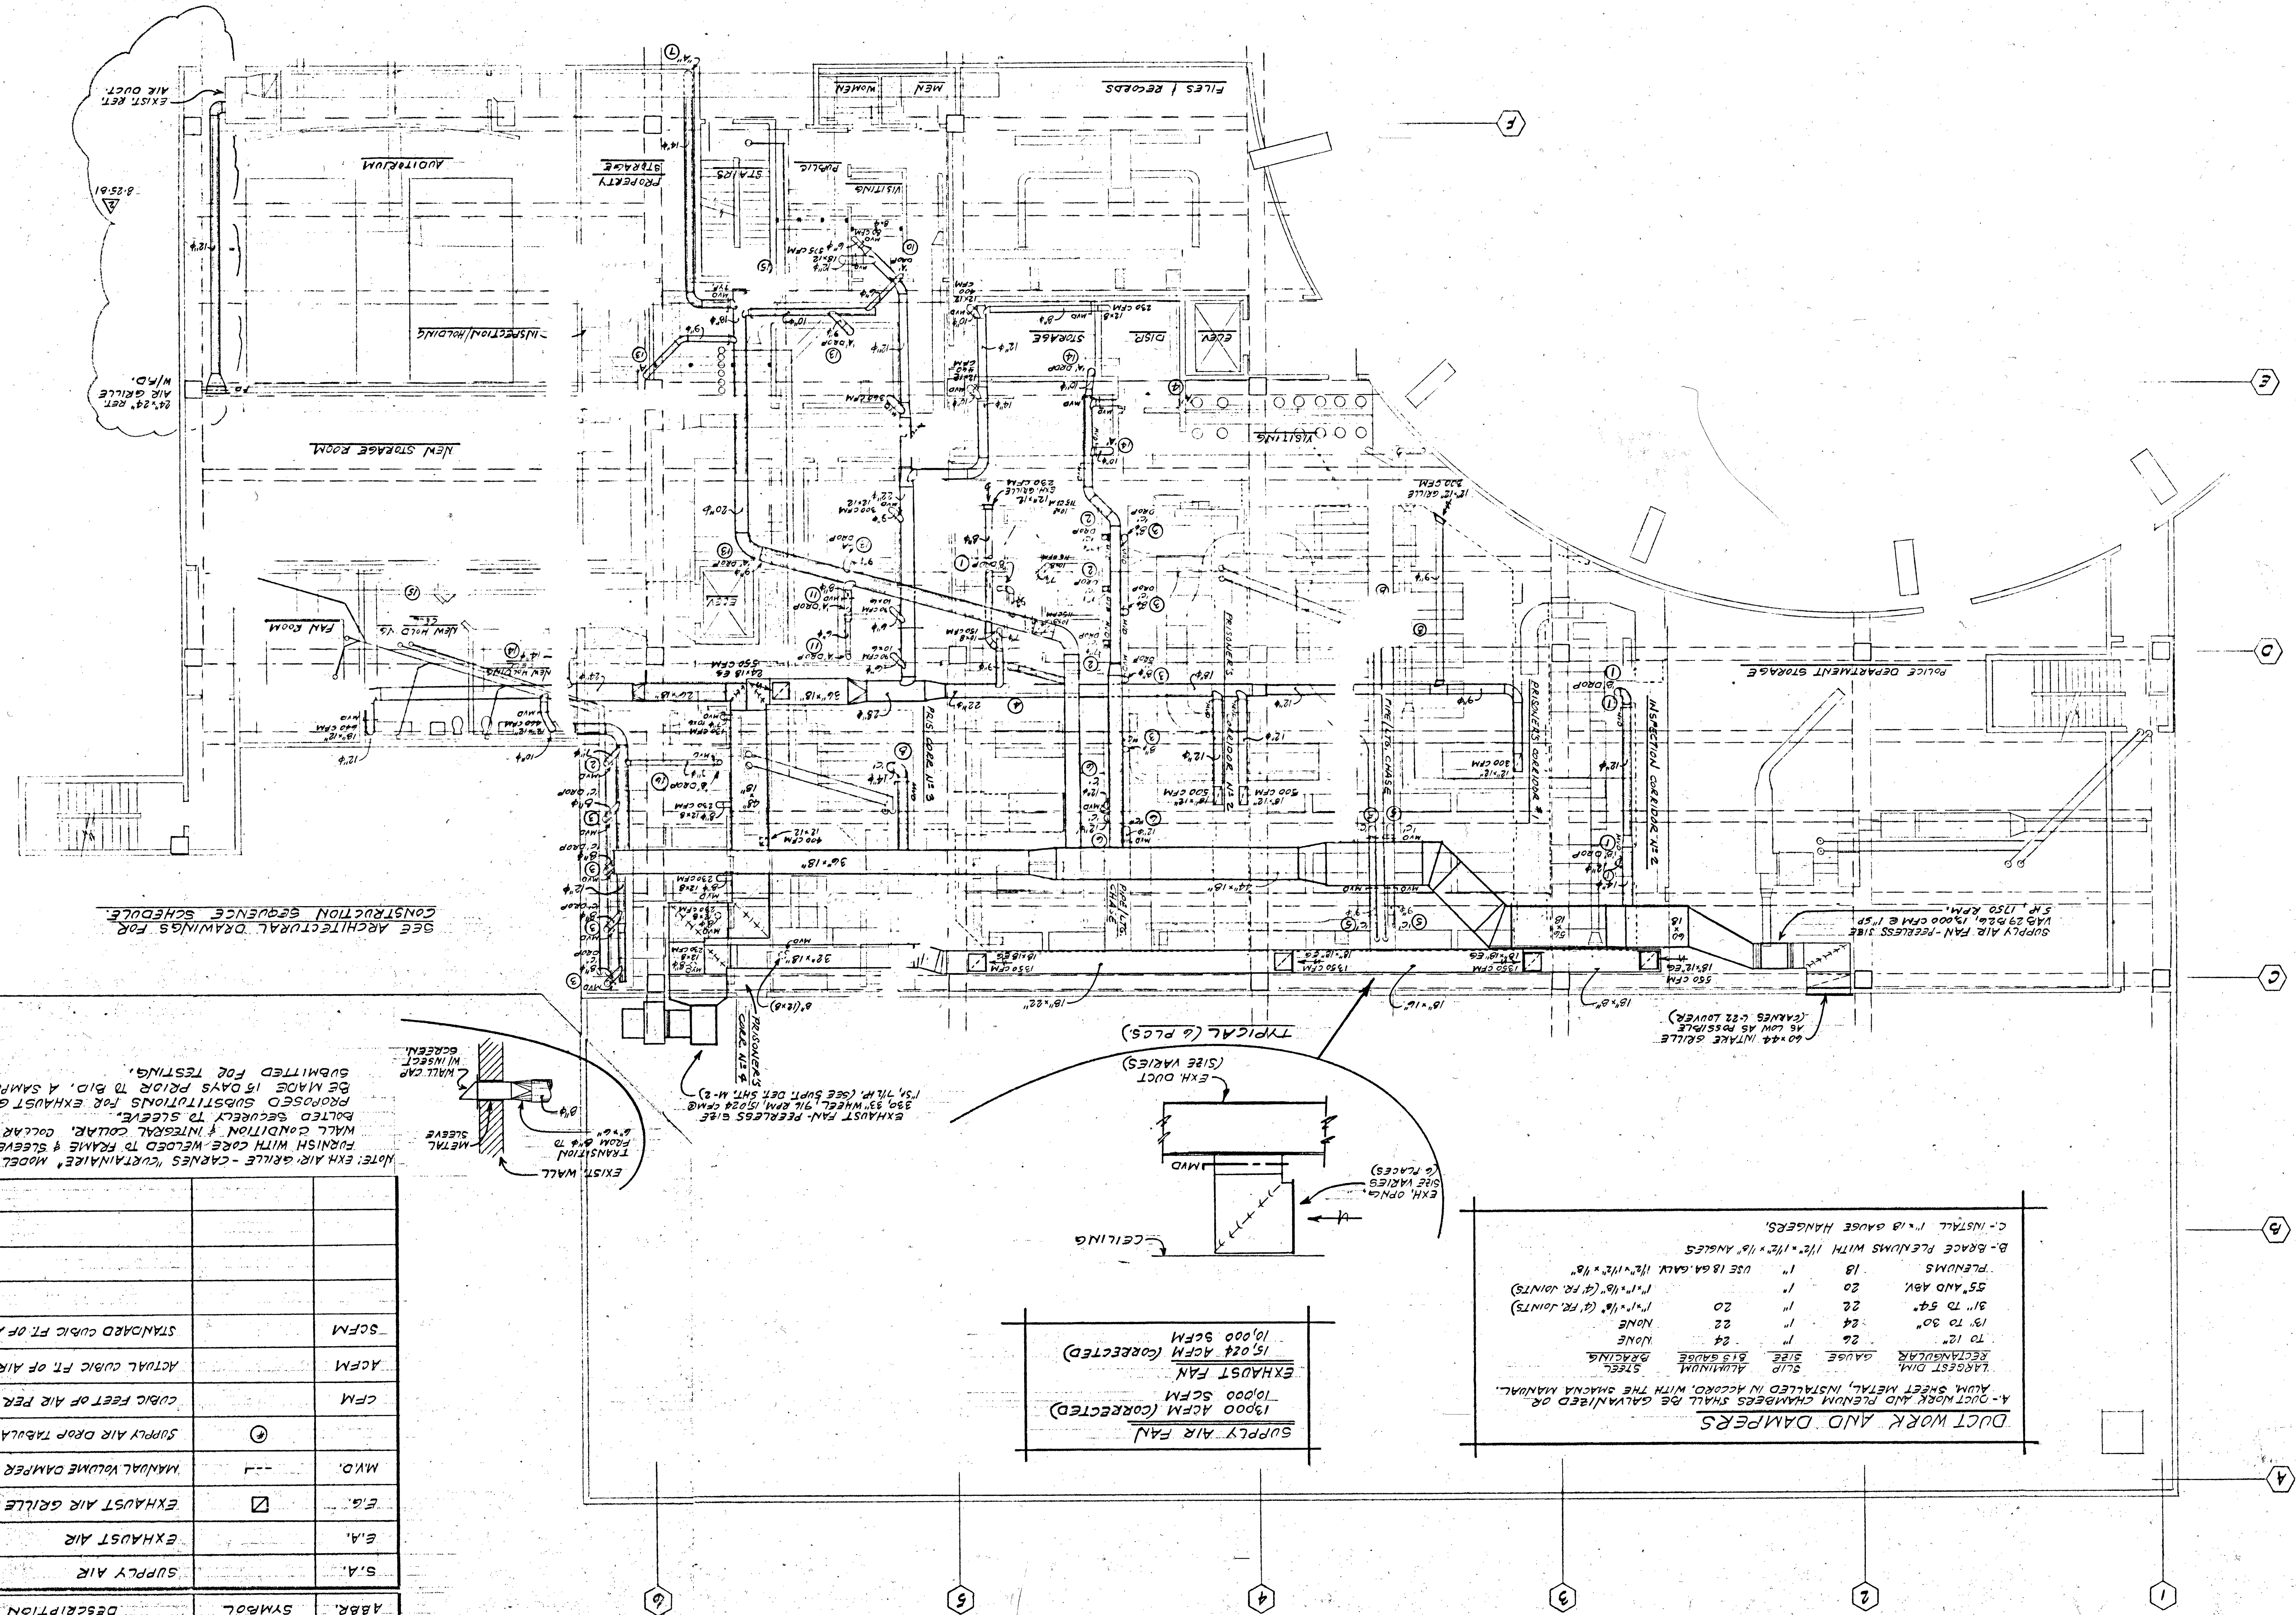

SEE ARCHITECTURAL DRAWINGS FOR
CONSTRUCTION SEQUENCE SCHEDULE.

NOTE: EXH. AIR GRILLE - CARNES 'UNSTAINABLE' MODEL 55CD-40.
FURNISH WITH CORE WELDED TO FRAME & SLEEVE TO MATCH
WALL CONDITION & INTEGRAL COLLAR. COLLAR SHALL BE
BOLTED SECURELY TO SLEEVE.
PROPOSED SUBSTITUTIONS FOR EXHAUST GRILLES SHALL
BE MADE 15 DAYS PRIOR TO BID. A SAMPLE SHALL BE
SUBMITTED FOR TESTING.

ABBR.	SYMBOL	DESCRIPTION
S.A.		SUPPLY AIR
E.A.		EXHAUST AIR
E.G.		EXHAUST AIR GRILLE (SEE NOTE BELOW)
M.V.D.		MANUAL VOLUME DAMPER W/ LOCKING QUAD.
CFM		CUBIC FEET OF AIR PER MINUTE
ACFM		ACTUAL CUBIC FT. OF AIR PER MIN.
SCFM		STANDARD CUBIC FT. OF AIR PER MIN.

DUCT WORK AND DAMPERS			
B- BRACE PLENUMS WITH 1/2" x 1/2" x 1/8" ANGLES			
C- INSTALL 1" x 1/8" GAUGE HANGERS.			

SUPPLY AIR FAN
10,000 SCFM