


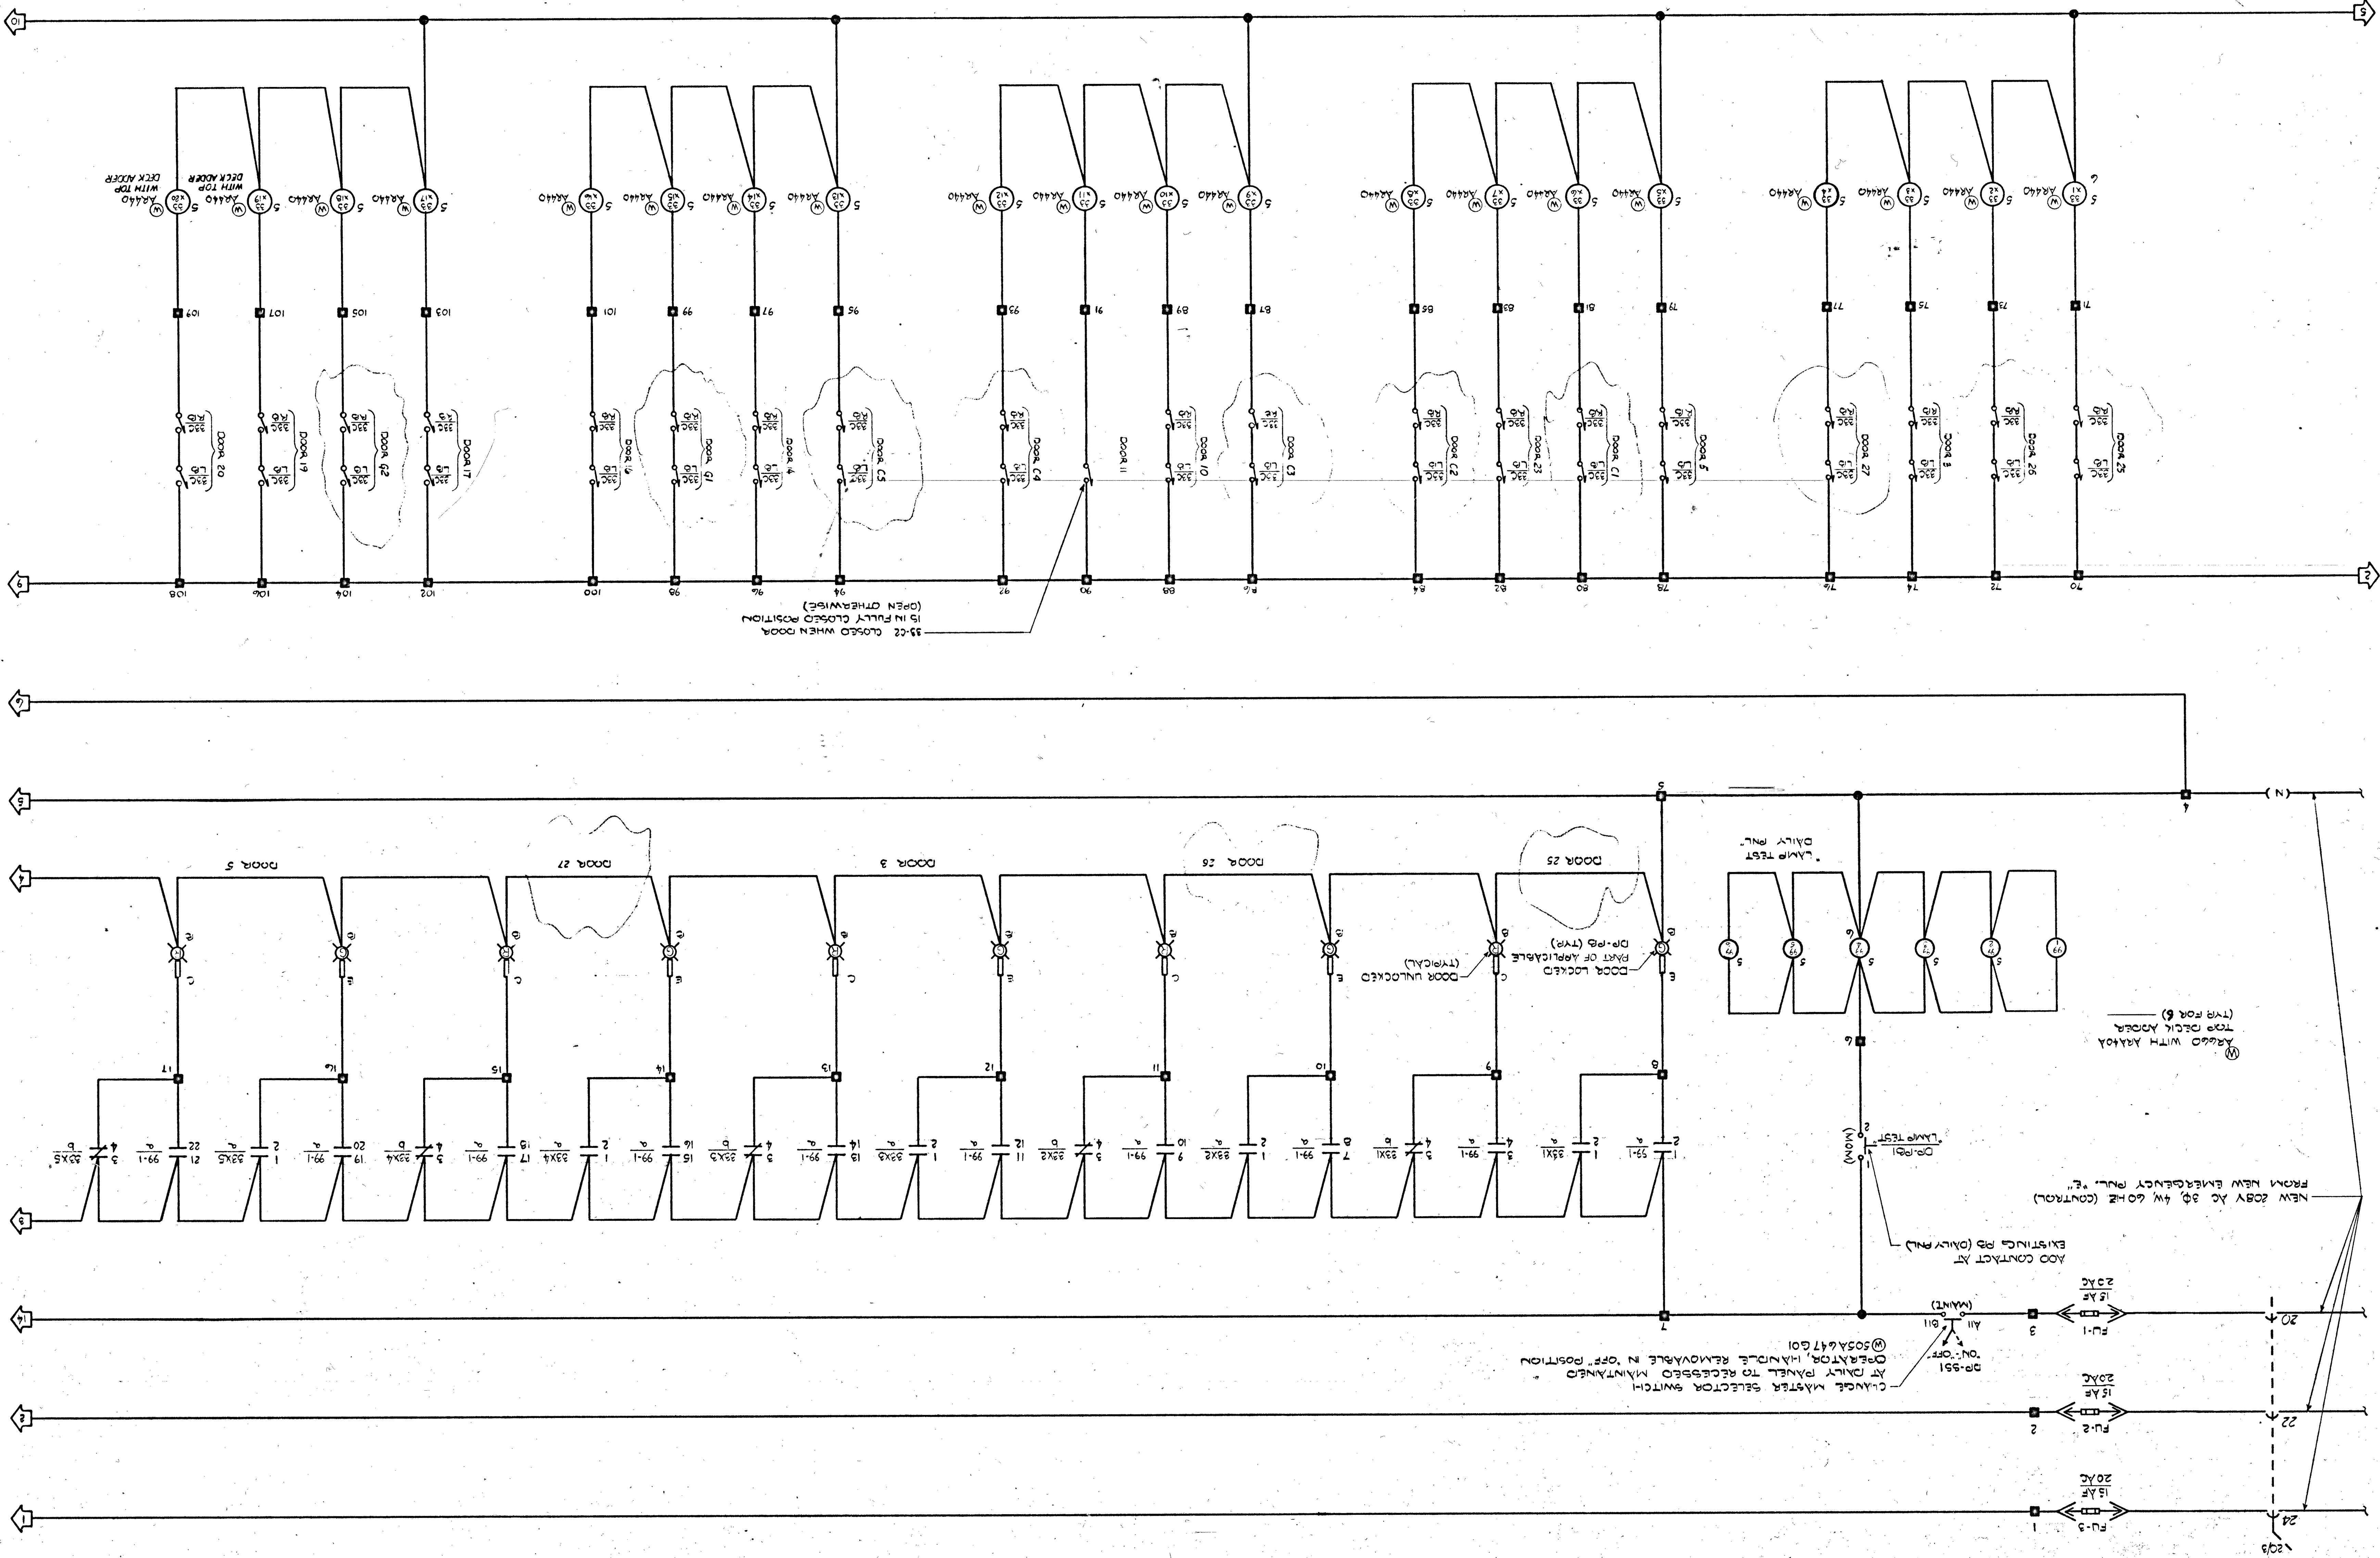

LEGEND

- TERMINAL AT RELAY PANEL
- 33C- LIMIT SWITCH ON DOOR, LOCK "L" (LATCH NOT) & OR "R" (ROLLER ROLL) CLOSURE WITH DOOR FULLY CLOSED OR AS OTHERWISE NOTED
- 42- RUNNING CONTACTOR FOR EMERGENCY PANEL DOOR OPERATION
- 33X- MULTIPLE LIMIT SWITCH INPUT
- 99- LAMP TEST RELAY
- PO- MOUNTED PUSHBUTTON SWITCH
- AF- ASSOCIATED WITH CONTROL FOR NEW SMOKE REMOVAL FAN SYSTEM
- K- MOVEMENTARY CONTACTOR FOR DAILY PANEL DOOR OPERATION



sheet no. _____
checked by _____
date _____
job no. _____

sheet title:
ELEMENTARY DIAGRAMS
FOR: CITY OF LAS VEGAS
JAIL ANNEX RENOVATION

GRUZEN & SILVERMAN AND JAMES H. GLOVER
KEITH FARRIS & ASSOCIATES AND ASSOCIATES
architecture planning interiors
844 E. Sahara Las Vegas, NV (702) 737-7444
Las Vegas, Nevada