



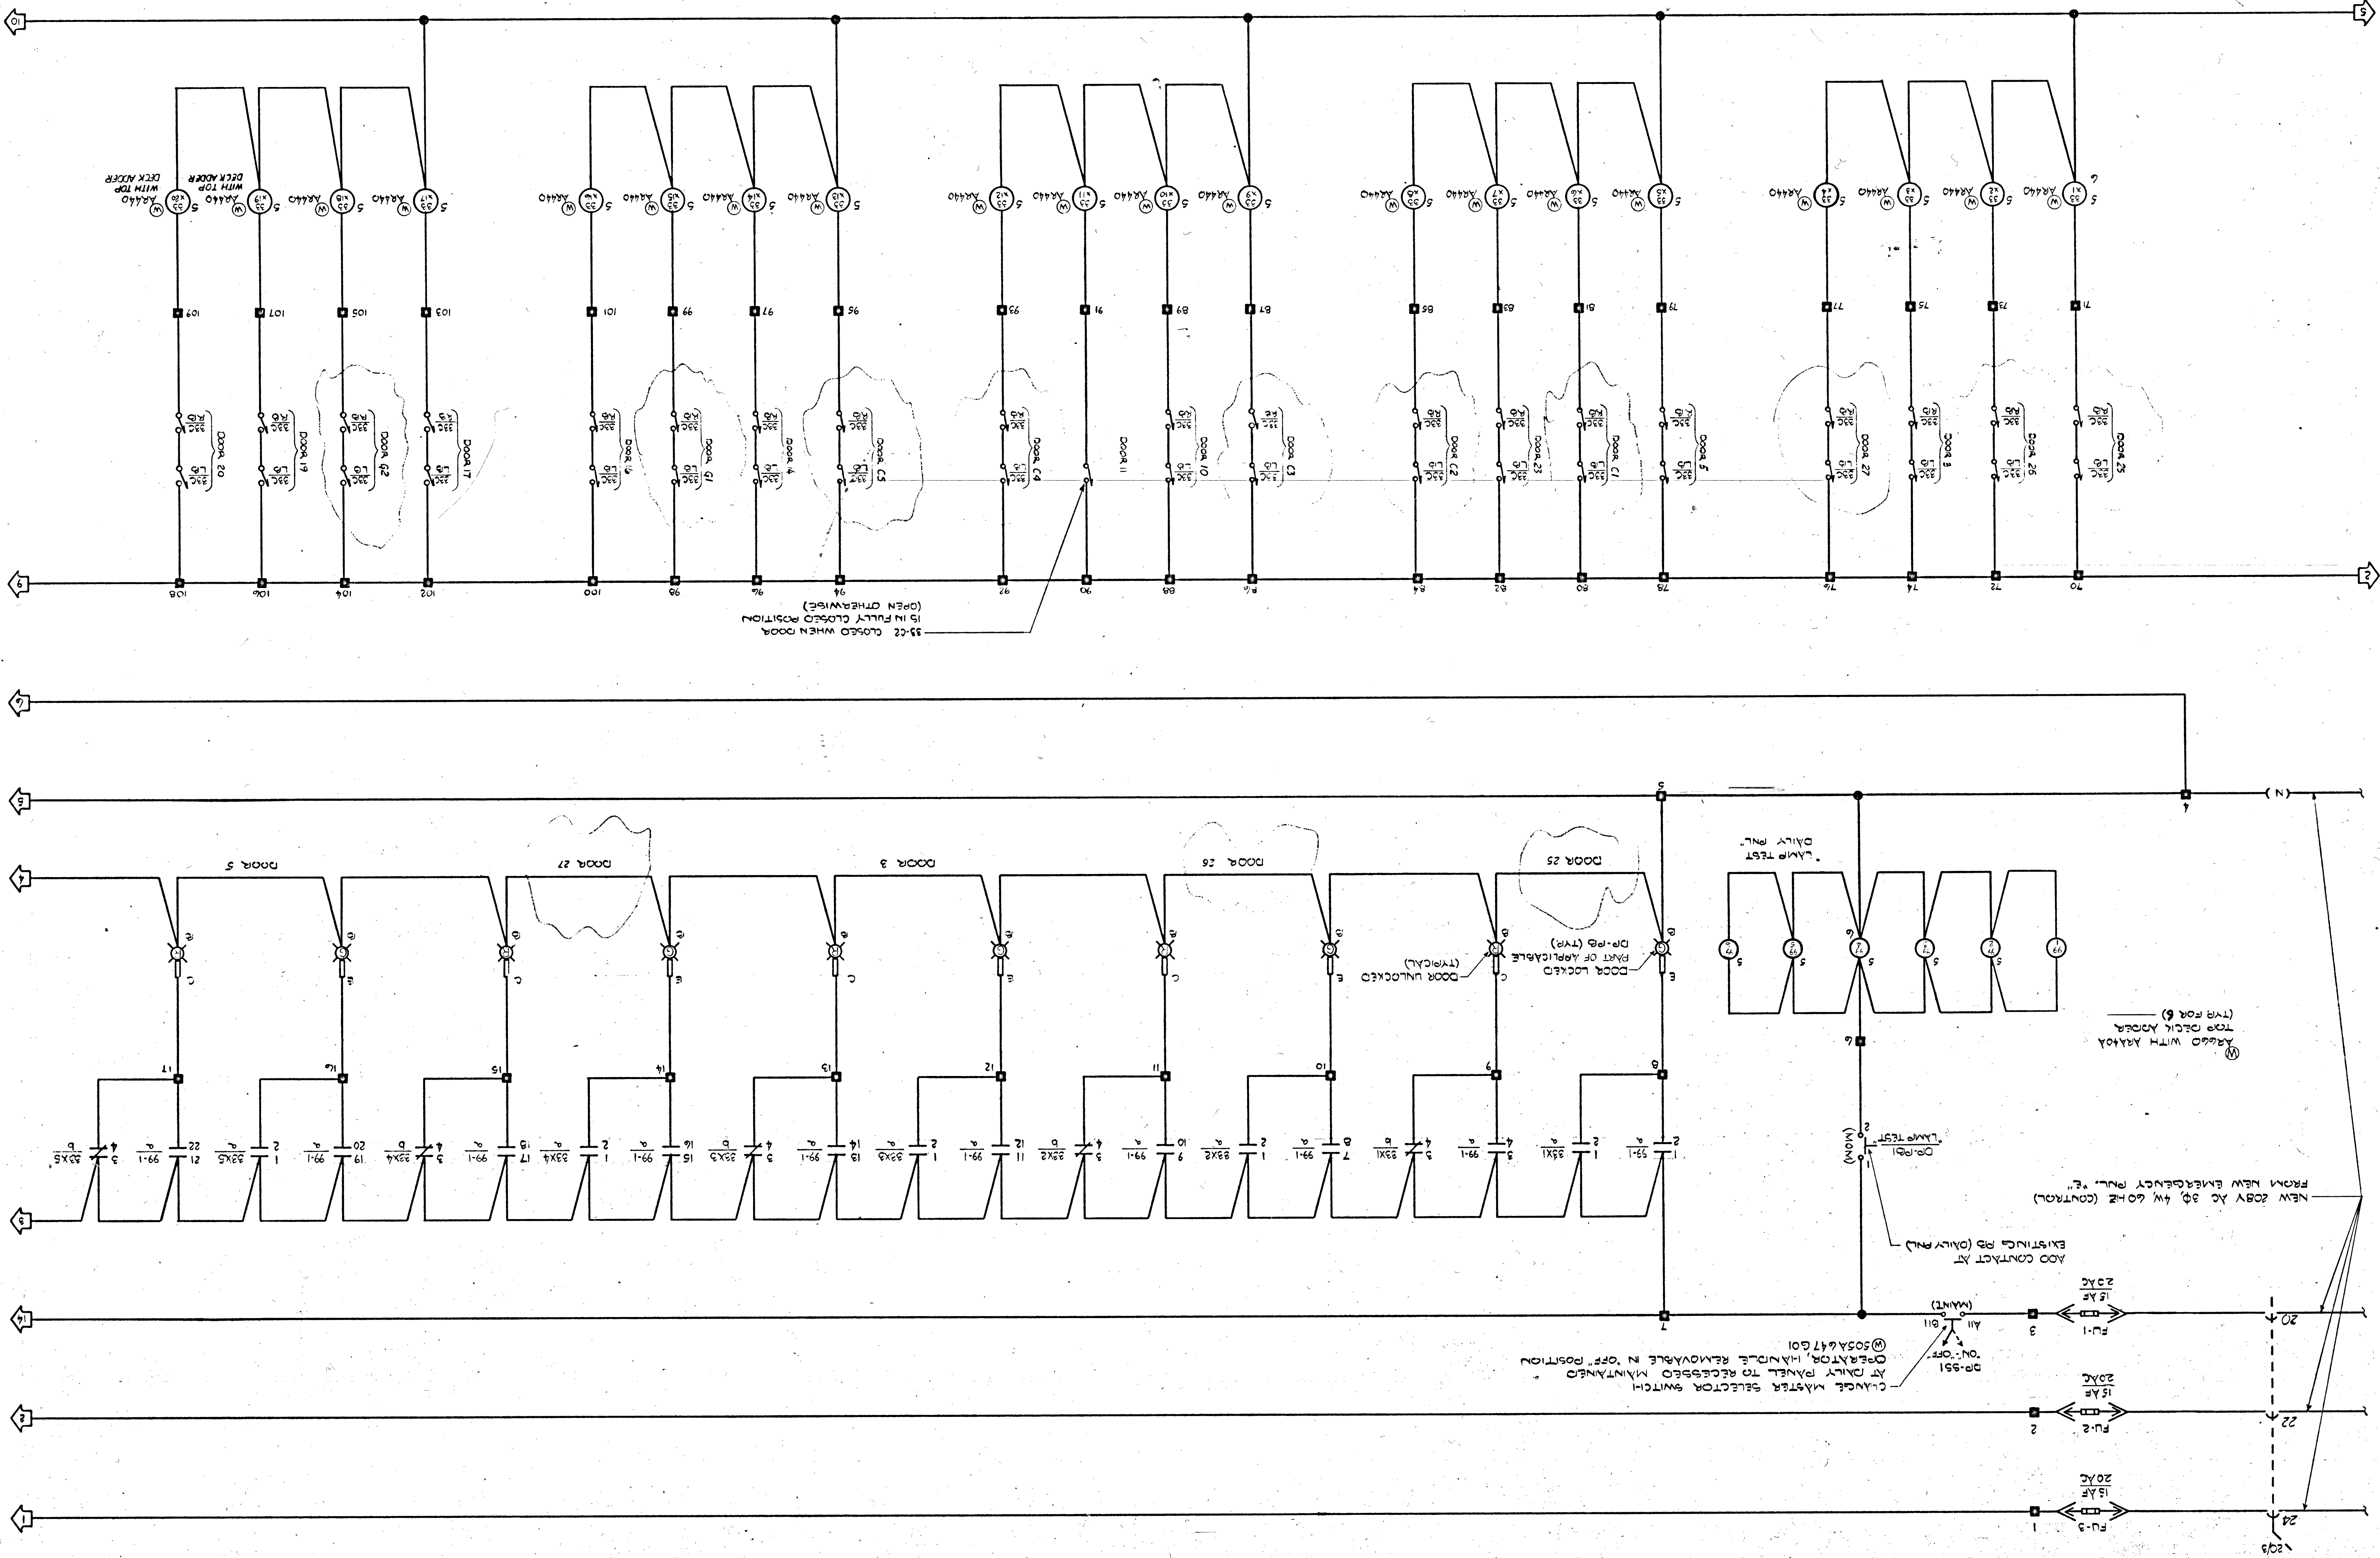

LEGEND

- TERMINAL AT RELAY PANEL
- 33C- LIMIT SWITCH ON DOOR, LOCK "L" (LATCH BOLT) & OR "R" (ROLLER BOLT) CLOSED WITH DOOR FULLY CLOSED OR AS OTHERWISE NOTED
- 42- RUNNING CONTACTOR FOR EMERGENCY PANEL DOOR OPERATION
- 33X- MULTIPLE LIMIT SWITCH INPUT
- 99- LAMP TEST RELAY
- PO- MOUNTED PUSHBUTTON SWITCH
- AF- ASSOCIATED WITH CONTROL FOR NEW SMOKE REMOVAL FAN SYSTEM
- K- MOVEMENTARY CONTACTOR FOR DAILY PANEL DOOR OPERATION

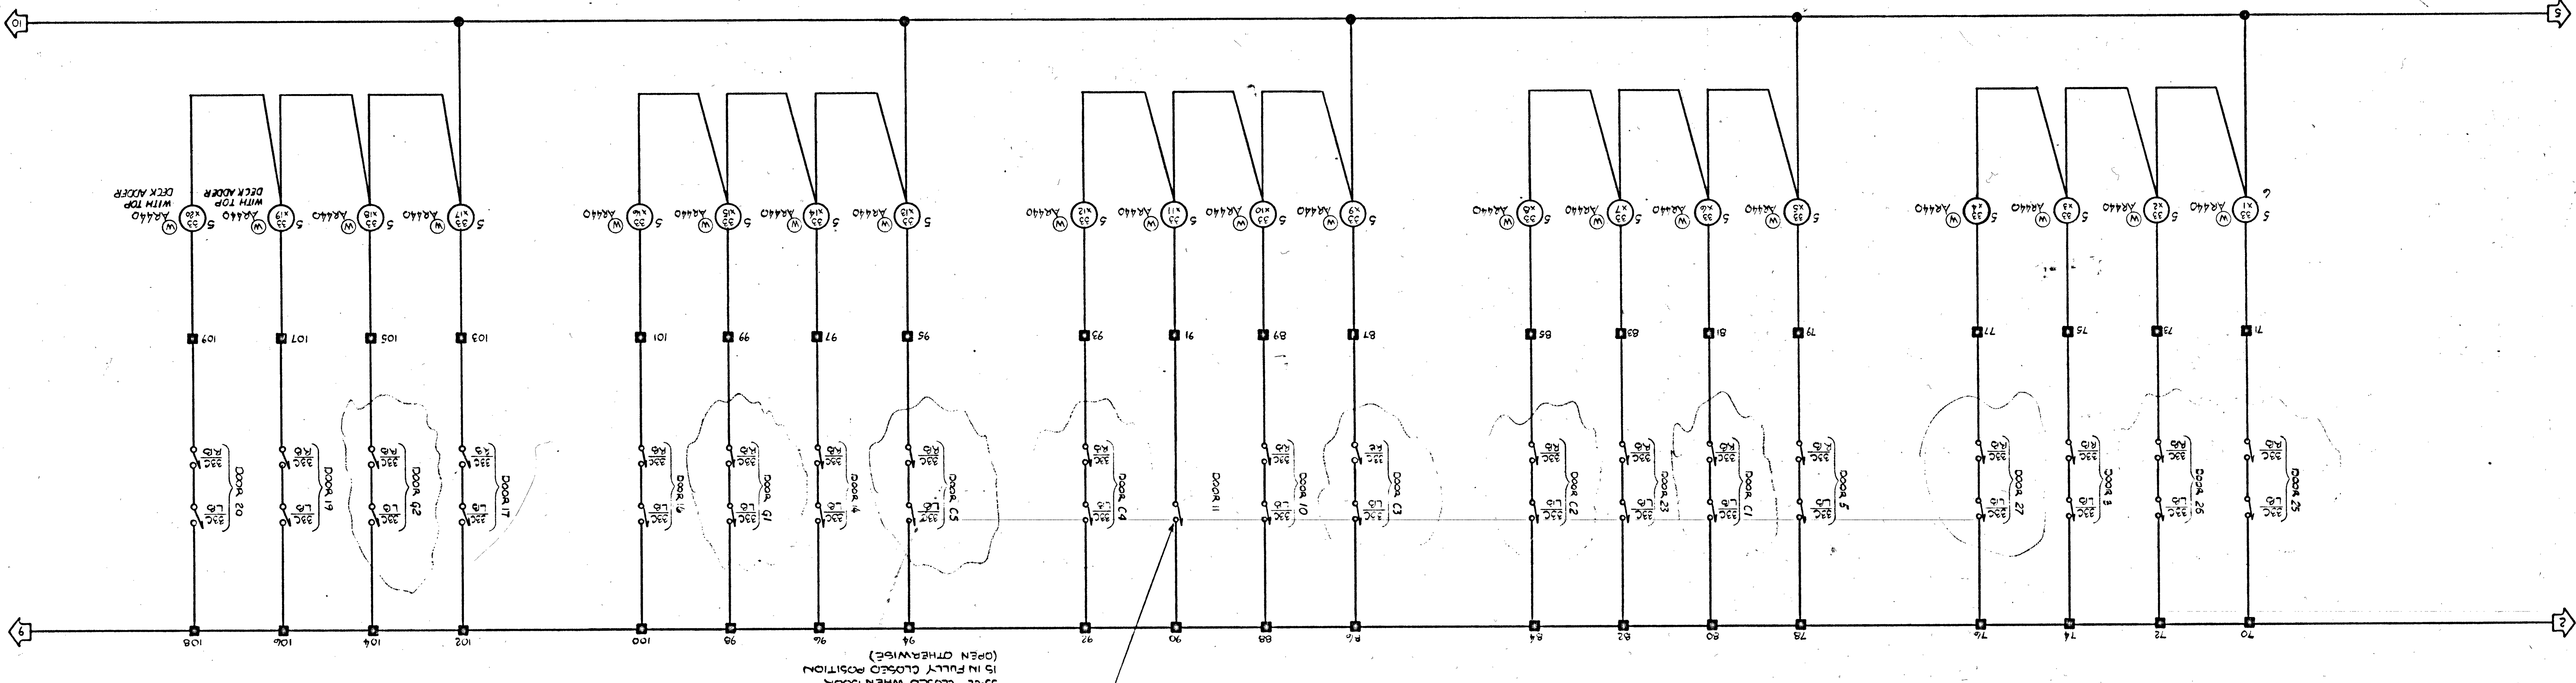

sheet title: ELEMENTARY DIAGRAMS
FOR: CITY OF LAS VEGAS JAIL ANNEX RENOVATION
architect: GRUZEN & SILVERMAN AND KEITH FARRIS & ASSOCIATES
interiors: JAMES H. GLOVER AND ASSOCIATES consulting engineers
las vegas, nevada
job no. 01098
date 5/26/81
drawn by MATT
checked by
sheet no.