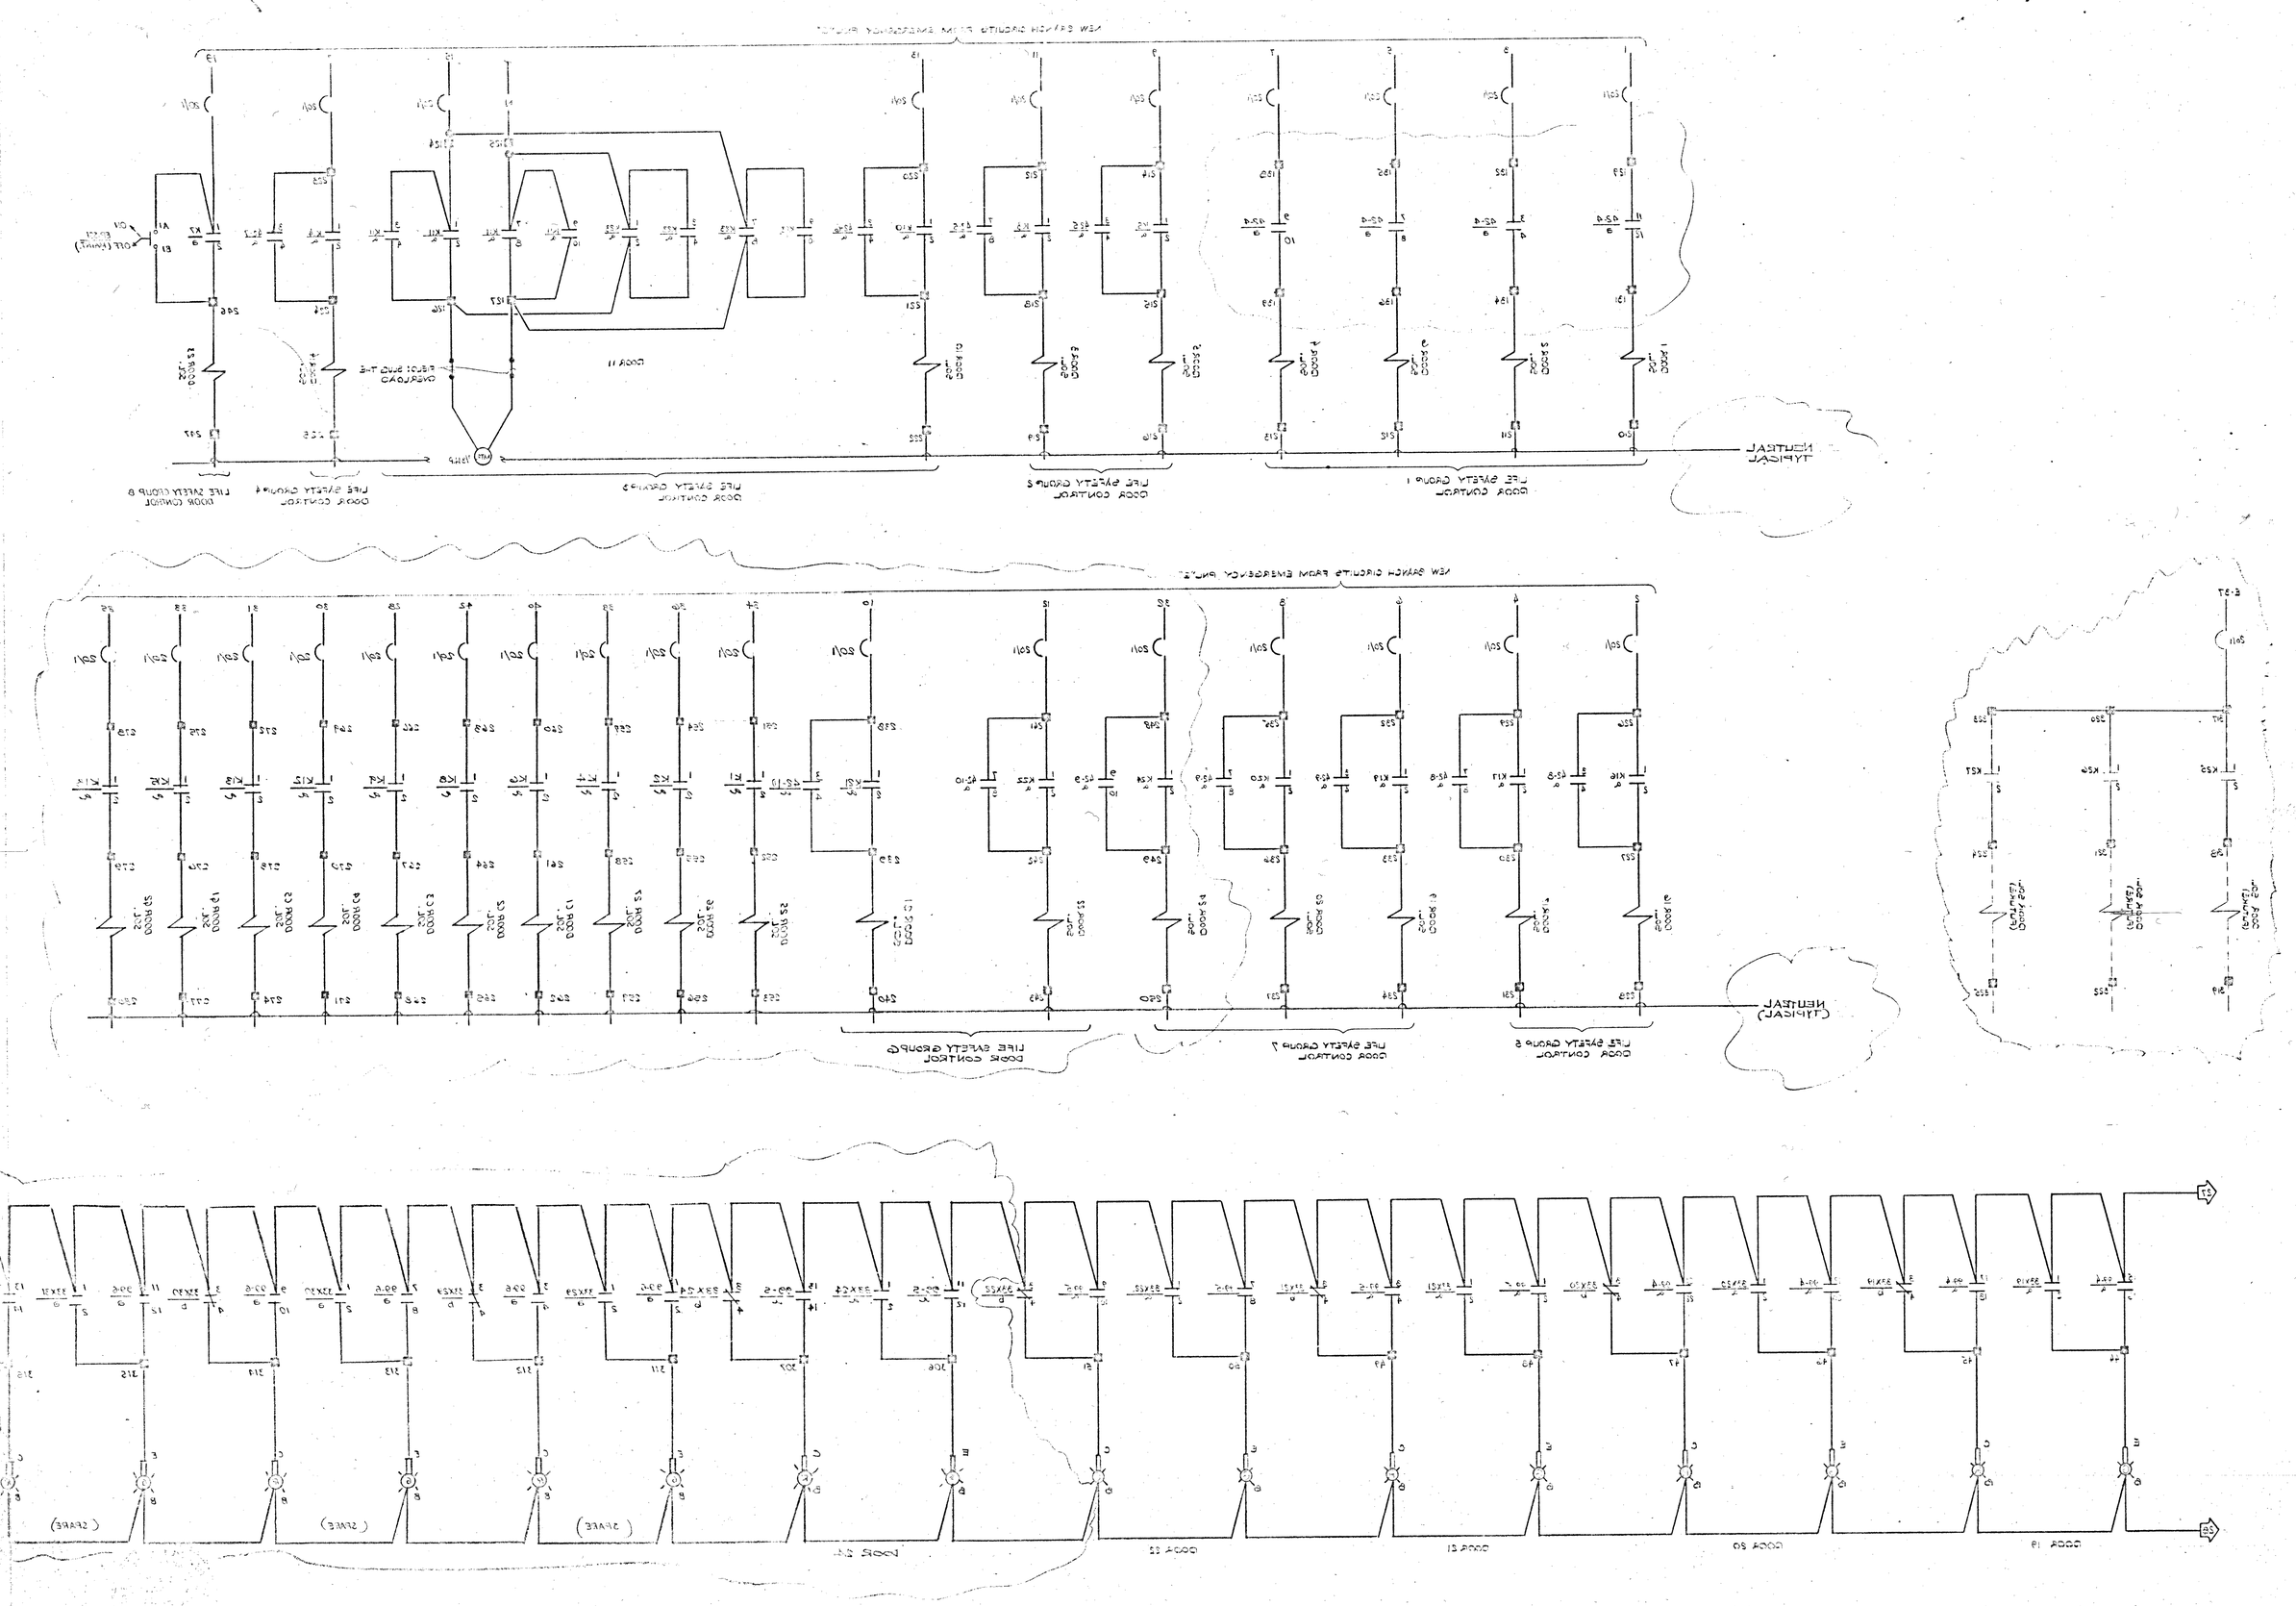
NEW BRANCH CIRCUITS FROM EMERGENCY PANEL
LIFE SAFETY GROUP 1
DOOR CONTROL
LIFE SAFETY GROUP 2
DOOR CONTROL
LIFE SAFETY GROUP 3
DOOR CONTROL
LIFE SAFETY GROUP 4
DOOR CONTROL
LIFE SAFETY GROUP 8
DOOR CONTROL
NEUTRAL
TYPICAL
DOOR 11
OFF (WHITE)
ON
NEW BRANCH CIRCUITS FROM EMERGENCY PANEL
LIFE SAFETY GROUP 5
DOOR CONTROL
LIFE SAFETY GROUP 6
DOOR CONTROL
LIFE SAFETY GROUP 7
DOOR CONTROL
LIFE SAFETY GROUP 8
DOOR CONTROL
NEUTRAL
(TYPICAL)
DOOR 19
DOOR 20
DOOR 21
DOOR 22
DOOR 23
(SPARE)
(SPARE)
(SPARE)