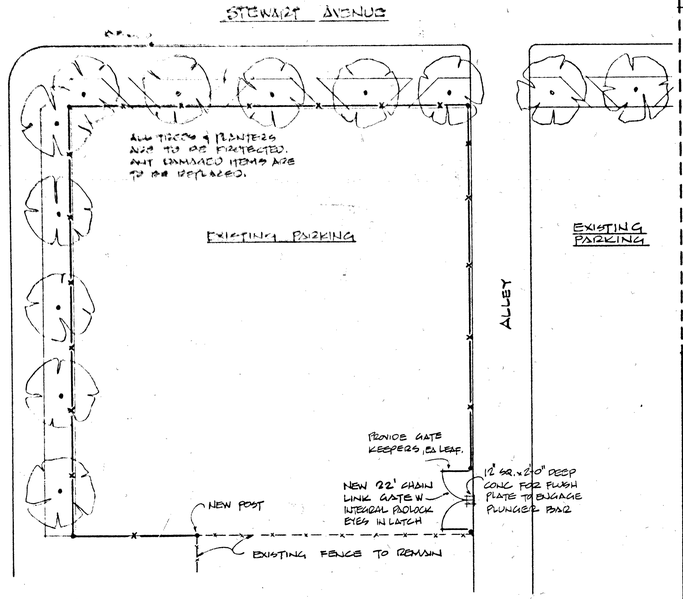

NEW CHAIN LINK FENCE @ EXISTING CITY PARKING LOT

CORNER OF 4TH STREET & STEWART AVENUE — NO SCALE

CHAIN LINK FENCE

FABRIC: SHALL BE CYCLONE CHAIN LINK FENCE AS MFG. BY UNITED STATES STEEL CORP. OR APPROVED EQUAL.

FABRIC: SHALL BE ONE PIECE, 2.0 OUNCE ZINC COATED PER ASTM A 392. 2" MESH 9 GA. OVER KNUCKLED AT BOTTOM AND TWISTED & BARBED AT TOP.

FRAMEWORK: CYCLONE COLD FORMED SECTIONS FOR END, CORNER, PULL, LINE POSTS (STANDARD), GATE POSTS TOP & RAIL, HEAVY GALVANIZED - 2.0 OUNCES ZINC / S.F., ASTM A120 OR 123

ACCESSORIES: GALVANIZED ASTM A-153.

GATE FRAMES: MINIMUM 2" O.D. STRUCTURAL GRADE, GALVANIZED ASTM A-120.

GATE HARDWARE: MANUFACTURERS STANDARD, HEAVY GALVANIZED

INSTALLATION: COMPLY WITH MFGR'S. RECOMMENDATIONS.

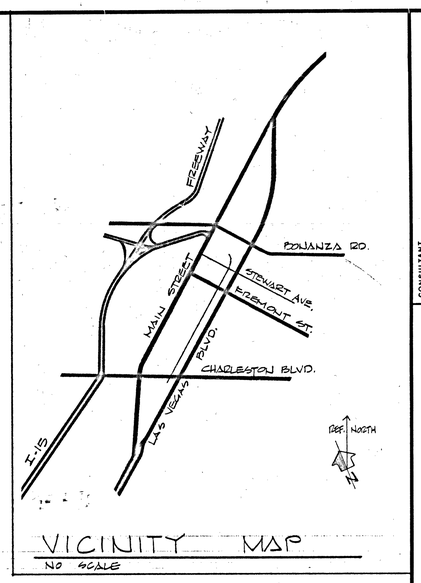

VICINITY MAP

NO SCALE

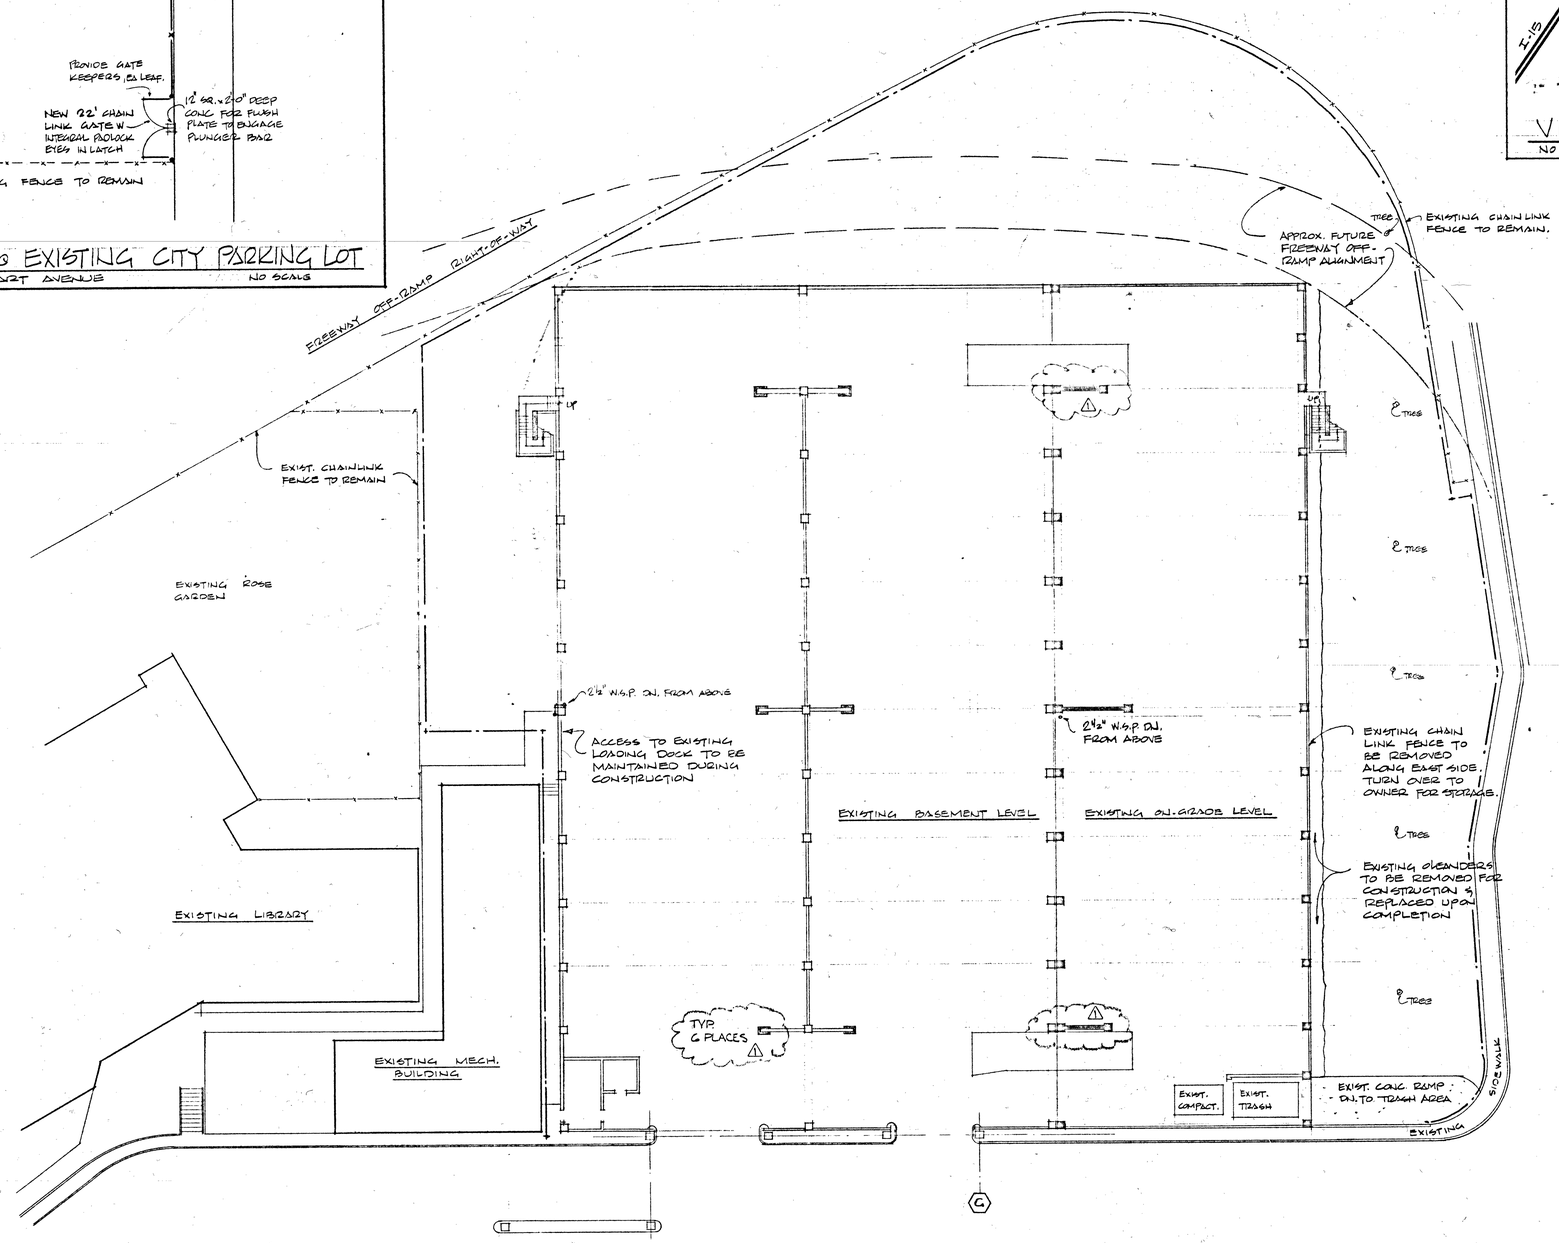

SITE PLAN

1/16" = 1'-0"

NOTES: VERIFY EXISTENCE & LOCATION OF ALL TREES. EXISTING PLANTING TO BE PROTECTED AS POSSIBLE COORDINATE W/ ENGINEER & OWNER.

PROVIDE CONSTRUCTION FENCE AS DIRECTED BY ENGINEER. COORDINATE W/ ENGINEER & OWNER.

LIMITS OF CONSTRUCTION

REF. NORTH — NORTH

SC. 1/16" = 1'-0"

ISSUE OR REVISION	DATE	DESCRIPTION
1	12-14-78	AS-BUILT

CONSULTANT

MARTIN & CASHDAN
STRUCTURAL ENGINEERS
844 EAST SAHARA AVENUE
LAS VEGAS NEVADA 89104
TELEPHONE (702) 735-7166

JOB TITLE: PARKING GARAGE ADDITION
LAS VEGAS CITY HALL
400 STEWART AVENUE LAS VEGAS, NEVADA

SHEET TITLE: SITE PLAN & VICINITY MAP

JOB NO.	77079
DATE	10-21-77
ENGINEER	
DRAWN	HDG
CHECKED	
SHEET NO.	C-1

PRINTED ON DIETERICH-POST 1020-10

77079