



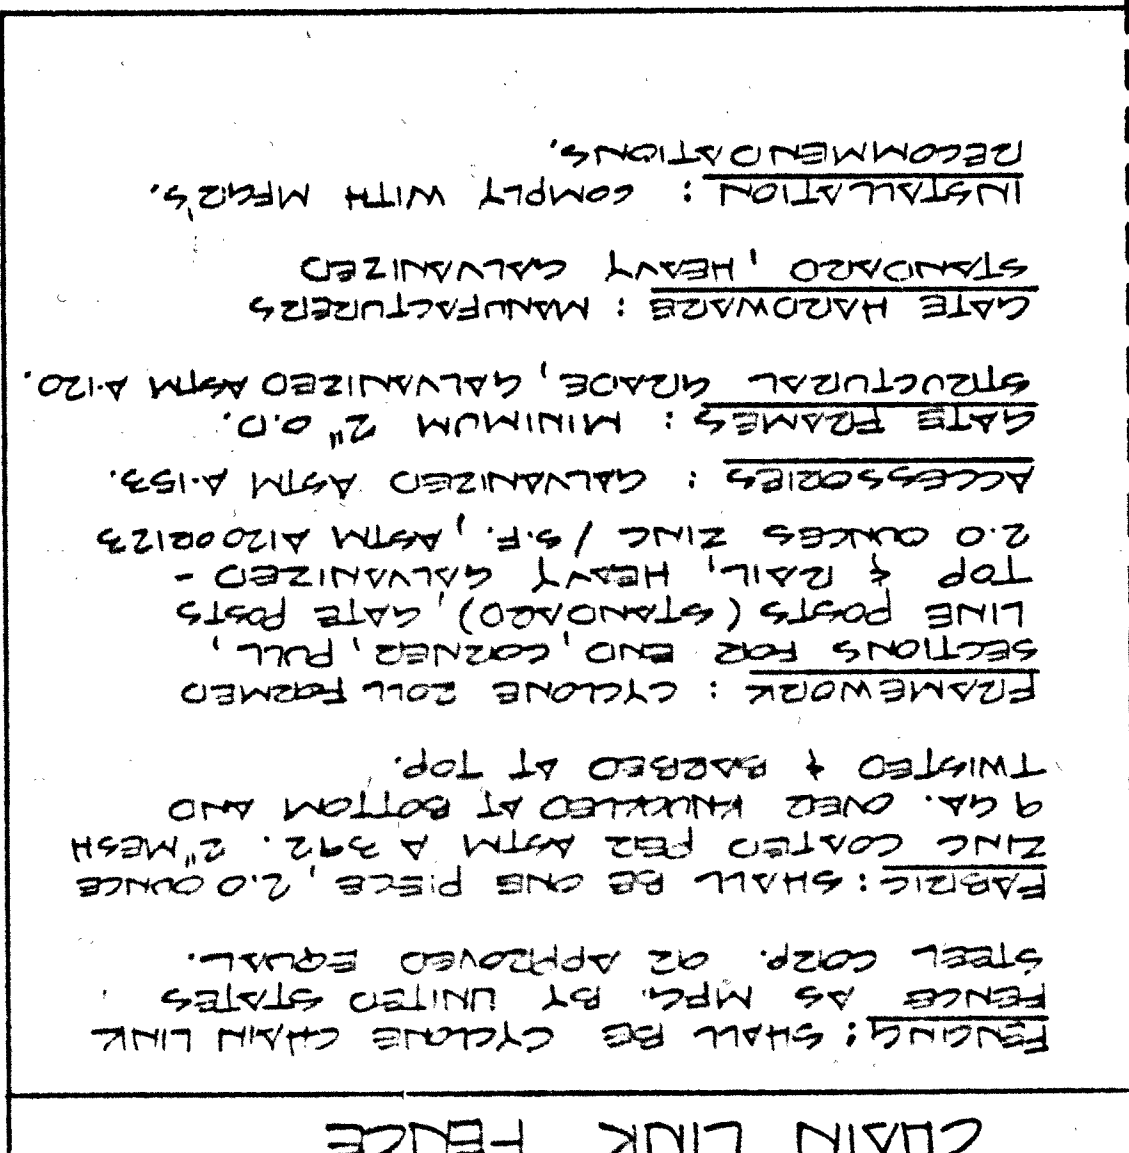

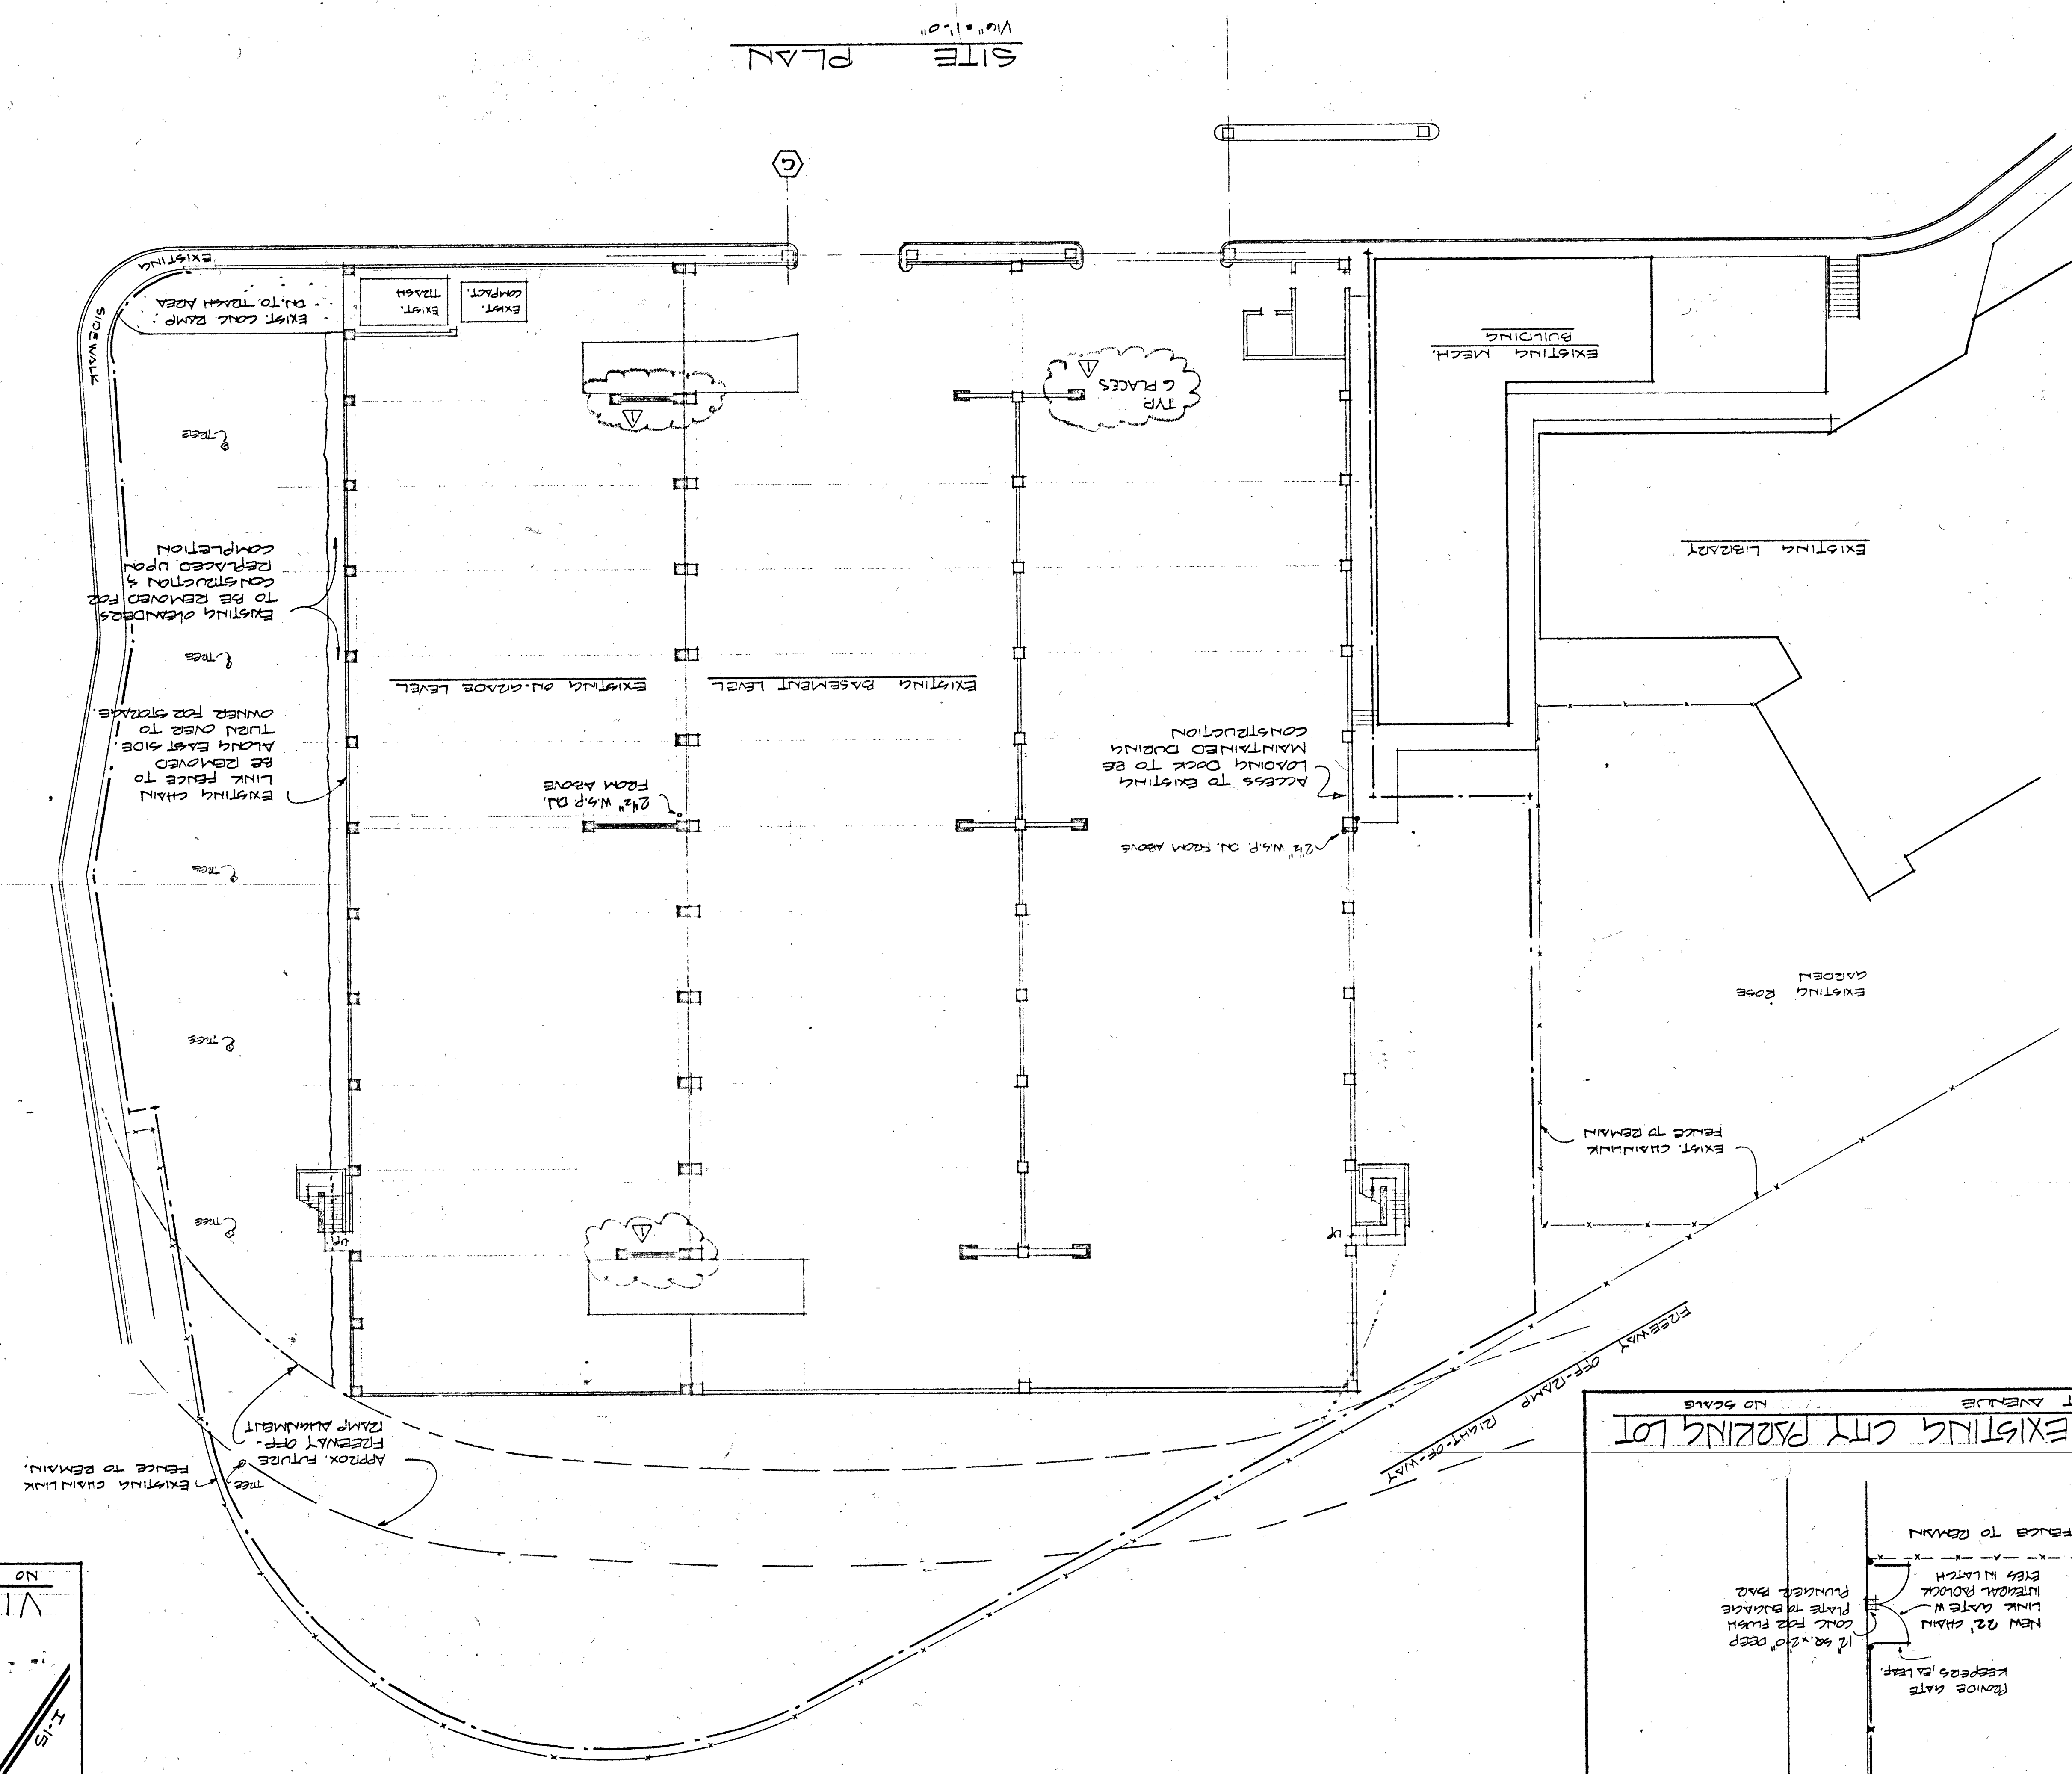


SITE PLAN

ISSUE OR REVISION	DATE	DESCRIPTION
▽	12-14-78	AS-BUILT

LIMITS OF CONSTRUCTION _____

LAS VEGAS BOULEVARD NORTH

Notes
 readily exchange
 local or all trees.
 existing plants to
 be protected as possible
 coordinate w/ engineer &
 owner.

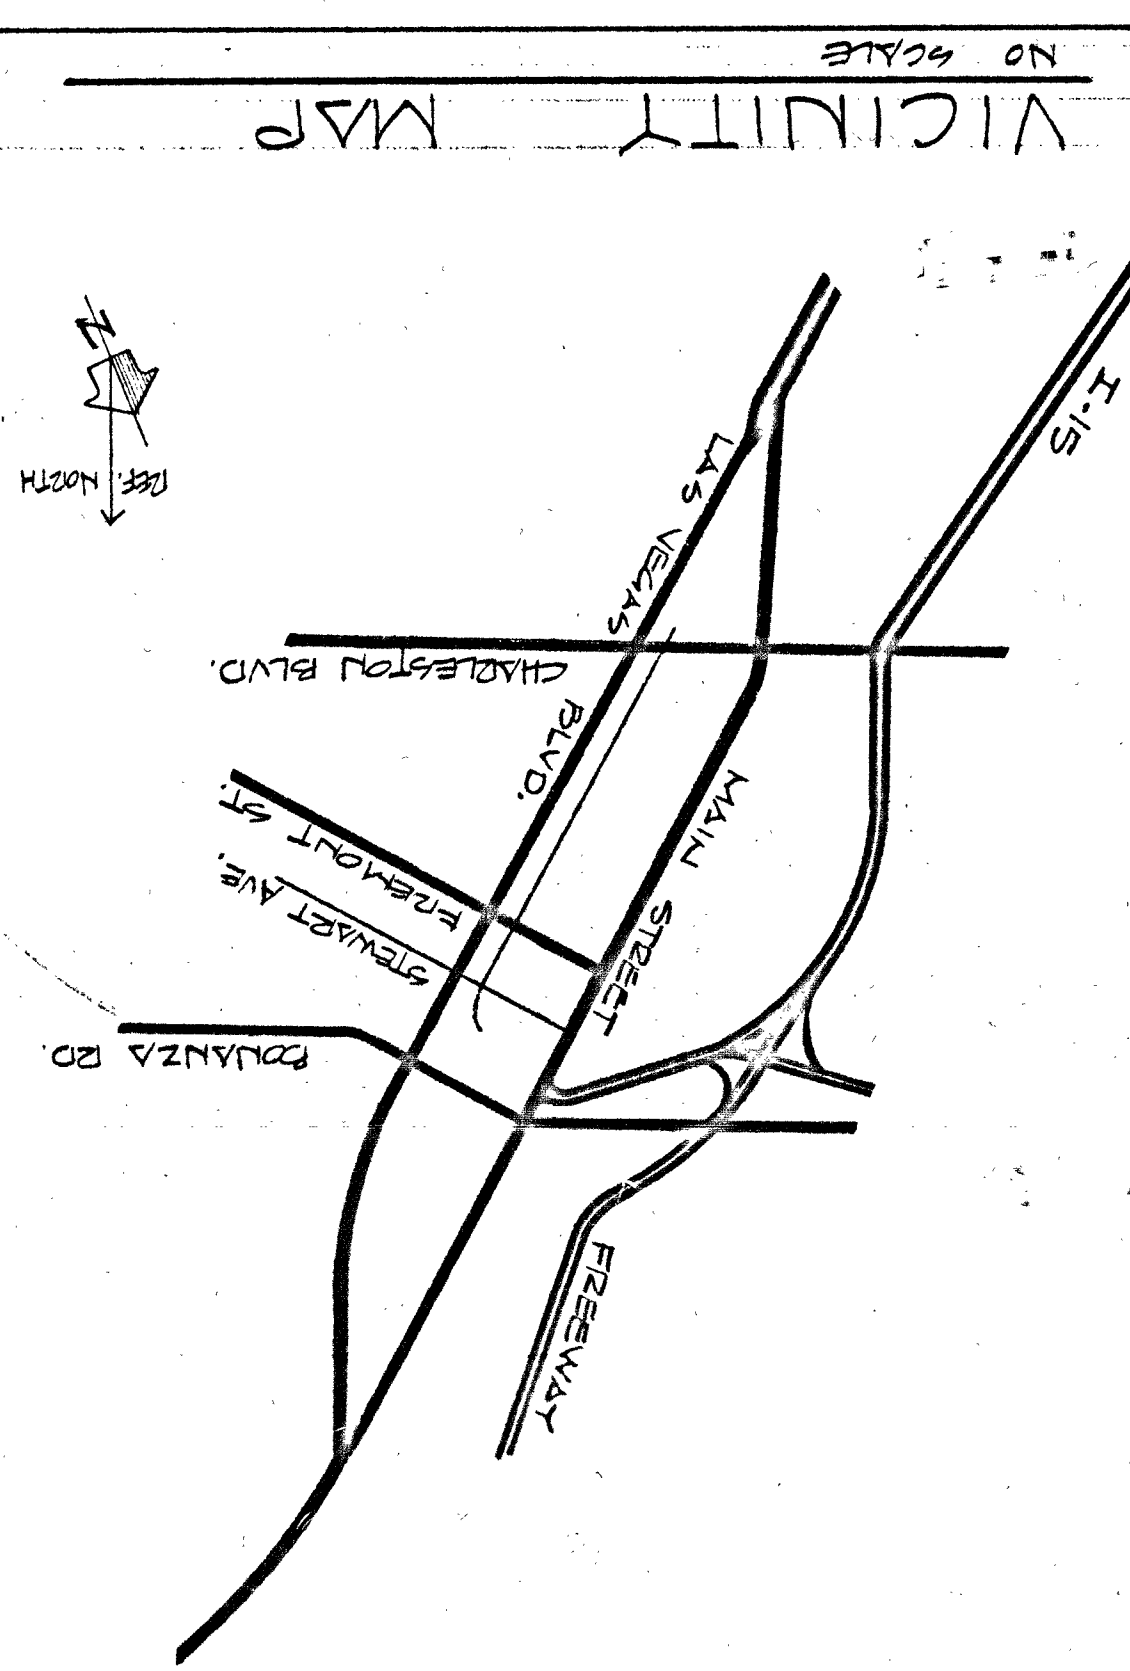

VICINITY MAP

SITE PLAN & VICINITY MAP

PARKING GARAGE ADDITION
LAS VEGAS CITY HALL
400 STEWART AVENUE LAS VEGAS, NEVADA

MARTIN

CASHDAN

MARTIN & CASHDAN
STRUCTURAL ENGINEERS
844 EAST SAHARA AVENUE
LAS VEGAS NEVADA 89104
TELEPHONE (702) 735-7166

CONSULTANT