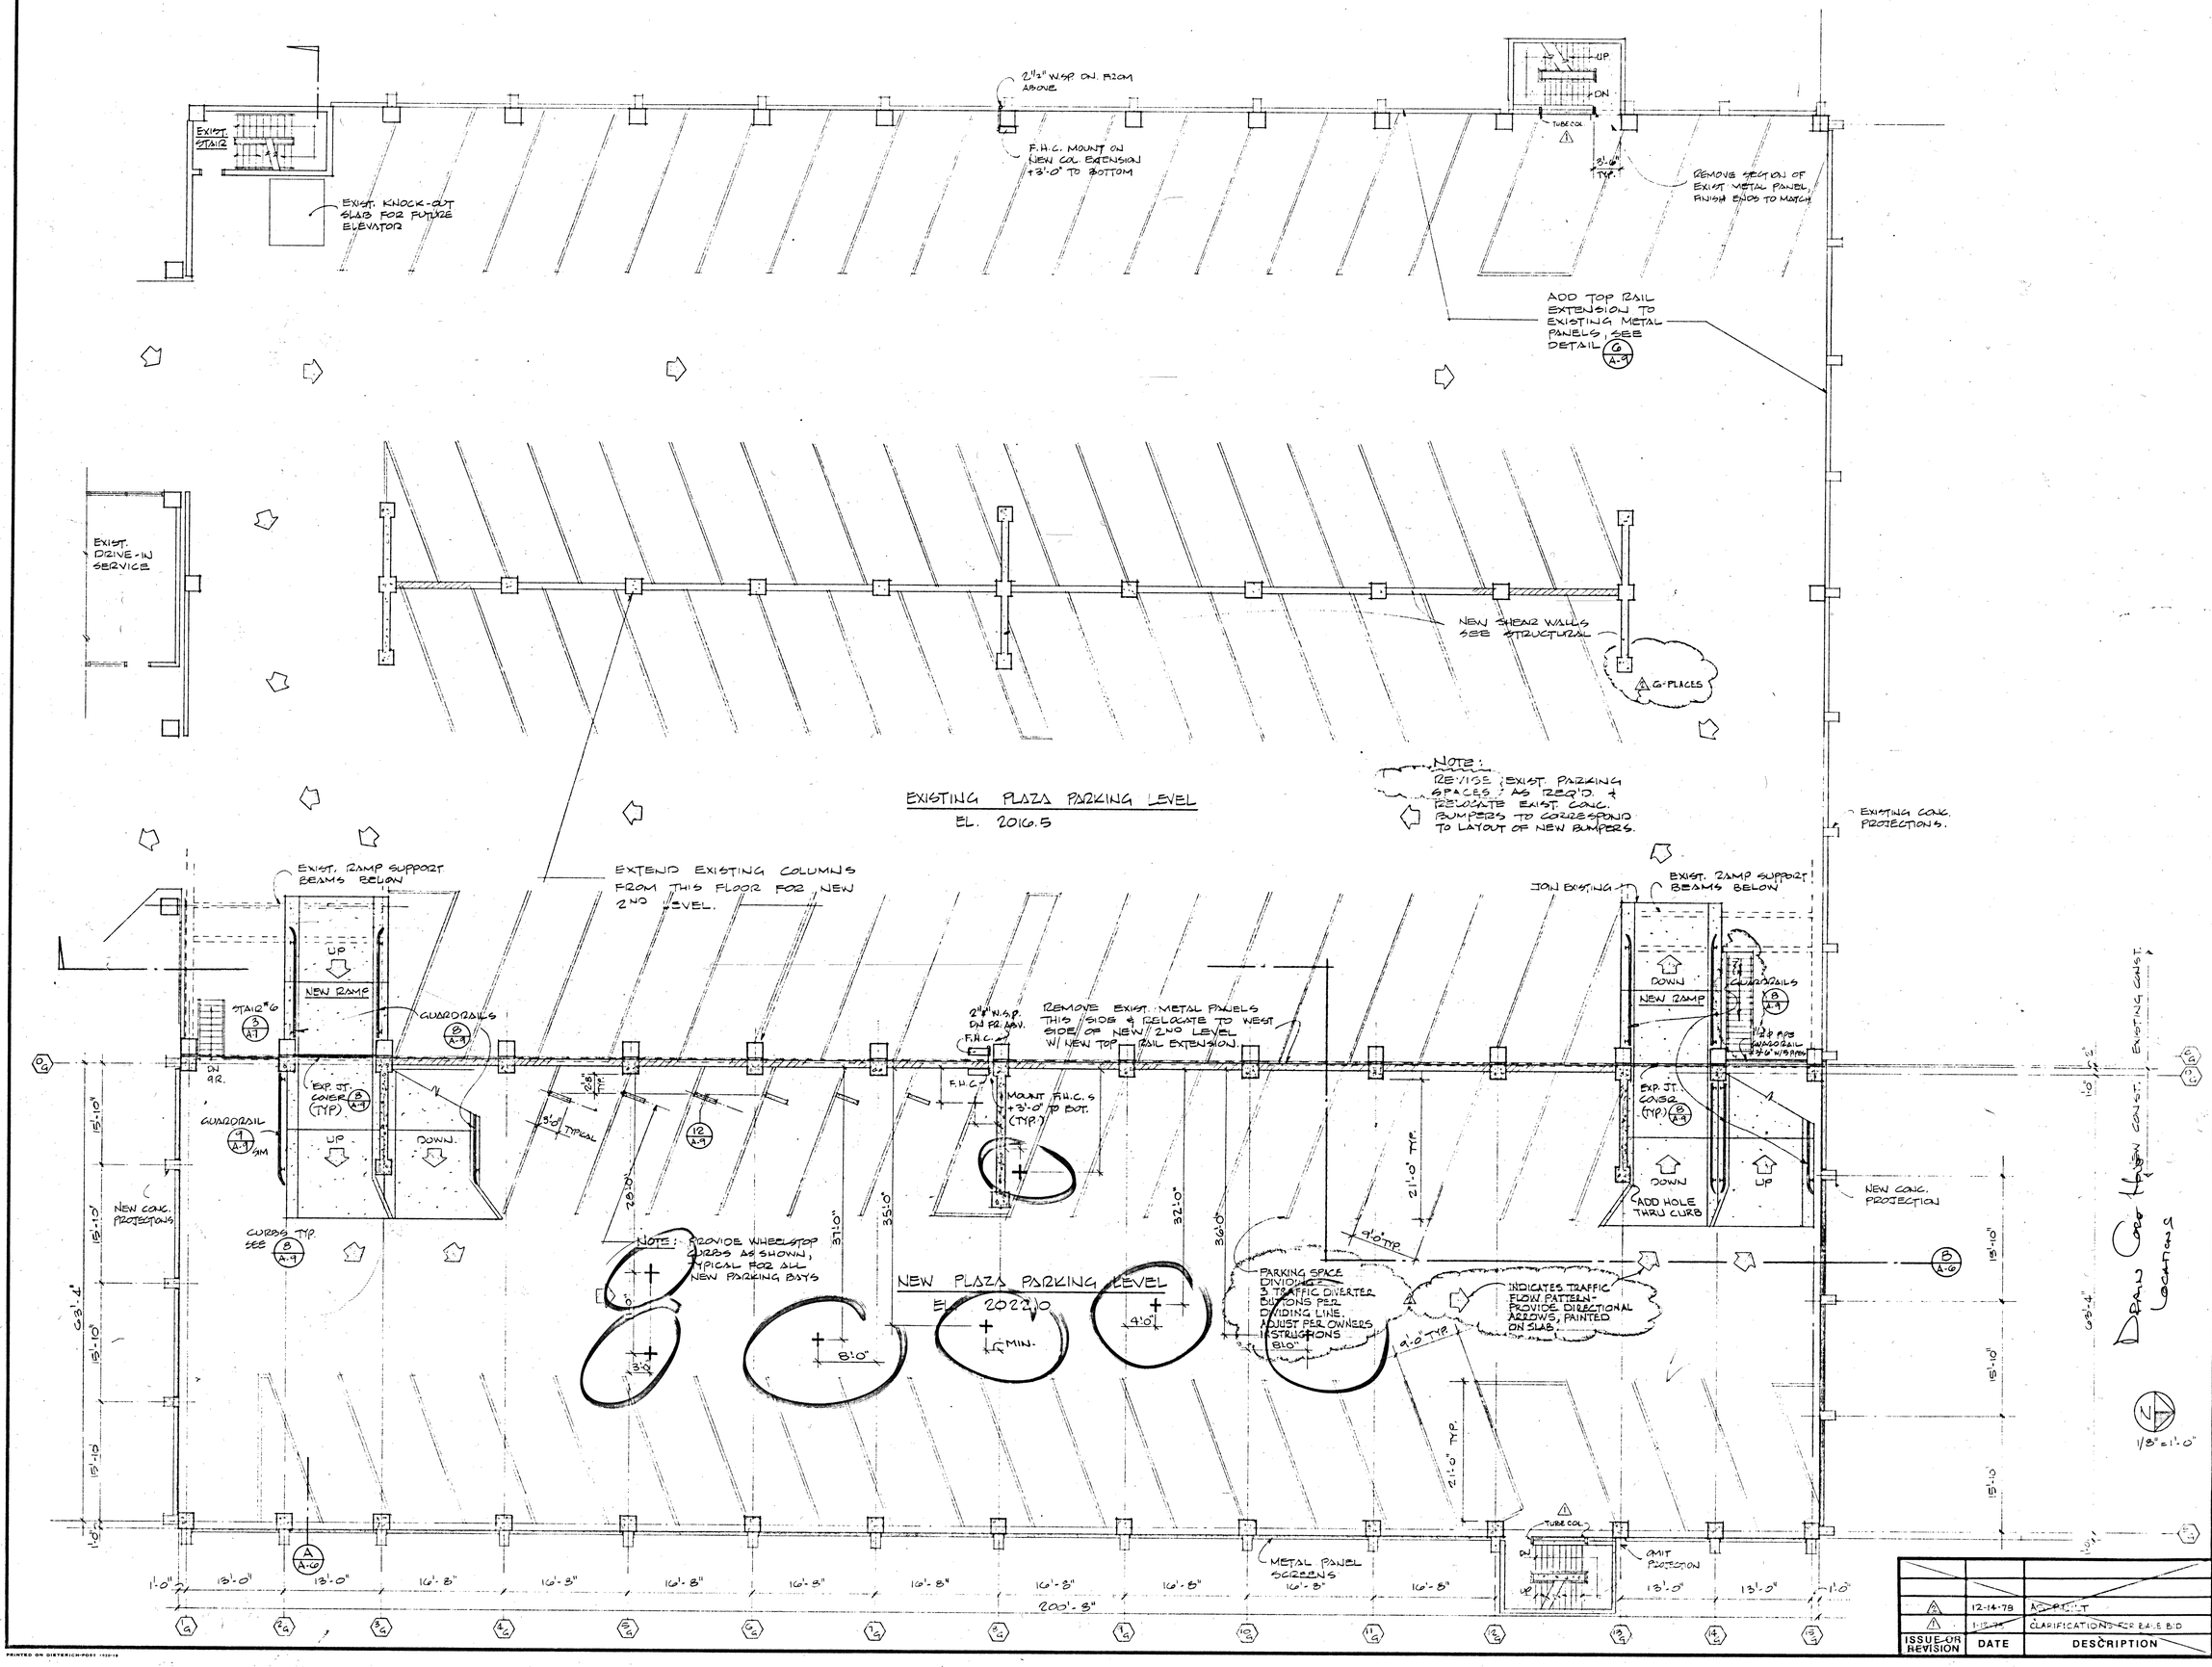

ISSUE OR REVISION	DATE	DESCRIPTION
A	12-14-78	ADDENDUM
1	1-12-79	CLARIFICATIONS FOR RAISE BID

CONSULTANT

MARTIN & CASHDAN
STRUCTURAL ENGINEERS
844 EAST SAHARA AVENUE
LAS VEGAS NEVADA 89104
TELEPHONE (702) 735-7166

JOB TITLE

PARKING GARAGE ADDITION
LAS VEGAS CITY HALL
400 STEWART AVENUE LAS VEGAS, NEVADA

SHEET TITLE

EXISTING PLAZA & NEW PLAZA LEVELS
WORK SHEET FOR SPOTTING DRAINS

JOB NO. [illegible]
DATE [illegible]
ENGINEER
DRAWN HDS
CHECKED

SHEET NO.
A-2A

PRINTED ON DIETERICH-POST 1020-18