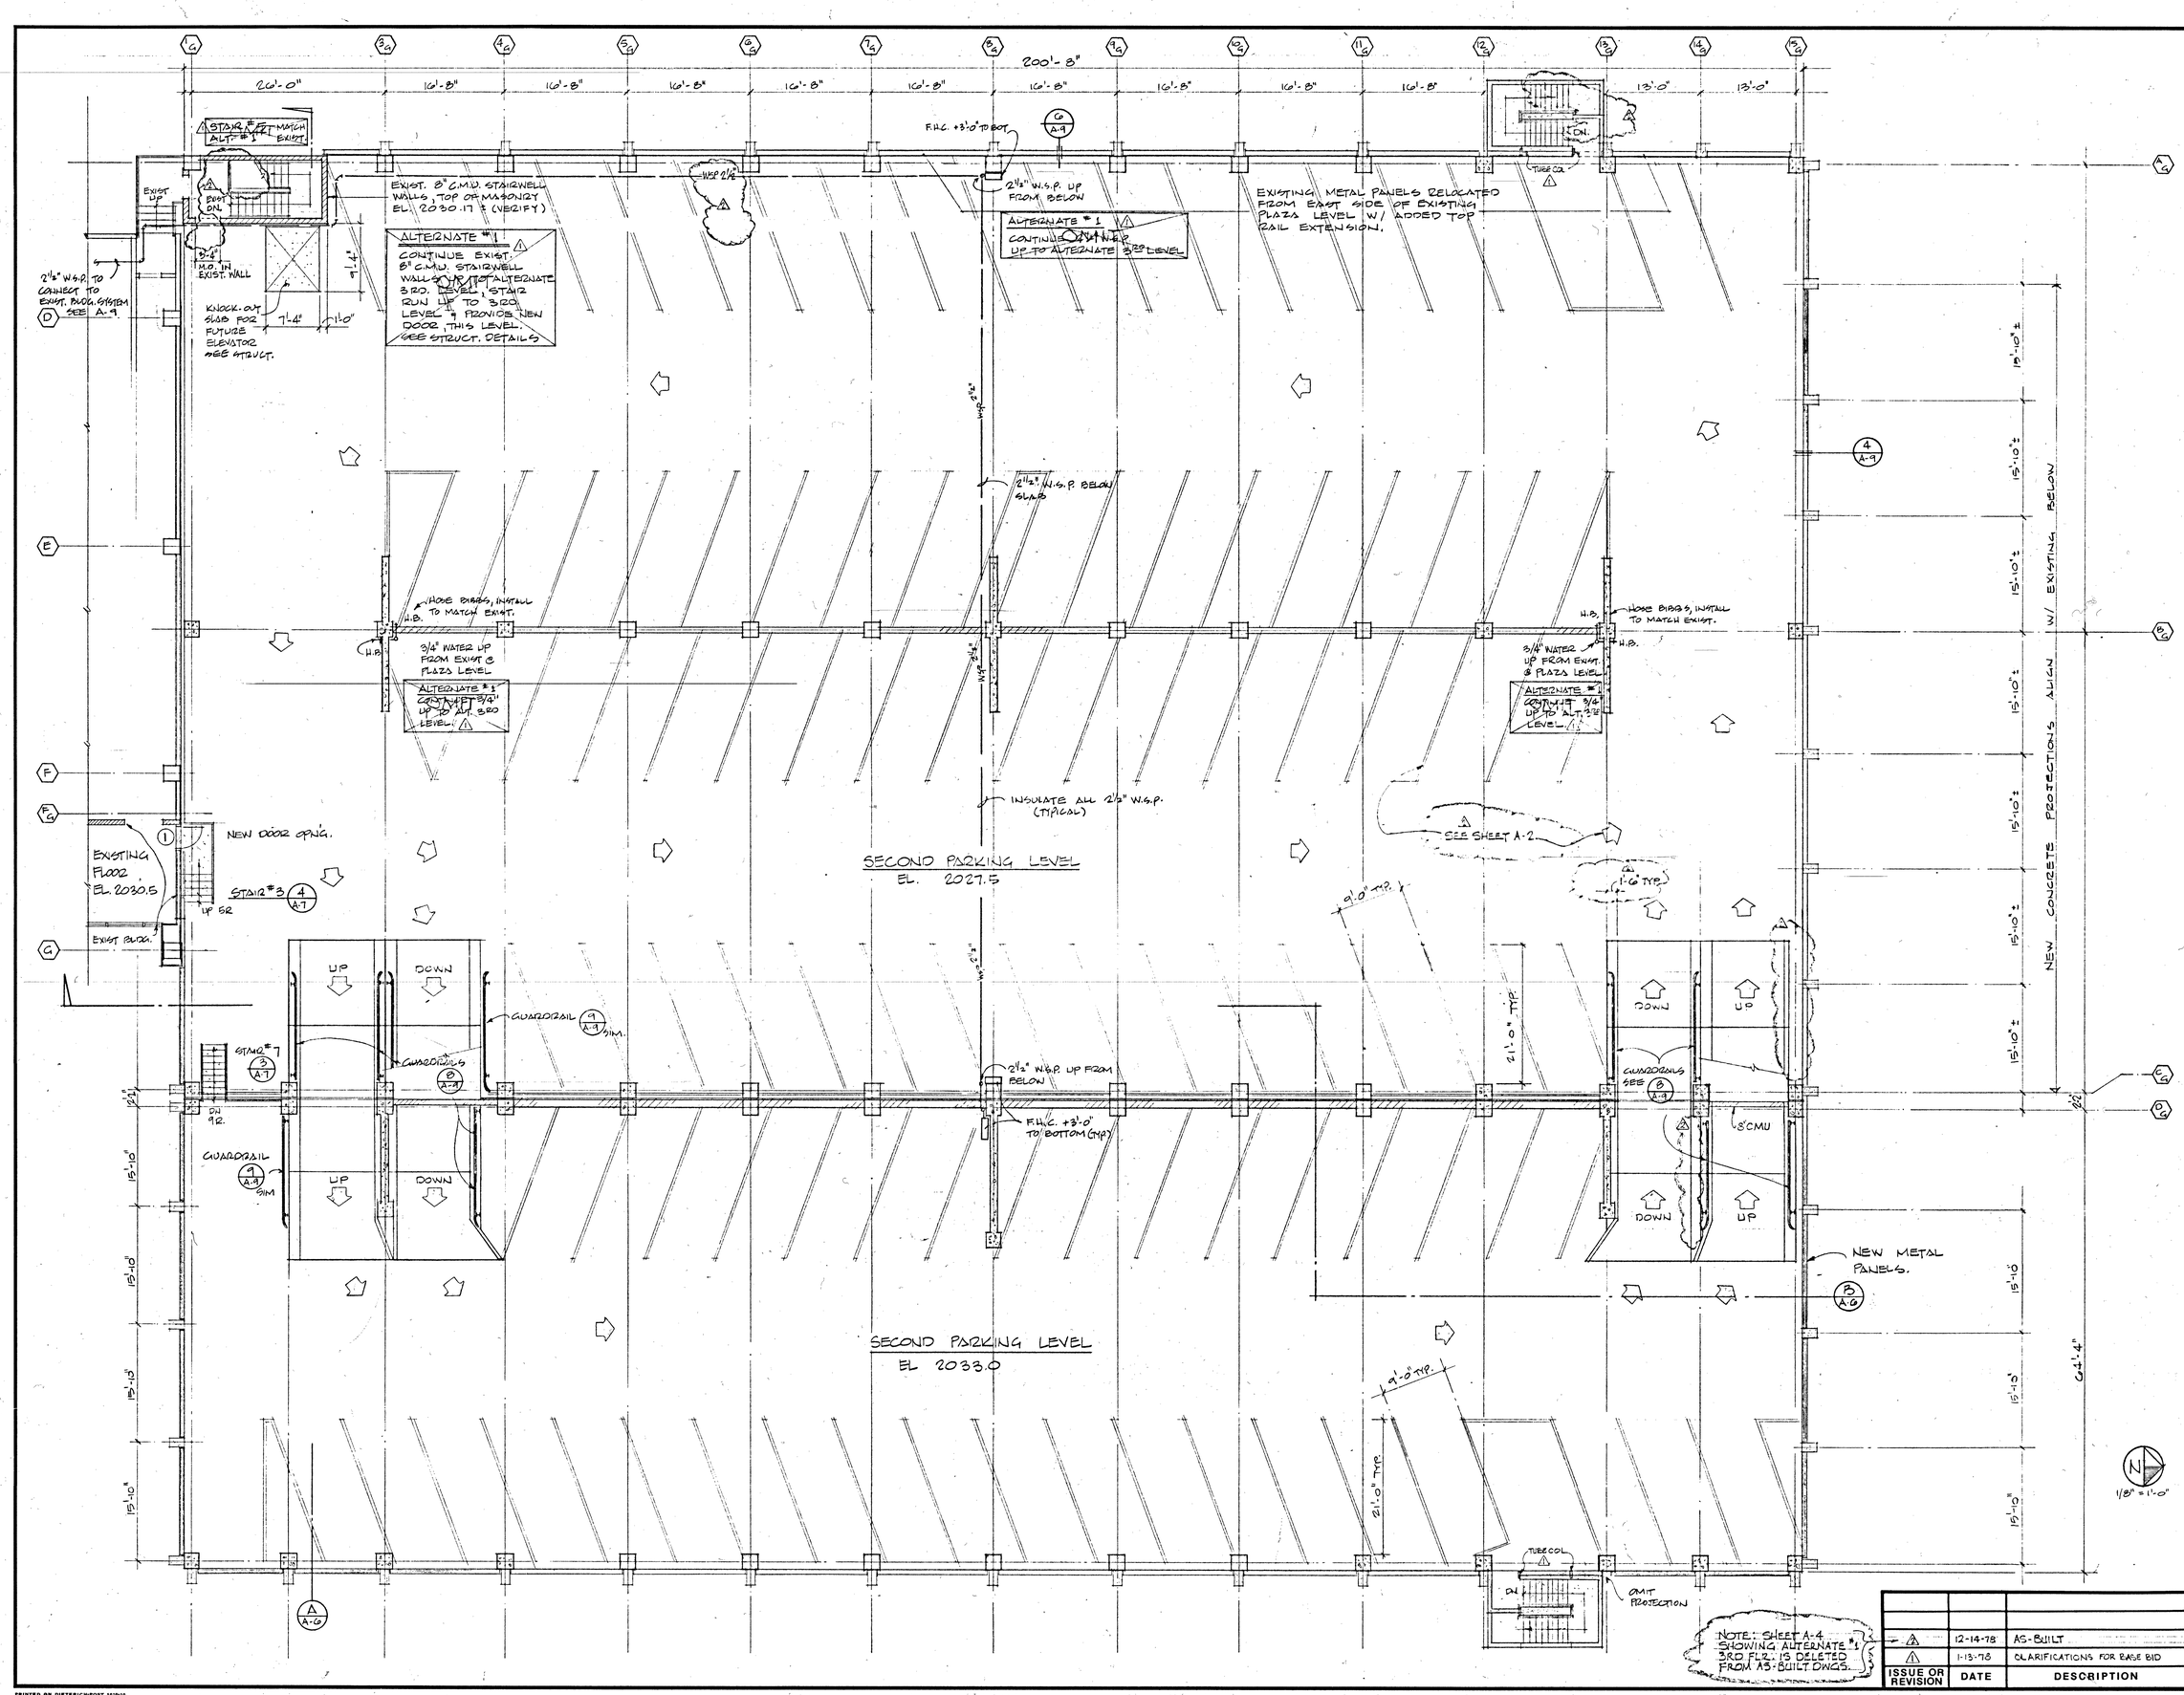

NOTE: SHEET A-4 SHOWING ALTERNATE #1 3RD FLR. IS DELETED FROM AS-BUILT DWGS.

ISSUE OR REVISION	DATE	DESCRIPTION
2	12-14-78	AS-BUILT
1	1-13-78	CLARIFICATIONS FOR BASE BID

CONSULTANT

MARTIN & CASHDAN
STRUCTURAL ENGINEERS
844 EAST SAHARA AVENUE
LAS VEGAS NEVADA 89104
TELEPHONE (702) 735-7166

JOB TITLE
PARKING GARAGE ADDITION
LAS VEGAS CITY HALL
400 STEWART AVENUE LAS VEGAS, NEVADA

SHEET TITLE
SECOND LEVEL

JOB NO. 77079
DATE 10-21-77
ENGINEER
DRAWN HDS
CHECKED

SHEET NO.
A-3

PRINTED ON DIETRICH-POST 1320-12

77079