


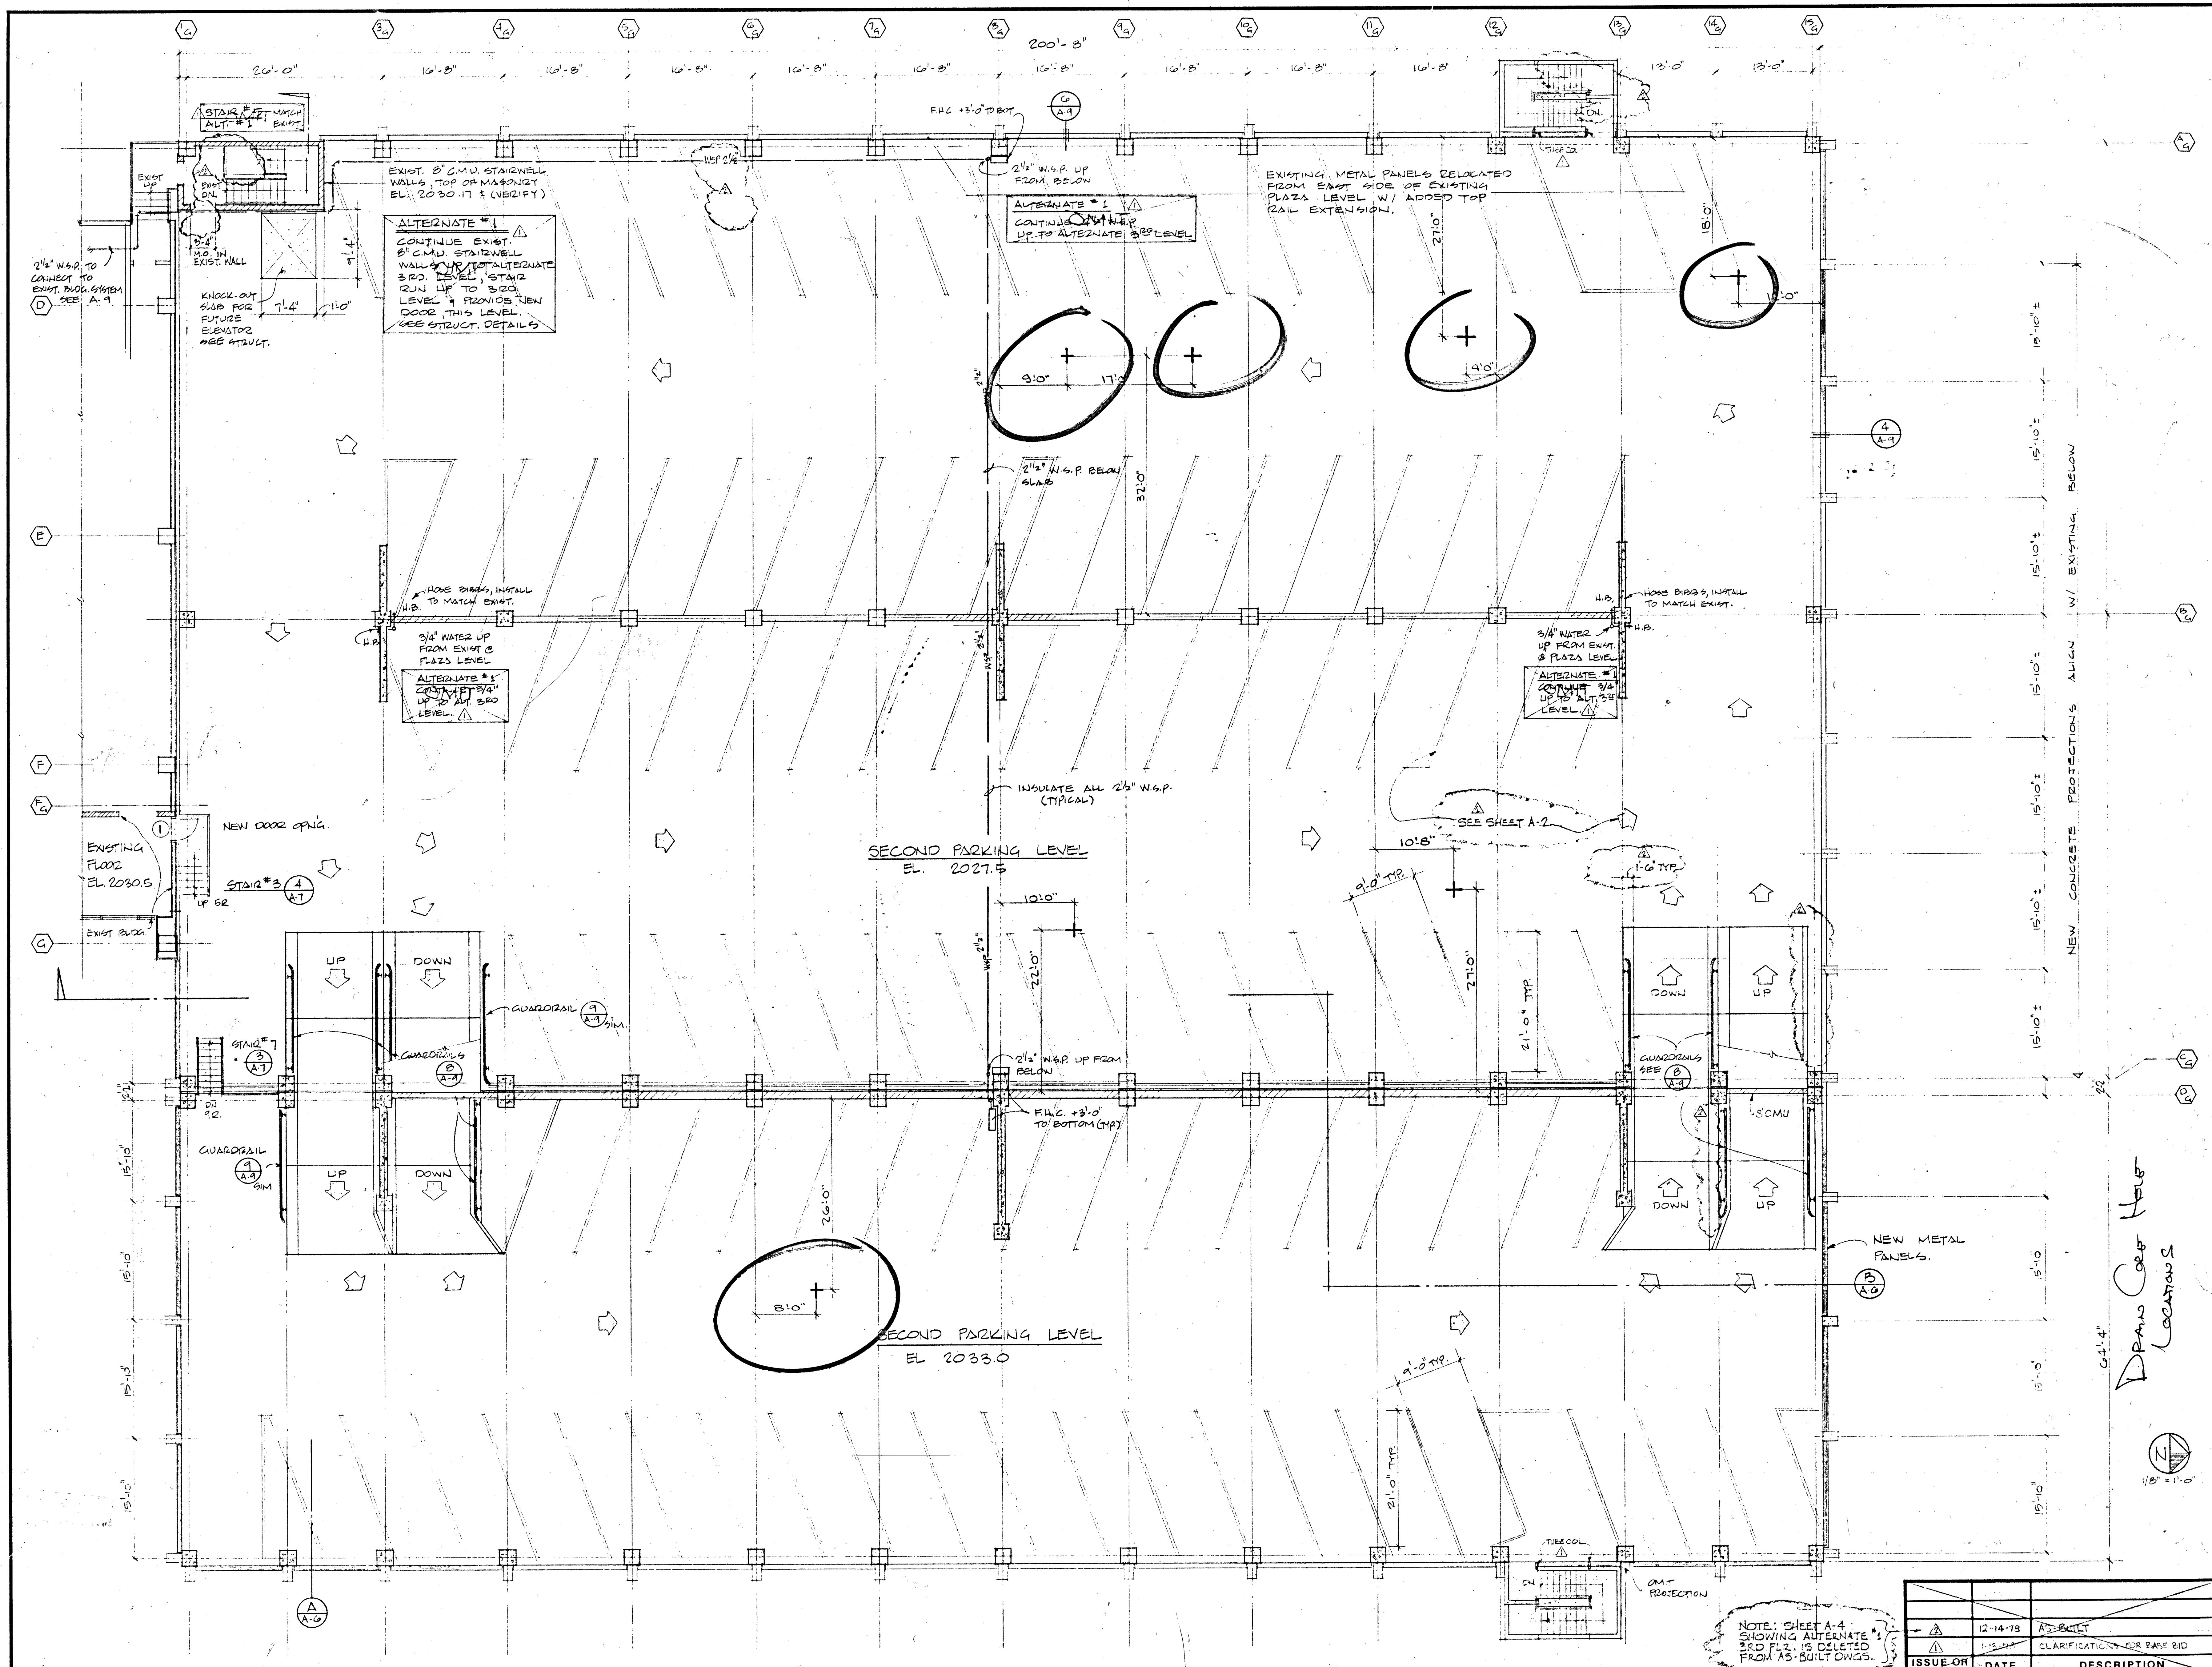

CONSULTANT

MARTIN & CASHDAN
STRUCTURAL ENGINEERS
844 EAST SAHARA AVENUE
LAS VEGAS, NEVADA 89104
TELEPHONE (702) 735-7166

PARKING GARAGE ADDITION
LAS VEGAS CITY HALL
400 STEWART AVENUE
LAS VEGAS, NEVADA

SECOND LEVEL
WORK SHEET FOR SPOTTING DRAINS

JOB NO.	71044
DATE	10-21-77
ENGINEER	
DRAWN	HDS
CHECKED	
SHEET NO.	A-3A