


I, L.A. HARRIS, A DULY REGISTERED ENGINEER & LAND SURVEYOR, do hereby certify that this map truly and correctly represents the results of a survey made under my supervision and completed on the 30th day of JANUARY, 1957 of and for the City of Las Vegas, Nevada. This survey is not a subdivision as defined in Planning & Zoning Laws as shown in 1943-1949 Supplement, Nevada Compiled Laws.

*L.A. Harris* (SEAL)  
 REGISTERED ENGINEER & LAND SURVEYOR  
 NEVADA R.E. 24

APPROVED this 20th day of Feb. 1957

*George Estada*  
 CITY ENGINEER  
 REGISTERED NEVADA NO. 280

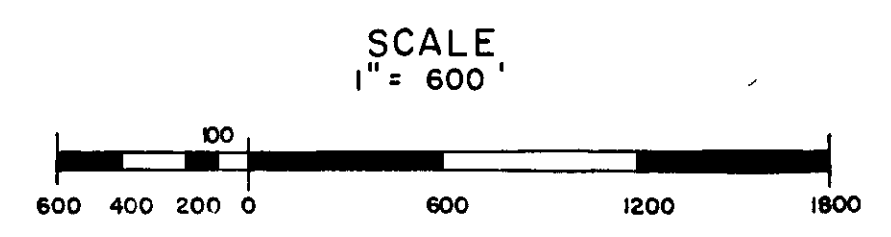

VOID SEE (FILE 7 P40)

NO. 99946  
 FILED AT THE REQUEST OF  
*City of Las Vegas*  
 Date 2-21-57 at 3:05 P.M.  
 FILE 6  
 Reg. Prof. Eng. 87-  
 CLARK COUNTY, NEVADA RECORDS  
 PAUL C. O'MALLEY, RECORDER  
 Exp. S. O'H. Deputy

99946  
 RECEIVED AT THE REQUEST OF  
*City of Las Vegas*  
 FEB 21 3 05 PM '57

Basis of Bearings is the East line of South East Quarter of Section 36, T.20S., R.61E. M.D.B. & M. Given as S. 1° 00' 30" E. in File No. 1 at page 75 of Registered Engineers' Surveys, Office of Clark County Recorder, Nevada

- MONUMENTS FOUND
- MONUMENTS SET

CITY OF LAS VEGAS, NEVADA.  
 ENGINEERING DEPT.

BOUNDARY SURVEY OF PORTIONS OF SECTION 30, ALL OF SECTIONS 29, 31, 32 T.20S., R.62E., M.D.B. & M. ANNEXED TO THE CITY OF LAS VEGAS, NEVADA UNDER ORDINANCE NO. 730 AS PARCELS NOS. 1, 2 & 3.

DRAWN BY: L. HARPER	CKD. BY: J.H.P.	APPROVED: <i>[Signature]</i>	FIELD BOOK
DATE 2-15-57	DATE 2-20-57	DATE 2-20-57	55-27 X