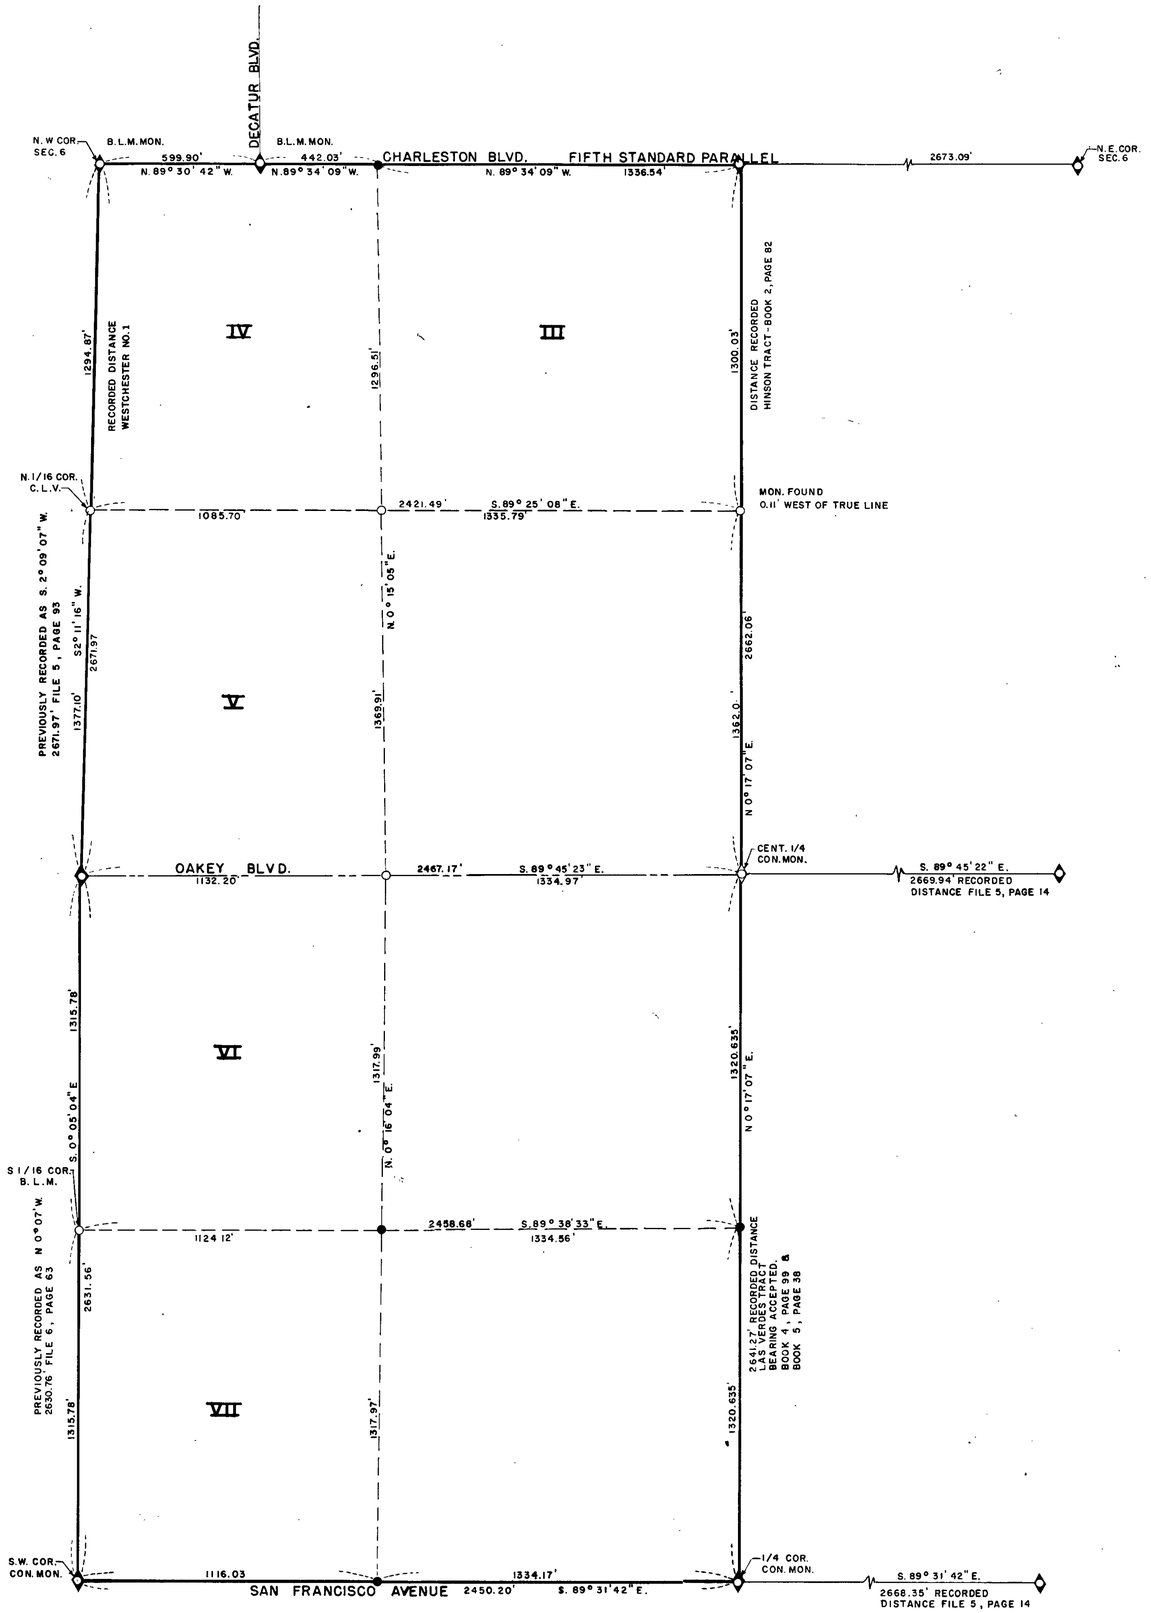

BASIS OF BEARINGS IS THE SOUTH LINE OF SECTION 6, T21S, R61E, M.D.B.&M. GIVEN AS S.89°31'42"E. IN FILE 5 AT PAGE 14 OF REGISTERED ENGINEERS' SURVEYS, OFFICE OF CLARK COUNTY RECORDER, NEVADA

I, L.A. HARRIS, A DULY REGISTERED ENGINEER & LAND SURVEYOR, do hereby certify that this map truly and correctly represents the results of a survey made under my supervision and completed on the 6th day of August, 1959 of and for the CITY OF LAS VEGAS, NEVADA. This survey is not a subdivision as defined in Planning & Zoning Laws as shown in 1943 – 1949 Supplement, Nevada Compiled Laws. Any discrepencies between this and parts of other surveys of record are herein shown.

L A Harris
REGISTERED ENGINEER & LAND SURVEYOR
NEVADA R.E. NO. 24

APPROVED this 14 day of October, 1959

by Victor B. Uehling
DEPUTY CITY ENGINEER
NEVADA R.E. NO. 769

O – MONUMENTS FOUND

● – MONUMENTS SET C.L.V.

TOTAL ACRES: 297.19

NO 176519
FILED AT THE REQUEST OF
City of L.V. Nev
Date 10-13-59 at 12:06 P.M.
FILE 8 PAGE 64
Reg. Prof. Eng. Surveys
CLARK COUNTY, NEVADA, RECORDS
PAUL C. O'MALLEY, RECORDER
Fee $ Deputy

NO. 176519
RECORDED AT THE REQUEST OF
City of L.V. Nev
Date 10-13-59 at 12:06 P.M.
Official Records, Book No. 217
CLARK COUNTY, NEVADA
PAUL C. O'MALLEY, RECORDER
Fee $ Deputy

SCALE: 1" = 300'

300 250 200 100 0 300 600 900

CITY OF LAS VEGAS, NEVADA
ENGINEERING DEPT.

BOUNDARY SURVEY FOR ANNEXATION OF GOVERNMENT LOTS III, IV, V, VI, VII & S.E. 1/4, N.W. 1/4 & E. 1/2, S.W. 1/4, SECTION 6, T.21S., R61E, M.D.B.&M ..... W. 1/2 SECTION 6

DRAWN BY: L. HARPER	CHECKED BY: BL	APPROVED:	FIELD BOOK
DATE 8-11-59	DATE 9-12-59	DATE 9-12-59	55-27X

Ordinance #7811

053-20