

80.09 Acres

Basis of bearings is the North line of the Northeast one quarter of Section 1, T. 21 S., R. 60 E., M.D.B. & M. as shown on Bureau of Land Management plat of retracement, dated June 8, 1953.

- MONUMENTS FOUND
- MONUMENTS SET


71555
 City of Las Vegas
 3-2-56 11:40 A.
 5 93
 RECEIVED AT THE REQUEST OF
 City of Las Vegas
 FEB 2 11 00 AM '56
 86

I, L. A. Harris, A DULY REGISTERED ENGINEER & LAND SURVEYOR, do hereby certify that this map truly and correctly represents the results of a survey made under my supervision and completed on the 20th day of DEC. 1955 of and for the City of Las Vegas, Nevada.

L. A. Harris
 REGISTERED ENGINEER AND LAND SURVEYOR
 NEVADA R.E. 24

APPROVED this 7th day of FEB. 1956

James E. Wade
 CITY ENGINEER
 NEVADA R. E. 280

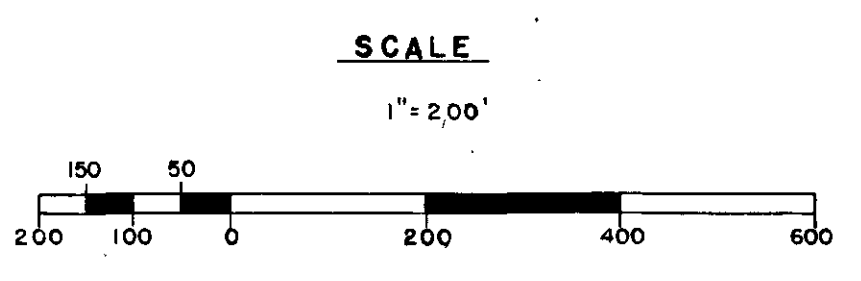

CITY OF LAS VEGAS, NEVADA			
ENGINEERING DEPT.			
Boundary Survey of the E 1/2, NE 1/4, of Section 1, T. 21 S., R. 60 E., MDB&M. Annexed Area to the City of Las Vegas, Nevada under Ordinance No. 698			
DRAWN BY: <u>D. Frank</u>	CHECKED BY: <u>EW</u>	APPROVED: <u>L.A.H.</u>	FIELD BOOK REF.
DATE: 2-6-56	DATE: 2-6-56	DATE: 2-6-56	55-3