

I, L.A. HARRIS, A DULY REGISTERED ENGINEER & LAND SURVEYOR, do hereby certify that this map truly and correctly represents the results of a survey made under my supervision and completed on the 30th day of JANUARY, 1957 of and for the City of Las Vegas, Nevada. This survey is not a subdivision as defined in Planning & Zoning Laws as shown in 1943-1949 Supplement, Nevada Compiled Laws.

L.A. Harris
REGISTERED ENGINEER & LAND SURVEYOR
NEVADA R.E. No. 24


APPROVED this 4TH Day of September 1957

Victor B. Udell
CITY ENGINEER
NEVADA R.E. No. 769

NO. 114357
FILED AT THE REQUEST OF
City of Las Vegas
Date 9-9-57 at 10:15 A.M.
FILE 7 PAGE 40
Reg. Prof. Eng. Surveyor
CLARK COUNTY, NEVADA, RECORDS
PAUL C. O'MALLEY, RECORDER
Fee \$ 5.00 Deputy

114357
RECORDED AT THE REQUEST OF
City of Las Vegas
Date 9-9-57 at 10:12 A.M.
Official Records, Book No. 139
CLARK COUNTY, NEVADA
PAUL C. O'MALLEY, RECORDER
Fee \$ 5.00 Deputy

SCALE
1" = 600'

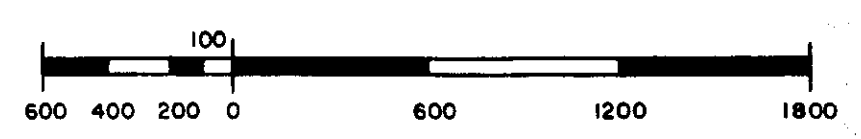

Basis of Bearings is the East line of South East Quarter of Section 36, T.20S., R.61E., M.D.B. & M. Given as S. 1° 00' 30" E. in File No. 1 at page 75 of Registered Engineers' Surveys, Office of Clark County Recorder, Nevada.

- MONUMENTS FOUND
- MONUMENTS SET

CITY OF LAS VEGAS, NEVADA
ENGINEERING DEPT.

BOUNDARY SURVEY OF PORTIONS OF SECTIONS 29, 30, 32, ALL OF SECTION 31, T.20S., R.62E., M.D.B. & M. ANNEXED TO THE CITY OF LAS VEGAS, NEVADA UNDER ORDINANCE NO. 730 AS PARCELS NOS. 1, 2 & 3. (AMENDED)

DRAWN BY: L. HARPER	CHK. BY: L. HARRIS	APPROVED: <u>L.A. Harris</u>	FIELD BOOK
DATE 8-27-57	DATE 9-4-57	DATE 9-4-57	55-27X