


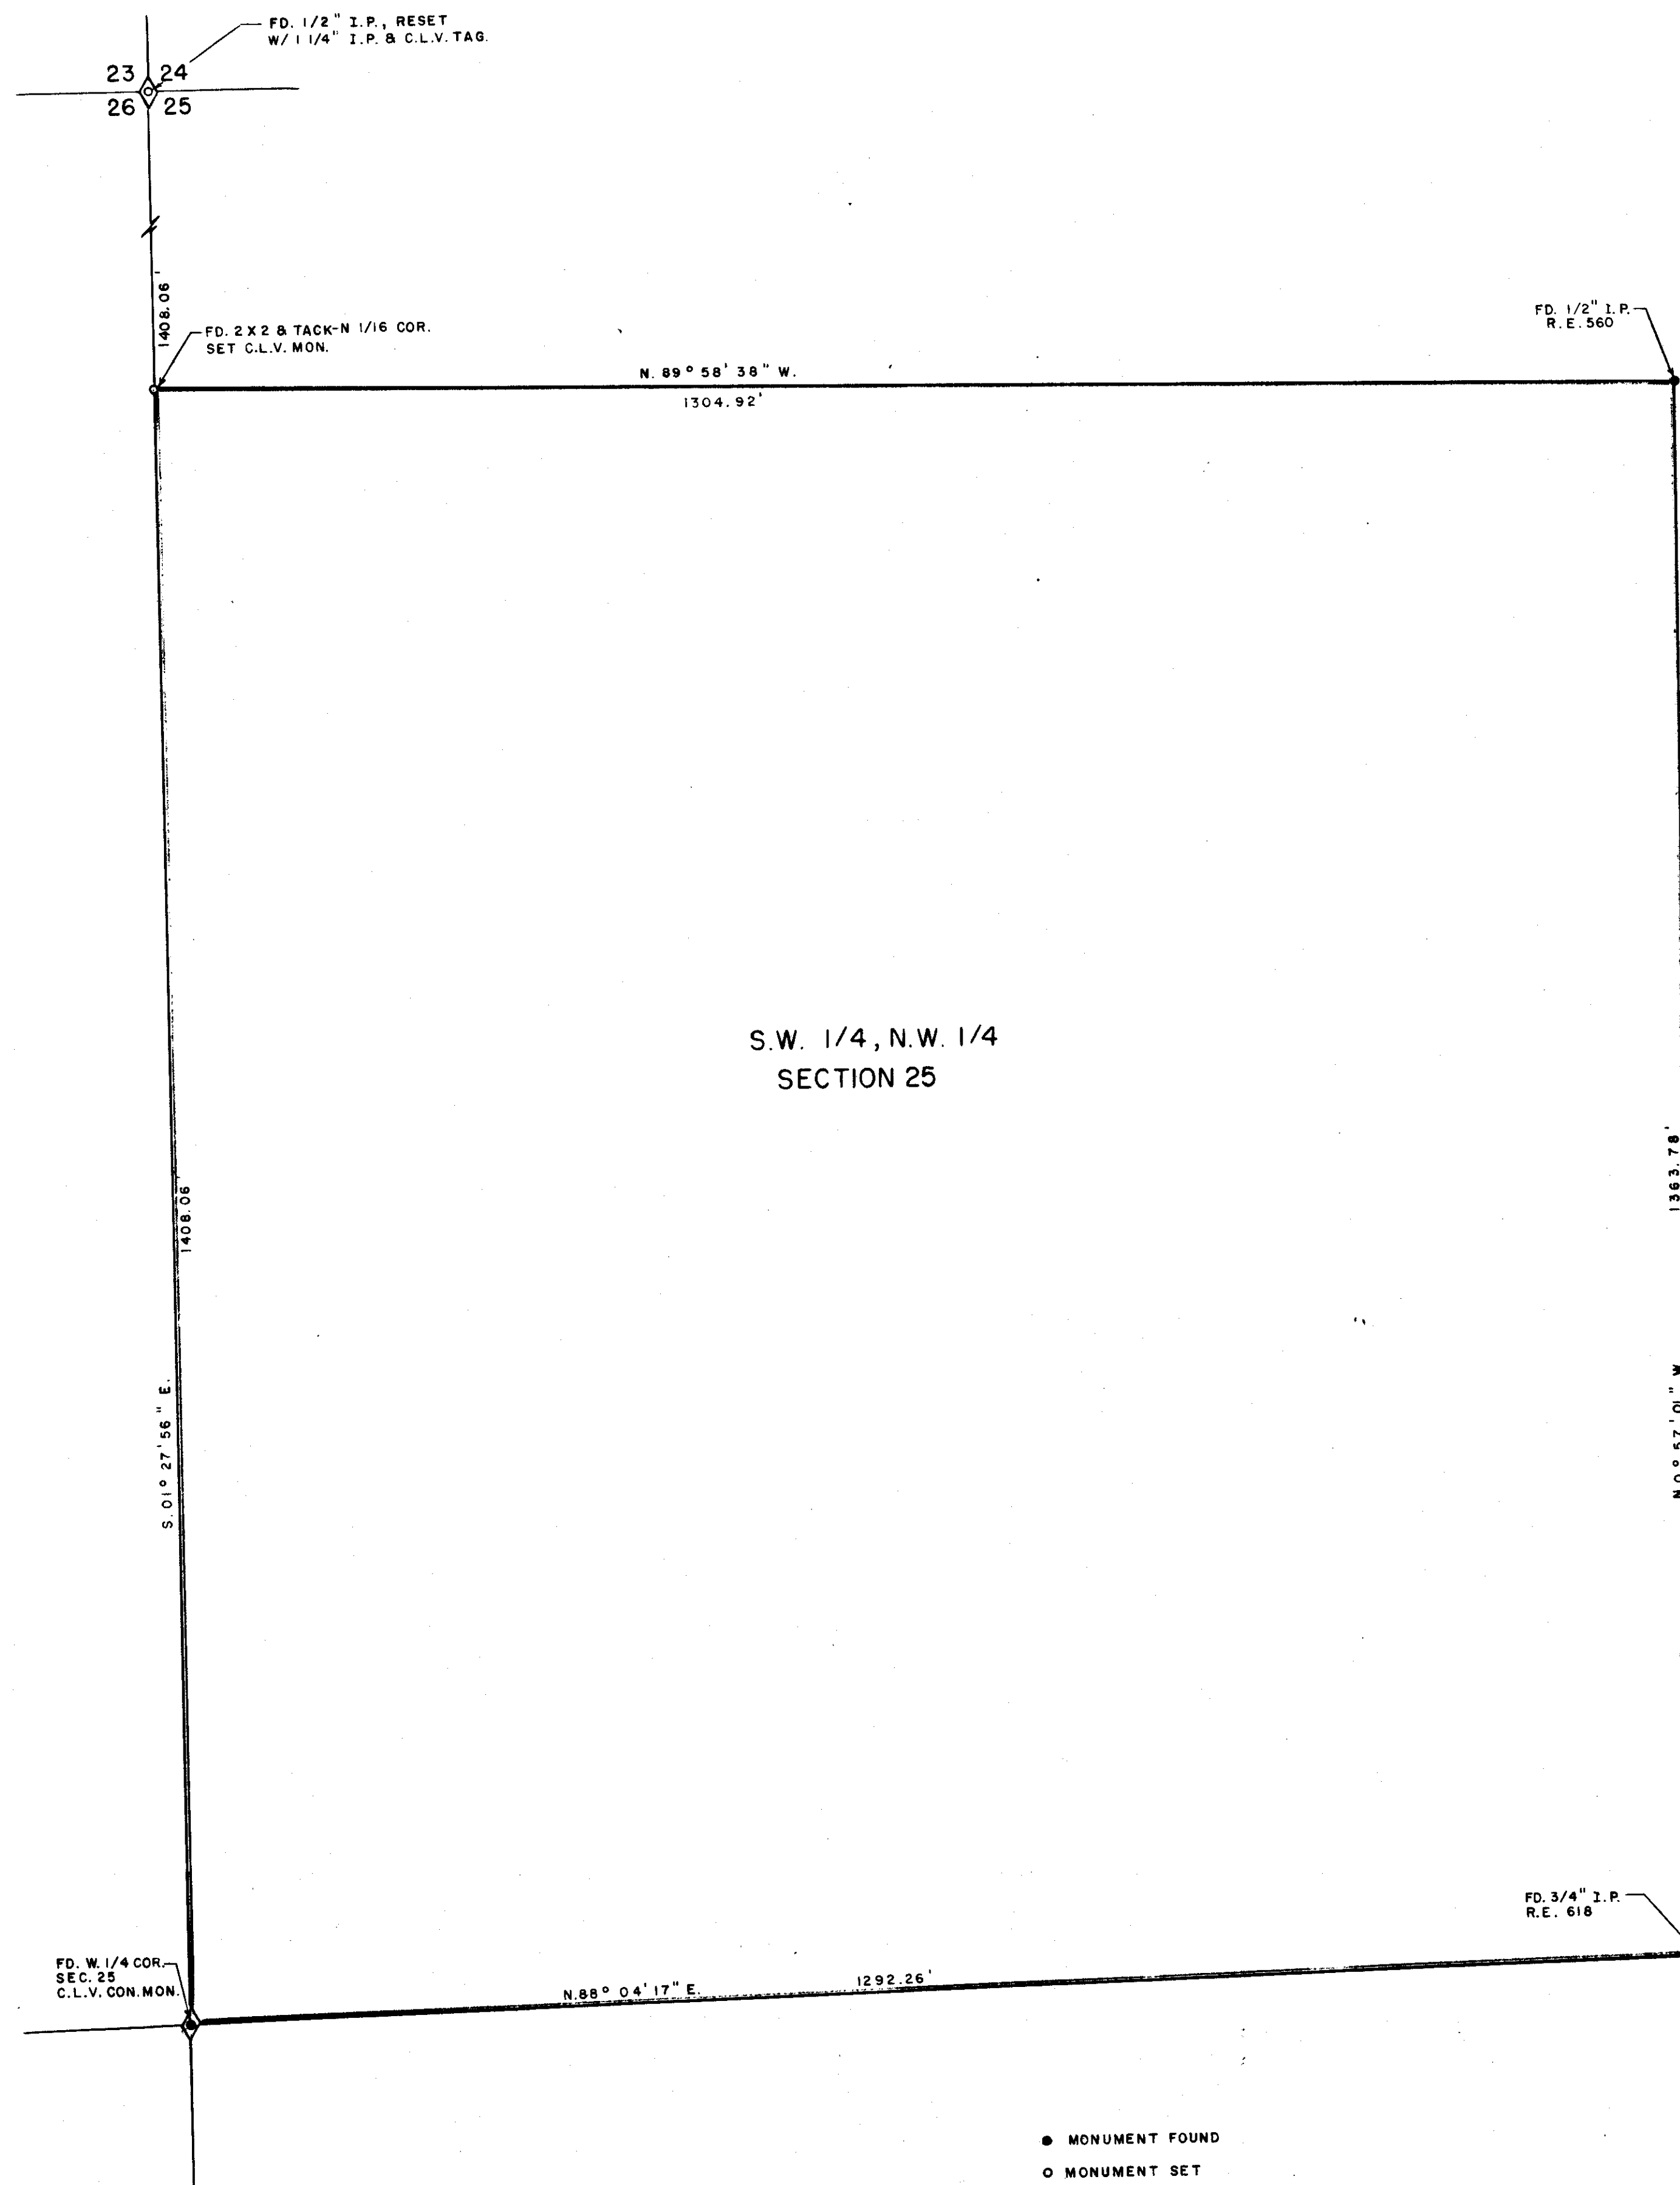

I, JAMES A. RANKIN, A DULY REGISTERED
ENGINEER & LAND SURVEYOR, do hereby certify this map
truly and correctly represents the results of a survey made
under my supervision and completed on the 25th day of
May, 1962 of and for the City of Las Vegas, Nevada.
This Survey is not a subdivision as defined in Planning &
Zoning Laws as shown in 1943-1949 Supplement,
Nevada Compiled Laws.

James A. Rankin
REGISTERED ENGINEER & LAND SURVEYOR
NEVADA R.E. 1350

APPROVED this 6th day of JUNE, 1962

J. P. [Signature]
CITY ENGINEER
NEVADA R.E. 396

SCALE: 1" = 100'



● MONUMENT FOUND
○ MONUMENT SET

THE BASIS OF BEARINGS is the West line of
Section 25, bearing S. 01° 27' 56" E.
as recorded, File 3, page 43, office
of County Recorder, CLARK COUNTY
NEVADA.

NO. 296239
FILED AT THE REQUEST OF
Attorney of Las Vegas
Date 6/19/62 BY 12:20 P.M.
FILE 11 PAGE 54
of Survey
OFFICIAL RECORDS, BOOK 368
CLARK COUNTY, NEVADA, DEPT.
PAUL C. O'MALLEY, RECORDER
Fee \$ 1.00 J. E. Deputy

CITY OF LAS VEGAS, NEVADA
ENGINEERING DEPT.

BOUNDARY SURVEY OF S.W. 1/4,
N.W. 1/4, SECTION 25, T.20S., R.60E.,
M.D.B. & M. FOR ANNEXATION UNDER
ORDINANCE NO. 958

DRAWN BY: L.H.	CHKD. BY: <i>[Signature]</i>	APPROVED: <i>[Signature]</i>	FIELD REF.
DATE: 6-1-62	DATE: <u>6-22-62</u>	DATE: <u>6/15/62</u>	60-9X

053-67