


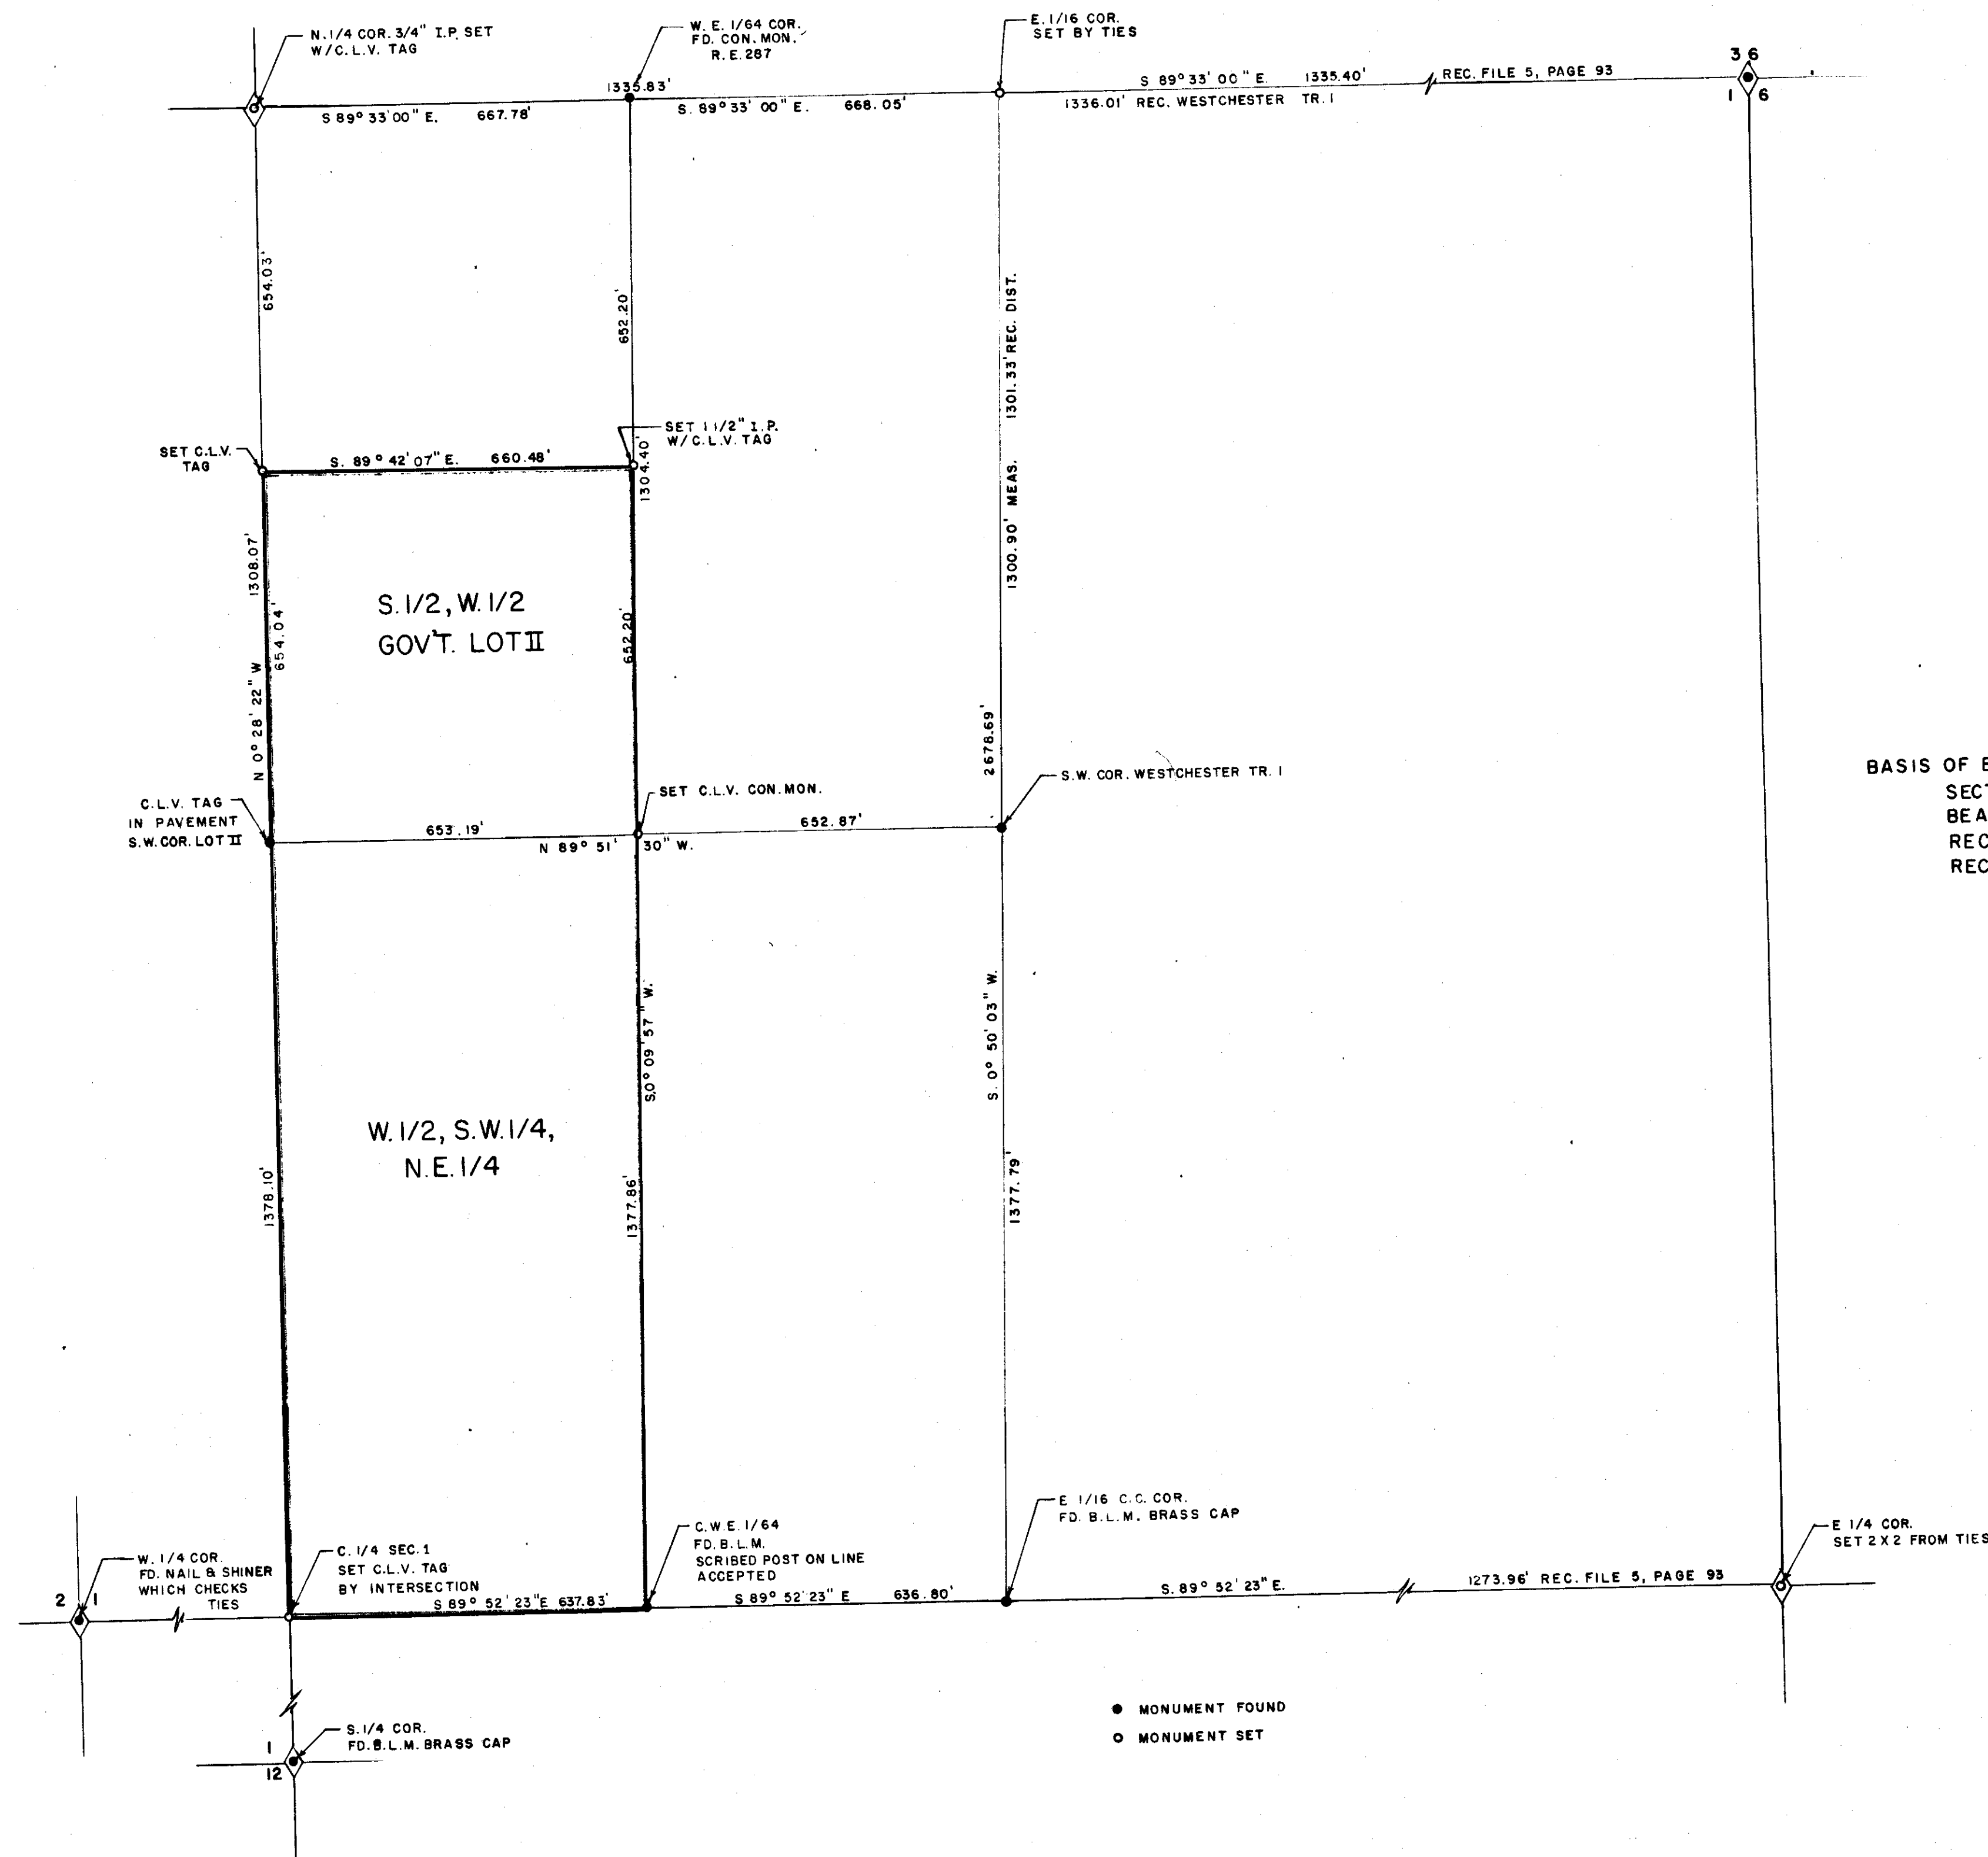

I, JAMES A. RANKIN, A DULY REGISTERED ENGINEER & LAND SURVEYOR, do hereby certify that this map truly and correctly represents the results of a survey made under my supervision and completed on the 26th day of May, 1962 of and for the City of Las Vegas, Nevada. This survey is not a subdivision as defined in Planning & Zoning Law as shown in 1943-1949 Supplement, Nevada Compiled Laws.


James A. Rankin
REGISTERED ENGINEER & LAND SURVEYOR
NEVADA R.E. NO. 1350

APPROVED this 6th day of JUNE, 1962

Paul C. O'Malley
CITY ENGINEER
NEVADA R.E. NO. 396

BASIS OF BEARINGS IS NORTH LINE OF SECTION 1, T. 21 S., R. 60 E., M. D. B. & M. BEARING S. 89° 33' 00" E. AS RECORDED IN CLARK COUNTY RECORDS IN BOOK 5, PAGE 95, OF PLATS

SCALE: 1" = 200'

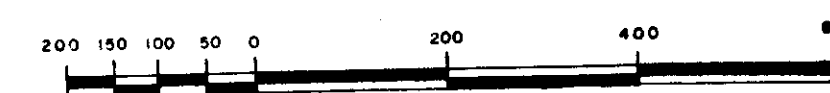

NO. 296940
FILED AT THE REQUEST OF
City of Las Vegas
Date 6/19/62 at 12:27 P.M.
FILE 11 PAGE 65
of Surveys
OFFICIAL RECORDS, BOOK NO. 368
CLARK COUNTY, NEVADA, RECORDS
PAUL C. O'MALLEY, RECORDER
For S.D.H. Deputy

CITY OF LAS VEGAS, NEVADA
ENGINEERING DEPT.

BOUNDARY SURVEY OF A PORTION OF SECTION 1, T. 21 S., R. 60 E., M. D. B. & M. ANNEXED TO THE CITY OF LAS VEGAS, NEVADA UNDER ORDINANCE NO. 963

DRAWN BY: L.H.	CKD. BY: <u>Paul C. O'Malley</u>	APPROVED: <u>VB. [Signature]</u>	FIELD REF
DATE 5-31-62	DATE 5-26-62	DATE 6-15-62	69-7X