


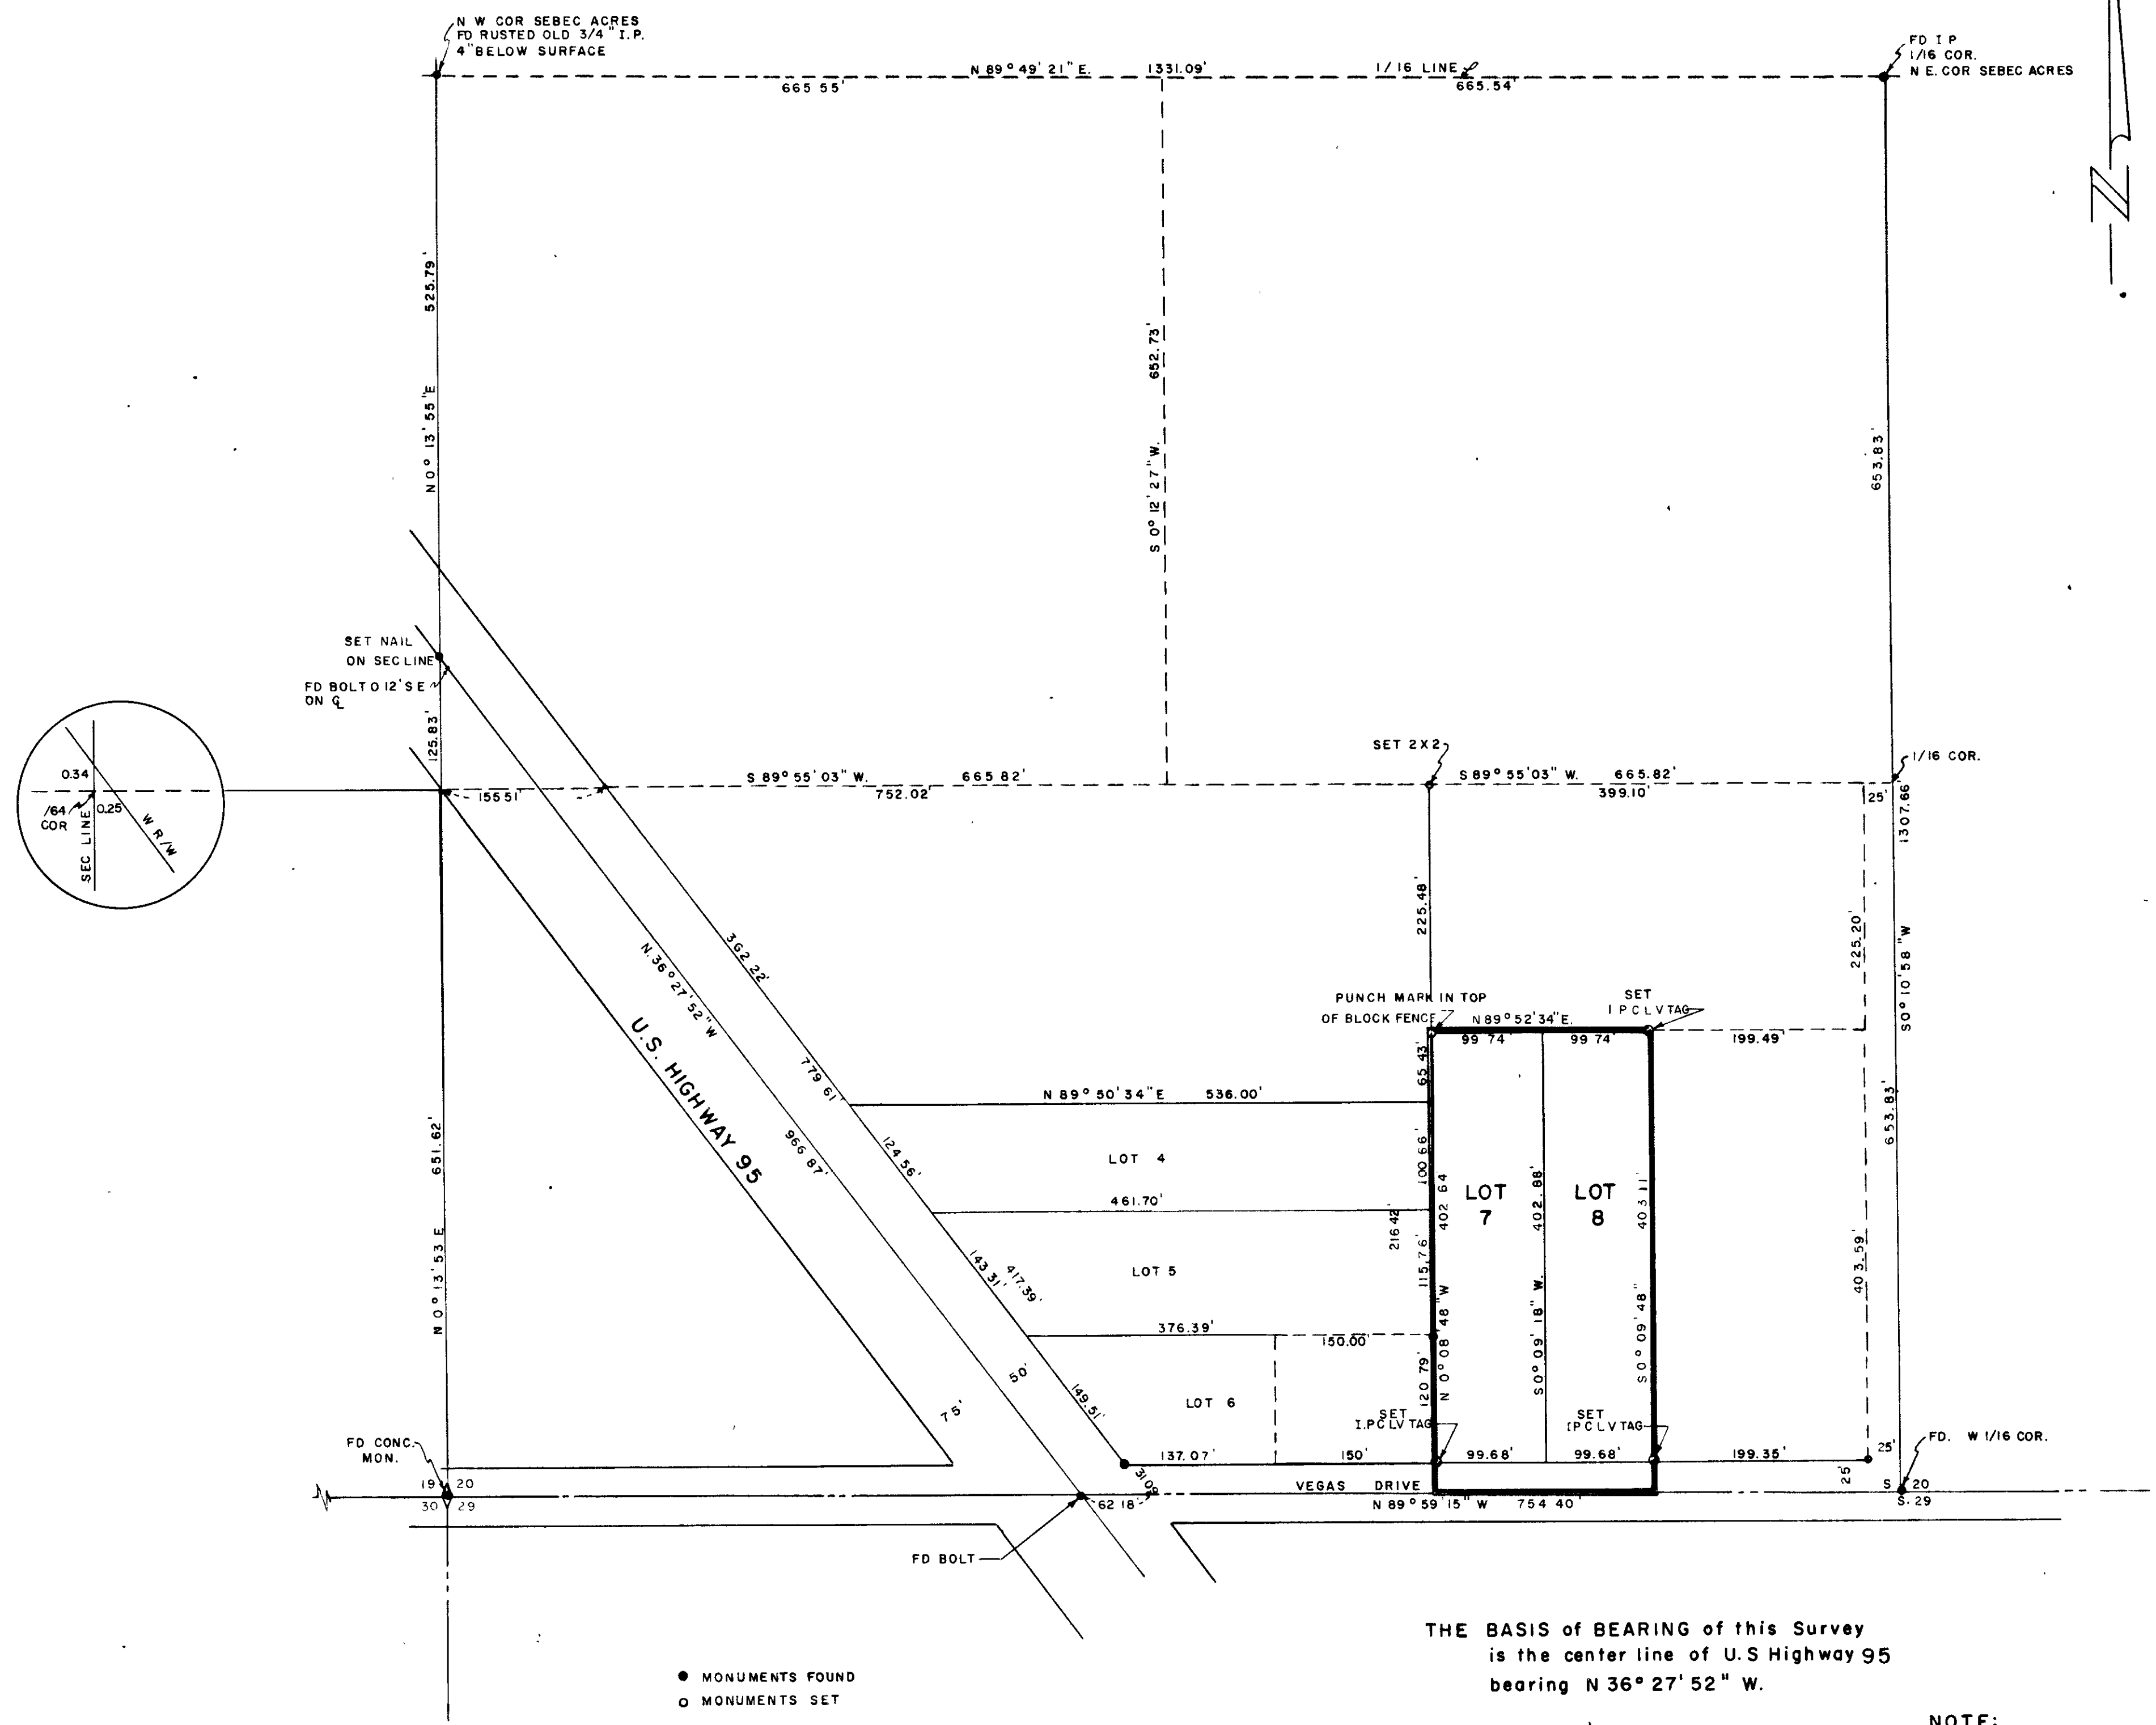


I, JAMES A. RANKIN, A DULY REGISTERED ENGINEER & LAND SURVEYOR, do hereby certify that this map truly and correctly represents the results of a survey made under my supervision & completed on the 1st day of March, 1963 of and for the City of Las Vegas, Nevada. This survey is not a subdivision as defined in Planning & Zoning Laws as shown in 1943-1949 Supplement, Nevada Compiled Laws.

James A. Rankin
REGISTERED ENGINEER & LAND SURVEYOR
NEVADA R.E. NO. 1350

APPROVED this 21st day of February, 1963

R. J. Hanes
CITY ENGINEER
NEVADA R.E. NO. 396

This is superseded
by a new recording
in process

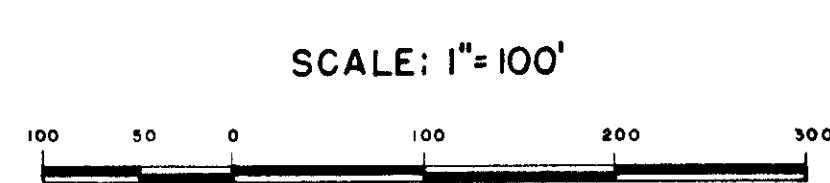

NOTE:
Portions of this survey are in disagreement with Record of Survey File 9, page 30 and book 2, page 28 of Plats in the office of County Recorder, County of Clark, Nevada

342020
RECORDED AT THE REQUEST OF
City of Las Vegas
DATE 2-26-63 AT 2:41 PM
OFFICIAL RECORDS BOOK NO. 344
CLARK COUNTY, NEVADA
PAUL E. HORN, RECORDER
FEE \$ 1.00 90 DEPUTY
FILE 12 PAGE 57

CITY OF LAS VEGAS, NEVADA ENGINEERING DEPT.				
BOUNDARY SURVEY OF A PORTION OF THE S.W. 1/4, S.W. 1/4, SECTION 20, T.20 S., R.60 E., M.D.B. & M. ANNEXED TO THE CITY OF LAS VEGAS, NEVADA. UNDER ORDINANCE NO. 968.				
DRAWN BY	L.H.	CKD. BY	J.A.R.	APPROVED
DATE				59-6X

053.81