


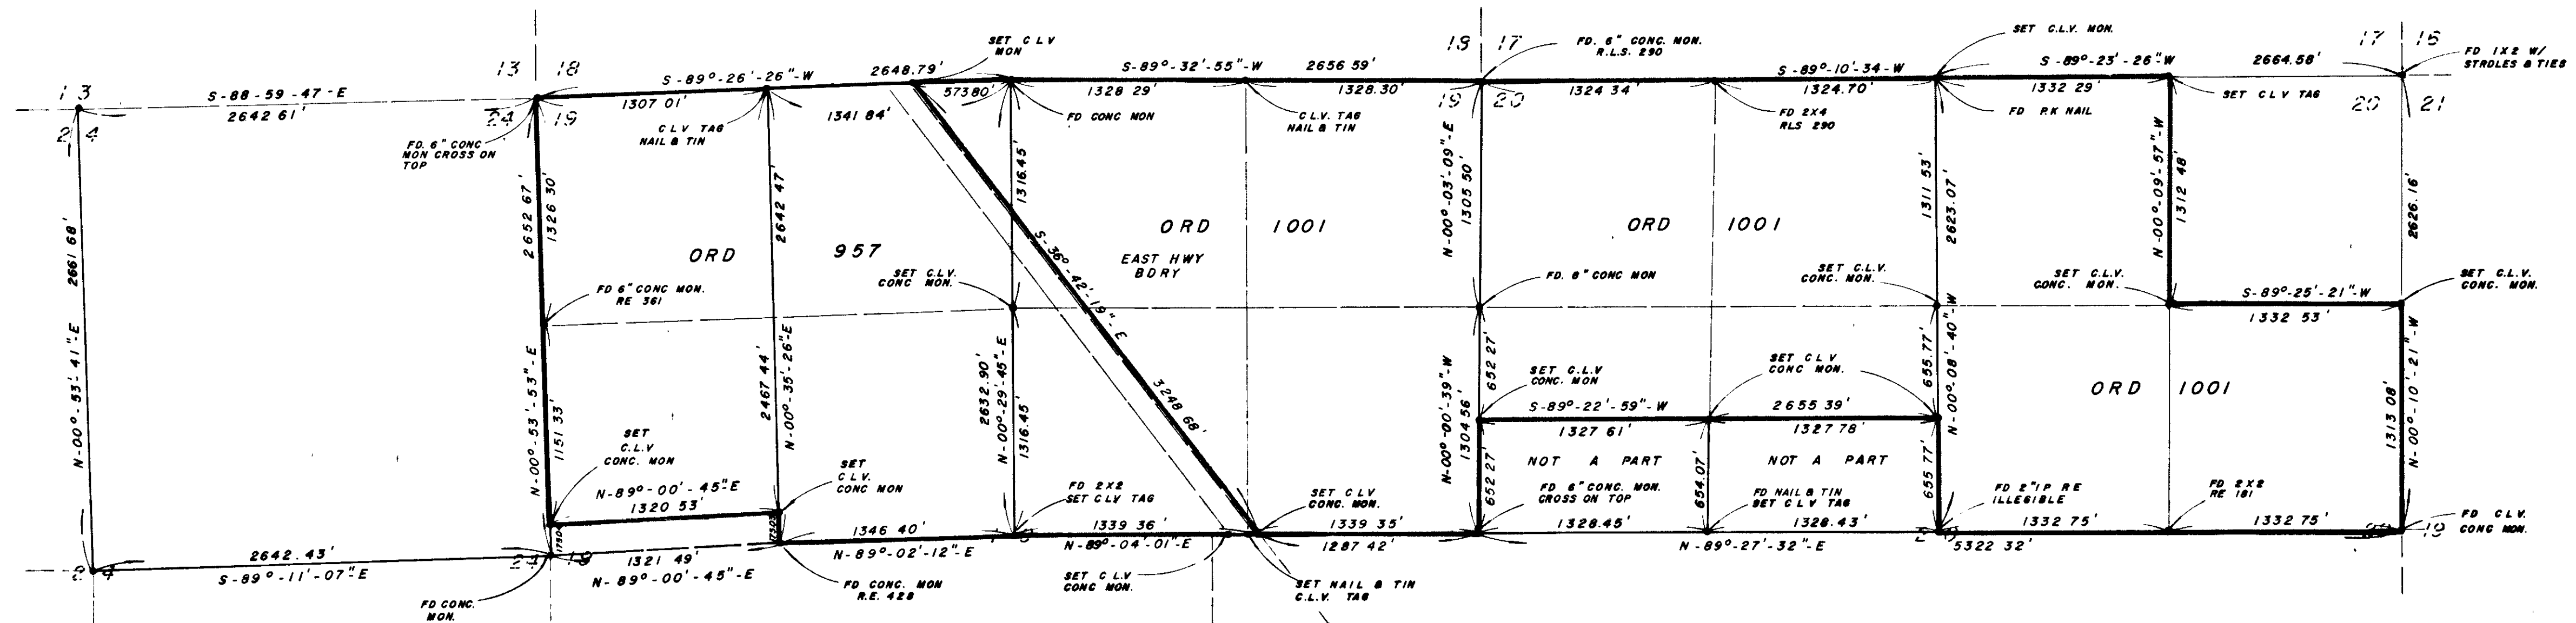

SURVEYORS CERTIFICATE


I, L BURL SMITH, A DULY REGISTERED LAND SURVEYOR, DO HEREBY CERTIFY THAT THIS MAP TRULY AND CORRECTLY REPRESENTS THE RESULTS OF A SURVEY MADE UNDER MY SUPERVISION AND COMPLETED ON THE 3rd DAY OF APRIL, 1963, OF AND FOR THE CITY OF LAS VEGAS, NEVADA. THIS SURVEY IS NOT A SUBDIVISION AS DEFINED IN THE PLANNING AND ZONING LAW AS SHOWN IN 1943-1949 SUPPLEMENT, NEVADA COMPILED LAWS.

L. Burl Smith
REGISTERED LAND SURVEYOR NO. 1412

APPROVALS


APPROVED THIS 15TH DAY OF APRIL 1963

P. H. Hester
CITY ENGINEER, NEVADA R.E. NO. 396

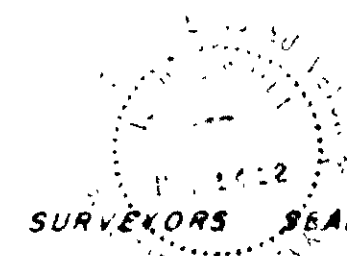

BASIS OF BEARINGS

THE BEARING N-00°-53'-41"-E. SHOWN AS THE NORTH & SOUTH CENTERLINE OF SECTION 24, T-20-S., R-60-E. M.D.B. & M. AS RECORDED IN FILE 12, PAGE 56, RECORDS OF CLARK COUNTY, NEVADA.

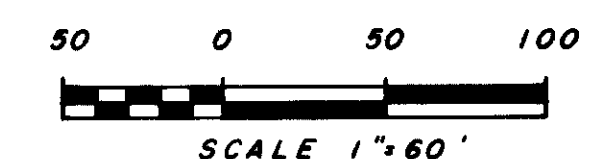

NO. 353399
RECORDED AT THE REQUEST OF
City of Las Vegas
DATE 4/17/63 AT 9:53 AM
OFFICIAL RECORDS BOOK NO. 138
CLARK COUNTY, NEVADA
PAUL E. HORN, RECORDER
FILE 12, Page 89

CITY OF LAS VEGAS, NEVADA
ENGINEERING DEPT.

BOUNDARY SURVEY OF THE N. 1/2 OF SECTION 19 & THE N. 1/2 OF SECTION 20 - T-20-S., R-61-E. M.D.B. & M. ANNEXED TO THE CITY OF LAS VEGAS, NEVADA ORDINANCE NO. 957 & ORDINANCE NO. 1001.

DRAWN BY C.D.B.	CKD BY	APPROVED	FILE REF
DATE 4-4-63	DATE	DATE	053-92.