608258

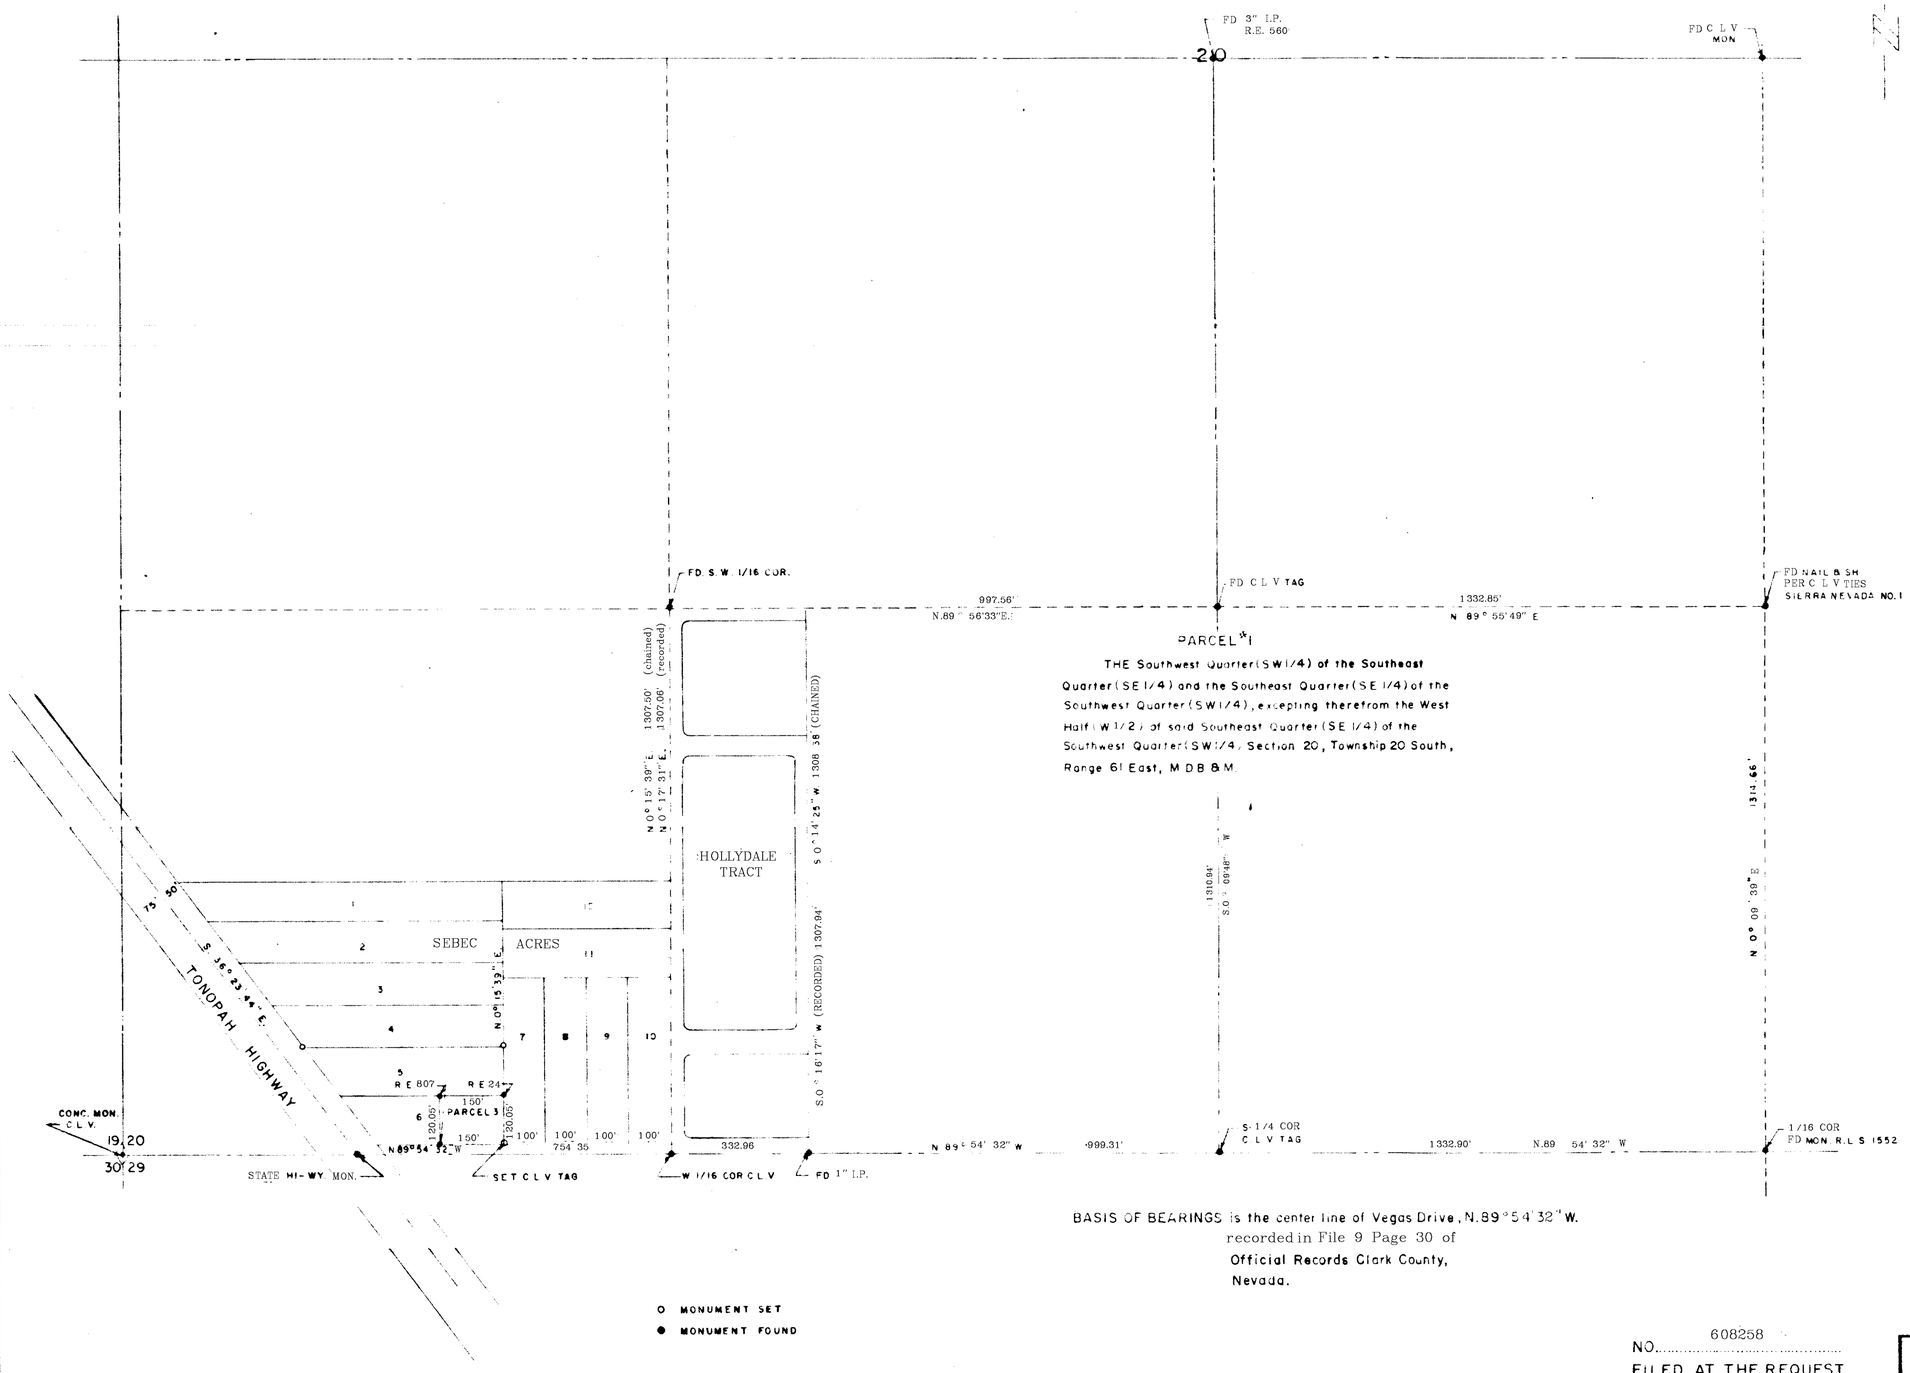

I, NOLAN D MITCHELL, A DULY REGISTERED LAND SURVEYOR, do hereby certify that this map truly and correctly represents the results of a survey made under my supervision and completed on the 4th day of October, 1966 of and for the City of Las Vegas, Nevada. This Survey is not a subdivision as defined in Planning & Zoning Law as shown in 1943–1949 Supplement, Nevada Compiled Laws.

NOLAN D. MITCHELL, REGISTERED
LAND SURVEYOR, NEVADA NO. 2094

APPROVED this 11th day of October, 1966

R P SAUER, CITY ENGINEER
NEVADA R.E. NO. 396

SCALE. 1"= 200'

150 100 50 0 100 200 300

BASIS OF BEARINGS is the center line of Vegas Drive, N.89°54'32"W. recorded in File 9 Page 30 of Official Records Clark County, Nevada.

O MONUMENT SET
● MONUMENT FOUND

NO. 608258
FILED AT THE REQUEST OF CITY OF LAS VEGAS
DATE 11-9-66 AT 11:30 AM
FILE 17 PAGE 16
OF SURVEYS
OFFICIAL RECORD BOOK NO. 757
CLARK COUNTY, NEVADAM RECORDS
PAUL E. HORN RECORDER
FEE: ~~4~~ DEPUTY

CITY OF LAS VEGAS, NEVADA
ENGINEERING DEPT.

BOUNDARY SURVEY OF PORTIONS OF SOUTH 1/2 OF SECTION 20, T.20S., R.61E., M.D.B.&M. ANNEXED TO THE CITY OF LAS VEGAS, NEVADA UNDER ORDINANCE NO 1255
PARCELS NO 1 & 3

DRAWN BY: L.H.	CKD BY: R.D.H.	APPROVED:	FIELD REF.
DATE 10-7-66	DATE 10-14-66	DATE:	60-7X-.

3-43

SHEET NO. 1 OF 2 SHEETS

FILE 053-162