




CERTIFICATE

I, NOLAN D. MITCHELL, A DULY REGISTERED LAND SURVEYOR, do hereby certify that this map truly and correctly represents the results of a survey made under my supervision and completed on the 23 day of JUNE, 1972 of and for the City of Las Vegas, Nevada. This survey is not a subdivision as defined in Planning & Zoning Law as shown in 1943-1949 Supplement, Nevada Compiled Laws.

Nolan D. Mitchell
 NOLAN D. MITCHELL, REGISTERED LAND SURVEYOR
 NEVADA NO. 2094

APPROVED this 26th day of JULY, 1972

R. P. Sauer
 R. P. SAUER, CITY ENGINEER
 NEVADA R.E. 396

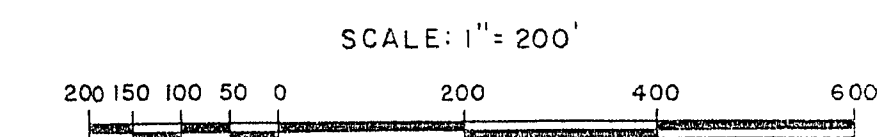

BASIS OF BEARING:
 The S. line of the N.W. 1/4,
 Sec. 25, T. 20S, R. 60E., M.D.B. & M.
 Bearing N. 88° 00' 59" E. as per
 Book 7, Page 100 of plats.

- MONUMENTS FOUND
- MONUMENTS SET

NO. 209169
 FILED AT THE REQUEST OF
 City of Las Vegas, Nevada
 DATE 7-27-72 at 9:15 AM
 FILE 23 PAGE 46
 of Surveys
 OFFICIAL RECORDS BOOK NO. 250
 CLARK COUNTY, NEVADA, RECORDS
 PAUL E. HORN, RECORDER
 Fee \$ DH Deputy GV
EF

CITY OF LAS VEGAS, NEVADA ENGINEERING DEPT.			
BOUNDARY SURVEY OF EAST HALF (E. 1/2) OF THE EAST HALF (E. 1/2) OF THE NORTHWEST QUARTER (N.E. 1/4) OF THE NORTHWEST QUARTER (N.W. 1/4) OF SEC. 25, T. 20S., R. 60E., M.D.B. & M. ANNEXED TO THE CITY OF LAS VEGAS, NEVADA UNDER ORDINANCE NO. 1586			
DRAWN BY: L.H.	CKD. BY: N. D. M.	APPROVED: R. P. S.	FIELD REF.
DATE 6-30-72	DATE 7-25-72	DATE 7-25-72	63-6X

(3-31)