


I, NOLAN D. MITCHELL, A DULY REGISTERED LAND SURVEYOR, do hereby certify that this map truly and correctly represents the results of a survey made under my supervision and completed on the 14th day of April, 1966 of and for the City of Las Vegas, Nevada. This survey is not a subdivision as defined in Planning & Zoning Law as shown in 1943-1949 Supplement, Nevada Compiled Laws.

N.D. Mitchell
N.D. MITCHELL, REGISTERED LAND SURVEYOR
 NEVADA NO. 2094

APPROVED this 6TH day of JUNE, 1966

R.P. SAUER, CITY ENGINEER
 NEVADA R E NO. 396

BASIS OF BEARINGS IS THE NORTH LINE OF SECTION 1, T21S, R 60E, BEARING N 89° 33' 00" W ON FILE WITH THE BUREAU OF LAND MANAGEMENT, DEPENDENT RESURVEY 1953

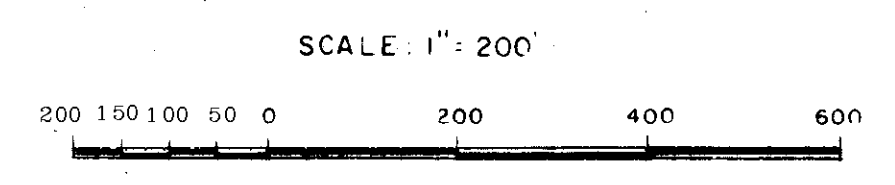

● MONUMENT FOUND
 ○ MONUMENT SET

584068
 NO FILED AT THE REQUEST OF CITY OF LAS VEGAS DATE **6-29-66 8:53 A.M.** FILE **16** PAGE **86**
 OFFICIAL RECORDS, BOOK NO. **727** CLARK COUNTY, NEVADA RECORDS
 PAUL E. HORN, RECORDER
 FEE **DH**, **EM** DEPUTY

CITY OF LAS VEGAS, NEVADA ENGINEERING DEPT.			
BOUNDARY SURVEY OF A PORTION OF SECTION 1, T 21S, R 60E, M.D.B. & M. ANNEXED TO THE CITY OF LAS VEGAS, NEVADA UNDER ORDINANCE NO. 1234			
DRAWN BY LH	CHKD BY RH	APPROVED	FIELD REF
DATE 4 2 66			60-7X