

Ctr. 1/4 Cor.
Set 2"x2" by Int.

RECORD BEARING THIS LINE
N88°58'22"W File 11 Page 72

E 1/4 Cor.
Fd 2"x2" Tagged R.E. 361

To be set by CLK

CERTIFICATE

I, B.L. Ortiz, a duly Registered Land Surveyor of the State of Nevada, do hereby certify that this map, consisting of one sheet, correctly represents a true and complete survey made under my supervision at the instance of The City of Las Vegas, Nevada, pursuant to Annexation Ordinance No. 1105; that the monuments shown hereon are in place, that their positions and character are correctly shown, and that said monuments are sufficient to enable the survey to be retraced; that the survey was completed on March 10, 1964. This is not intended to be a subdivision.



B. L. Ortiz
B. L. Ortiz Nevada R.L.S. No. 735

RECORD BEARINGS THIS LINE
S 1/2 1/4 16" W File 10 Page 12
N 1/2 1/4 47" W " " 11 " 72

RECORD BEARING THIS LINE
N89°19'22"E File 11 Page 72

BASIS OF BEARINGS

The Nevada Coordinate System - East Zone.


Scale: N 1" = 300'

APPROVAL

APPROVED this 12th day of October, 1964.

[Signature]
CITY ENGINEER
Nevada R.E. No. 396

GRAPHIC SCALE

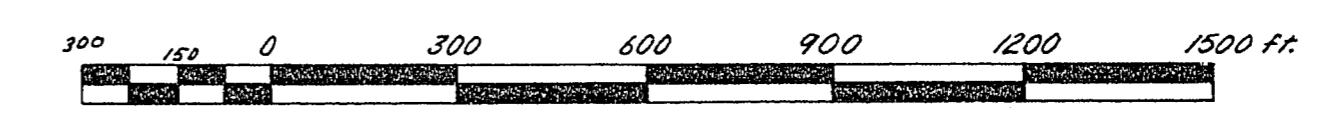


Fd. Conc. Mon. 4 3/4" I.P.



RECORD BEARINGS THIS LINE
S87°56'46"W File 10 Page 12
N85°40'29"E " " 72

NOTE: Established Sec. Cor. by retracement of J.T. McWilliams survey of 10/28/26.

C.L.V. Ord. 1105
Area: 96.66 AC.

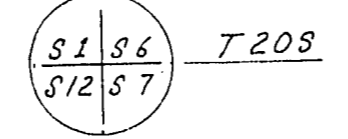

Set std. CIV. 6" Conc. Mon. w/disk (Typical)

E 1/4 Cor. Sec. 12
Set PK. & CLK tag in caliche 6" below surface

Ctr. 1/4 Cor.
Fd. Conc. Mon. 4 3/4" I.P.

BOUNDARY SURVEY OF
E², SW², NE², SE², & SE², NE², SE², & E²,
SE², SE², Sec. 1 and E², NE², NE², &
SE², NE², Sec. 12, T20S, R80E, M.D.B.M.
Annexed to the City of Las Vegas,
Nevada, under Ordinance No. 1105.

NO. 473983
FILED AT THE REQUEST OF
City of Las Vegas
Date 12-2-64 at 10:30 AM
FILE 15... PAGE 49...
of Surveys
OFFICIAL RECORDS BOOK NO. 589
CLARK COUNTY, NEVADA, RECORDS
PAUL E. HORN, RECORDER
Fee \$ *dt* Deputy