


N O T E

The east line of Section 13 has been the subject of dispute. The section line as shown hereon is based upon evidence from many sources. The possession lines are in conflict with the actual section line. It is the opinion of this surveyor that the intent of past conveyances and consequently the intent of annexation is based upon possession as opposed to the true section line. This surveyor has no authority to render a judicial decision on the facts concerning the difference between the possessed line and the section line and cannot therefore assume liability for the correctness of the interpretation made hereon. Until such time as a judicial decision is rendered in a court of law, the lines hereon are subject to relocation.

C E R T I F I C A T E

I, Jack K. Leavitt, Registered Professional Engineer and Land Surveyor, do hereby certify that this map truly and correctly represents the results of a survey made under my supervision and completed on the 15th day of February, 1964 and for the City of Las Vegas, Nevada. This survey does not constitute a subdivision as defined by Nevada State Law.

Jack K. Leavitt
JACK K. LEAVITT
 Registered Professional Engineer
 Land Surveyor R.L.S. 807

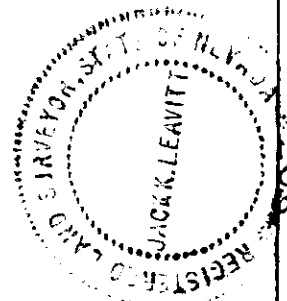

R E F E R E N C E S U R V E Y S

- Registered Professional Engineer's File, Clark County, Nevada, Records:
 File 1, Page 3
 File 1, Page 61
 File 1, Page 37
 File 1, Page 73
 File 2, Page 23

L E G E N D

- Indicates point found - as shown
- Indicates point set - 3/8" reinforcing bar with aluminum cap topped R.L.S. 807 - C.L.V.'s concrete
 Scale: 1" = 300'
- Basis of Bearings: South Line of the Southeast 1/4 of Section 13, T.20S, R.60E, M.D.B. & M.
 Registered Professional Engineer's File 5, Page 62, Clark County Records, Clark County, Nevada, N 88° 42' 42" W
- Indicates point set - 3/8" reinforcing bar with aluminum cap topped R.L.S. 807 - C.L.V. set flu Paving
 Reference Surveys: Registered Professional Engineer's File 5 Page 62, & File 12 Page 8, Clark County Records, Clark County, Nevada.

A P P R O V A L S

Approved this 9th day of September, 1964.

E. P. Sauier
E. P. SAUIER
 City Engineer R.E. 396

SCALE: 1" = 200'

NO. **473995**
 FILED AT THE REQUEST OF
LAS VEGAS, NEVADA
 Date **12-2-64** at **11:04** M
 FILE **15** PAGE **61**
 of Surveys
 OFFICIAL RECORDS BOOK NO. **589**
 CLARK COUNTY, NEVADA, RECORDS
PAUL E. HORN, RECORDER
 Fee \$ **dh** **gt** Deputy

CITY OF LAS VEGAS, NEVADA CITY ENGINEERING DEPT.			
BOUNDARY SURVEY OF PORTIONS OF SEC. 13, T. 20S, R. 60E, M. D. B. & M., CLARK COUNTY, NEVADA ANNEXED TO THE CITY OF LAS VEGAS, NEVADA UNDER ORDINANCE N ^o 975 AND 1002			
DWN BY DATE	CHKD BY DATE	APPROVED BY DATE	FILE REF 053-140