


**C E R T I F I C A T E**  
 I, Jack E. Leavitt, Registered Professional Engineer and Land Surveyor do hereby certify that this map truly and correctly represents the results of a survey made under my supervision and completed on the 13<sup>th</sup> day of February, 1964, of and for the City of Las Vegas, Nevada. This survey is not a subdivision as defined by Nevada State Law.

*Jack E. Leavitt*  
 JACK E. LEAVITT  
 Registered Professional Engineer  
 Land Surveyor EL 5307

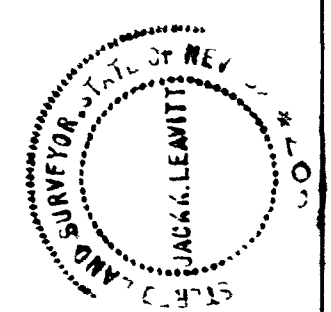

**A P P R O V A L S**  
 Approved this 9<sup>th</sup> day of Sept., 1964

*E. P. Salizez*  
 E. P. SALIZEZ  
 City Engineer - EE 396

- LEGEND**
- Indicates point found - as shown
  - Indicates point set - 1/2" reinforcing bar with aluminum cap topped PL S 207 - CLV set in concrete base of Elevation North Line of Northwest 1/4 of Section 1, T215, R60E, M.D.B.M. as per Registered Professional Engineers File 10, Page 95 Clark County Records, Clark County, Nevada - N 59° 38' 00" W Distance Survey - E.P.E. File 10, Page 95, Clark County Records, Clark County, Nevada Scale 1"=300'
  - Indicates point set - 1/2" reinforcing bar with aluminum cap topped PL S 207 - CLV flush with A.C. Flange.
  - Indicates point set - as shown
  - Indicates point set - as shown

NO. 473994  
 FILED AT THE REQUEST OF  
CITY OF LAS VEGAS  
 DIST. 2-2-64 - 11:23 AM  
 FILED IN FILE 15 - PAGE 6  
 of Surveys  
 OFFICIAL RECORDS BOOK NO. 588  
 CLARK COUNTY, NEVADA, RECORDS  
 PAUL E. HORN, RECORDER  
 Fee \$ 1.00 - 90 - 0000

CITY OF LAS VEGAS, NEVADA  
 CITY ENGINEERING DEPT.

BOUNDARY SURVEY OF PORTIONS OF SECTION 1,  
 T215, R60E, M.D.B.M., CLARK COUNTY, NEVADA  
 ANNEXED TO THE CITY OF LAS VEGAS, NEVADA  
 UNDER ORDINANCE NOS. 1066 AND 1078

DRAWN BY	CHEK BY	APPROVED	FILE REF.
DATE	DATE	DATE	
<i>ELC</i>			063-137

9584

