

● MONUMENT FOUND
○ MONUMENT SET


BASIS OF BEARINGS IS NORTH LINE OF SECTION 1,
T.21S., R. 60E., M.D.B. & M. BEARING
S. 89° 33' 00" E. AS RECORDED IN CLARK
COUNTY RECORDS OFFICE IN BOOK 5,
PAGE 95, OF PLATS.

I, JAMES A. RANKIN, A DULY REGISTERED ENGINEER &
LAND SURVEYOR, do hereby certify that this map truly and correctly
represents the results of a survey made under my supervision and
completed on the 13 day of May, 1962 of and for the
City of Las Vegas, Nevada. This survey is not a subdivision as defined
in Planning & Zoning Law as shown in 1943-1949 Supplement,
Nevada Compiled Laws.

James A. Rankin
REGISTERED ENGINEER & LAND SURVEYOR
NEVADA R.E. NO. 1350

APPROVED this 20 day of May, 1962

R. J. Jones
CITY ENGINEER
NEVADA R.E. NO. 396

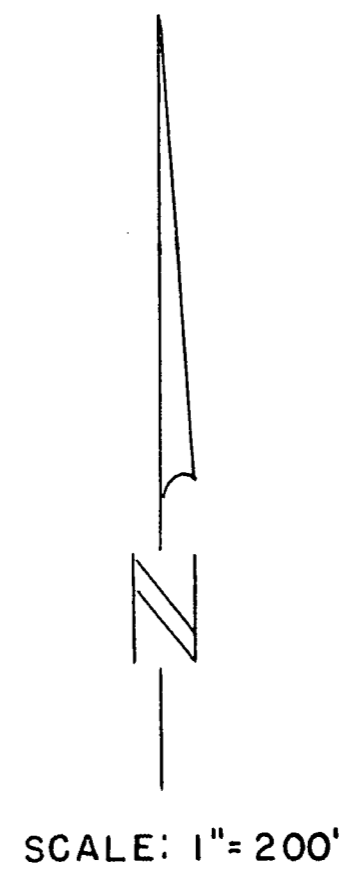

CITY OF LAS VEGAS, NEVADA ENGINEERING DEPT.			
BOUNDARY SURVEY OF A PORTION OF NE. 1/4, SECTION 1, T. 21 S., R. 60 E., M. D. B. & M. ANNEXED TO THE CITY OF LAS VEGAS, NEVADA UNDER ORDINANCE NO. 945			
DRAWN BY: L.H.	CKD BY:	APPROVED:	FIELD REF.
DATE 5-14-62	DATE 5-15-62		60-7 X

CITY OF LAS VEGAS
6-5-62 2:23 P.
" " 49
365
S.D.H. J.S.