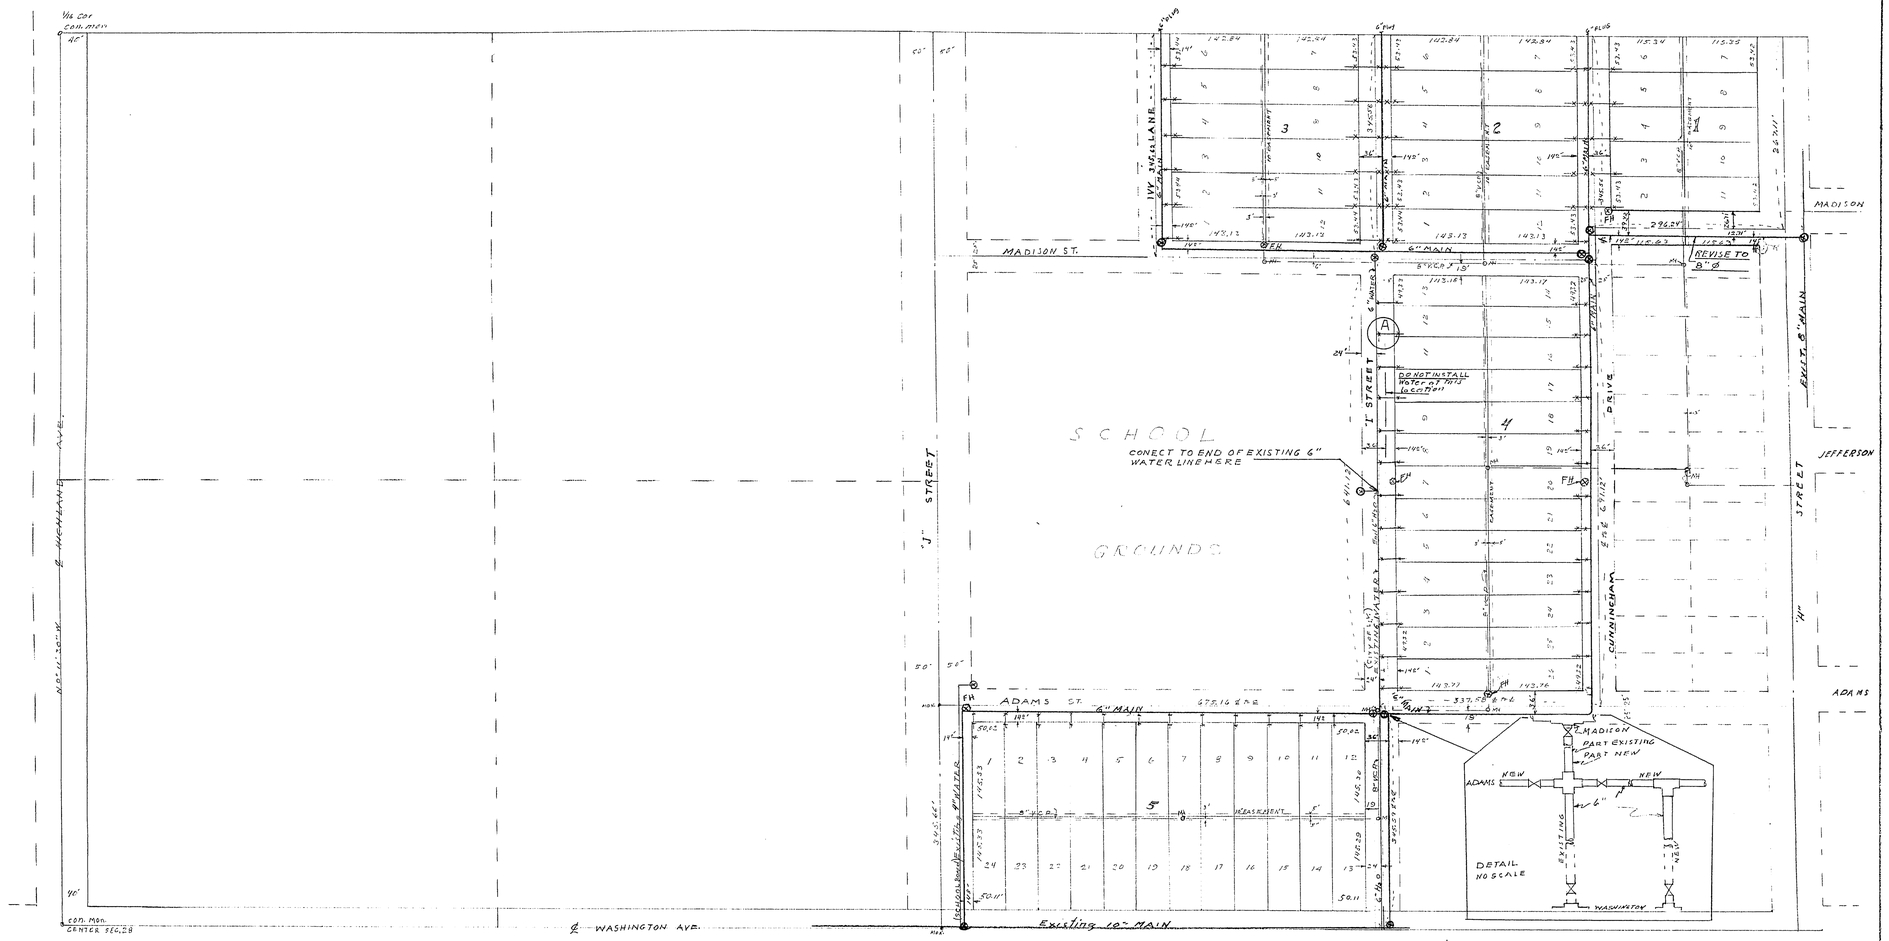

APPROVALS

LAS VEGAS VALLEY WATER DISTRICT

Approved this day of August, 1954

Las Vegas Valley Water District

General Manager.

=0=

CITY of LAS VEGAS

Approved this day of August, 1954

for the FIRE DEPARTMENT

FIRE CHIEF

Approved this day of August, 1954

for the ENGINEERING DEPARTMENT

CITY ENGINEER

Engineer's Certificate

I, Robert H. Cordill, Registered Engineer No. 720

do hereby certify that this map of the ~~existing~~ new ~~sewer or~~ ~~and~~ proposed water system strictly conforms to field conditions and the recorded plat of this subdivision.

Robert H. Cordill

Reg. Eng'r. No. 720 - Land Surveyor.

LEGEND

WATER MAINS ——— ALL 6" Ø

⊗ MAIN VALVES

× LATERAL VALVES

SERVICE LATERALS ———

⊗FH FIRE HYDRANT (6)

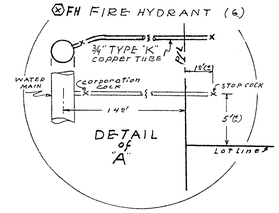

N

SCALE: 1" = 100'

C-5-18

REVISIONS

Sept. 13, 1957 OK. CITY ENGR.

B.M. JONES SUBDIVISION

A PORTION OF THE ZAUGG TRACT

Recorded in Book 3 of PLATS, Pg. 93.

WATER ~~& SEWER~~ exist & new PLAN

LAS VEGAS - NEVADA

17-646 567Y - 860-1