



APPLE VALLEY LANE

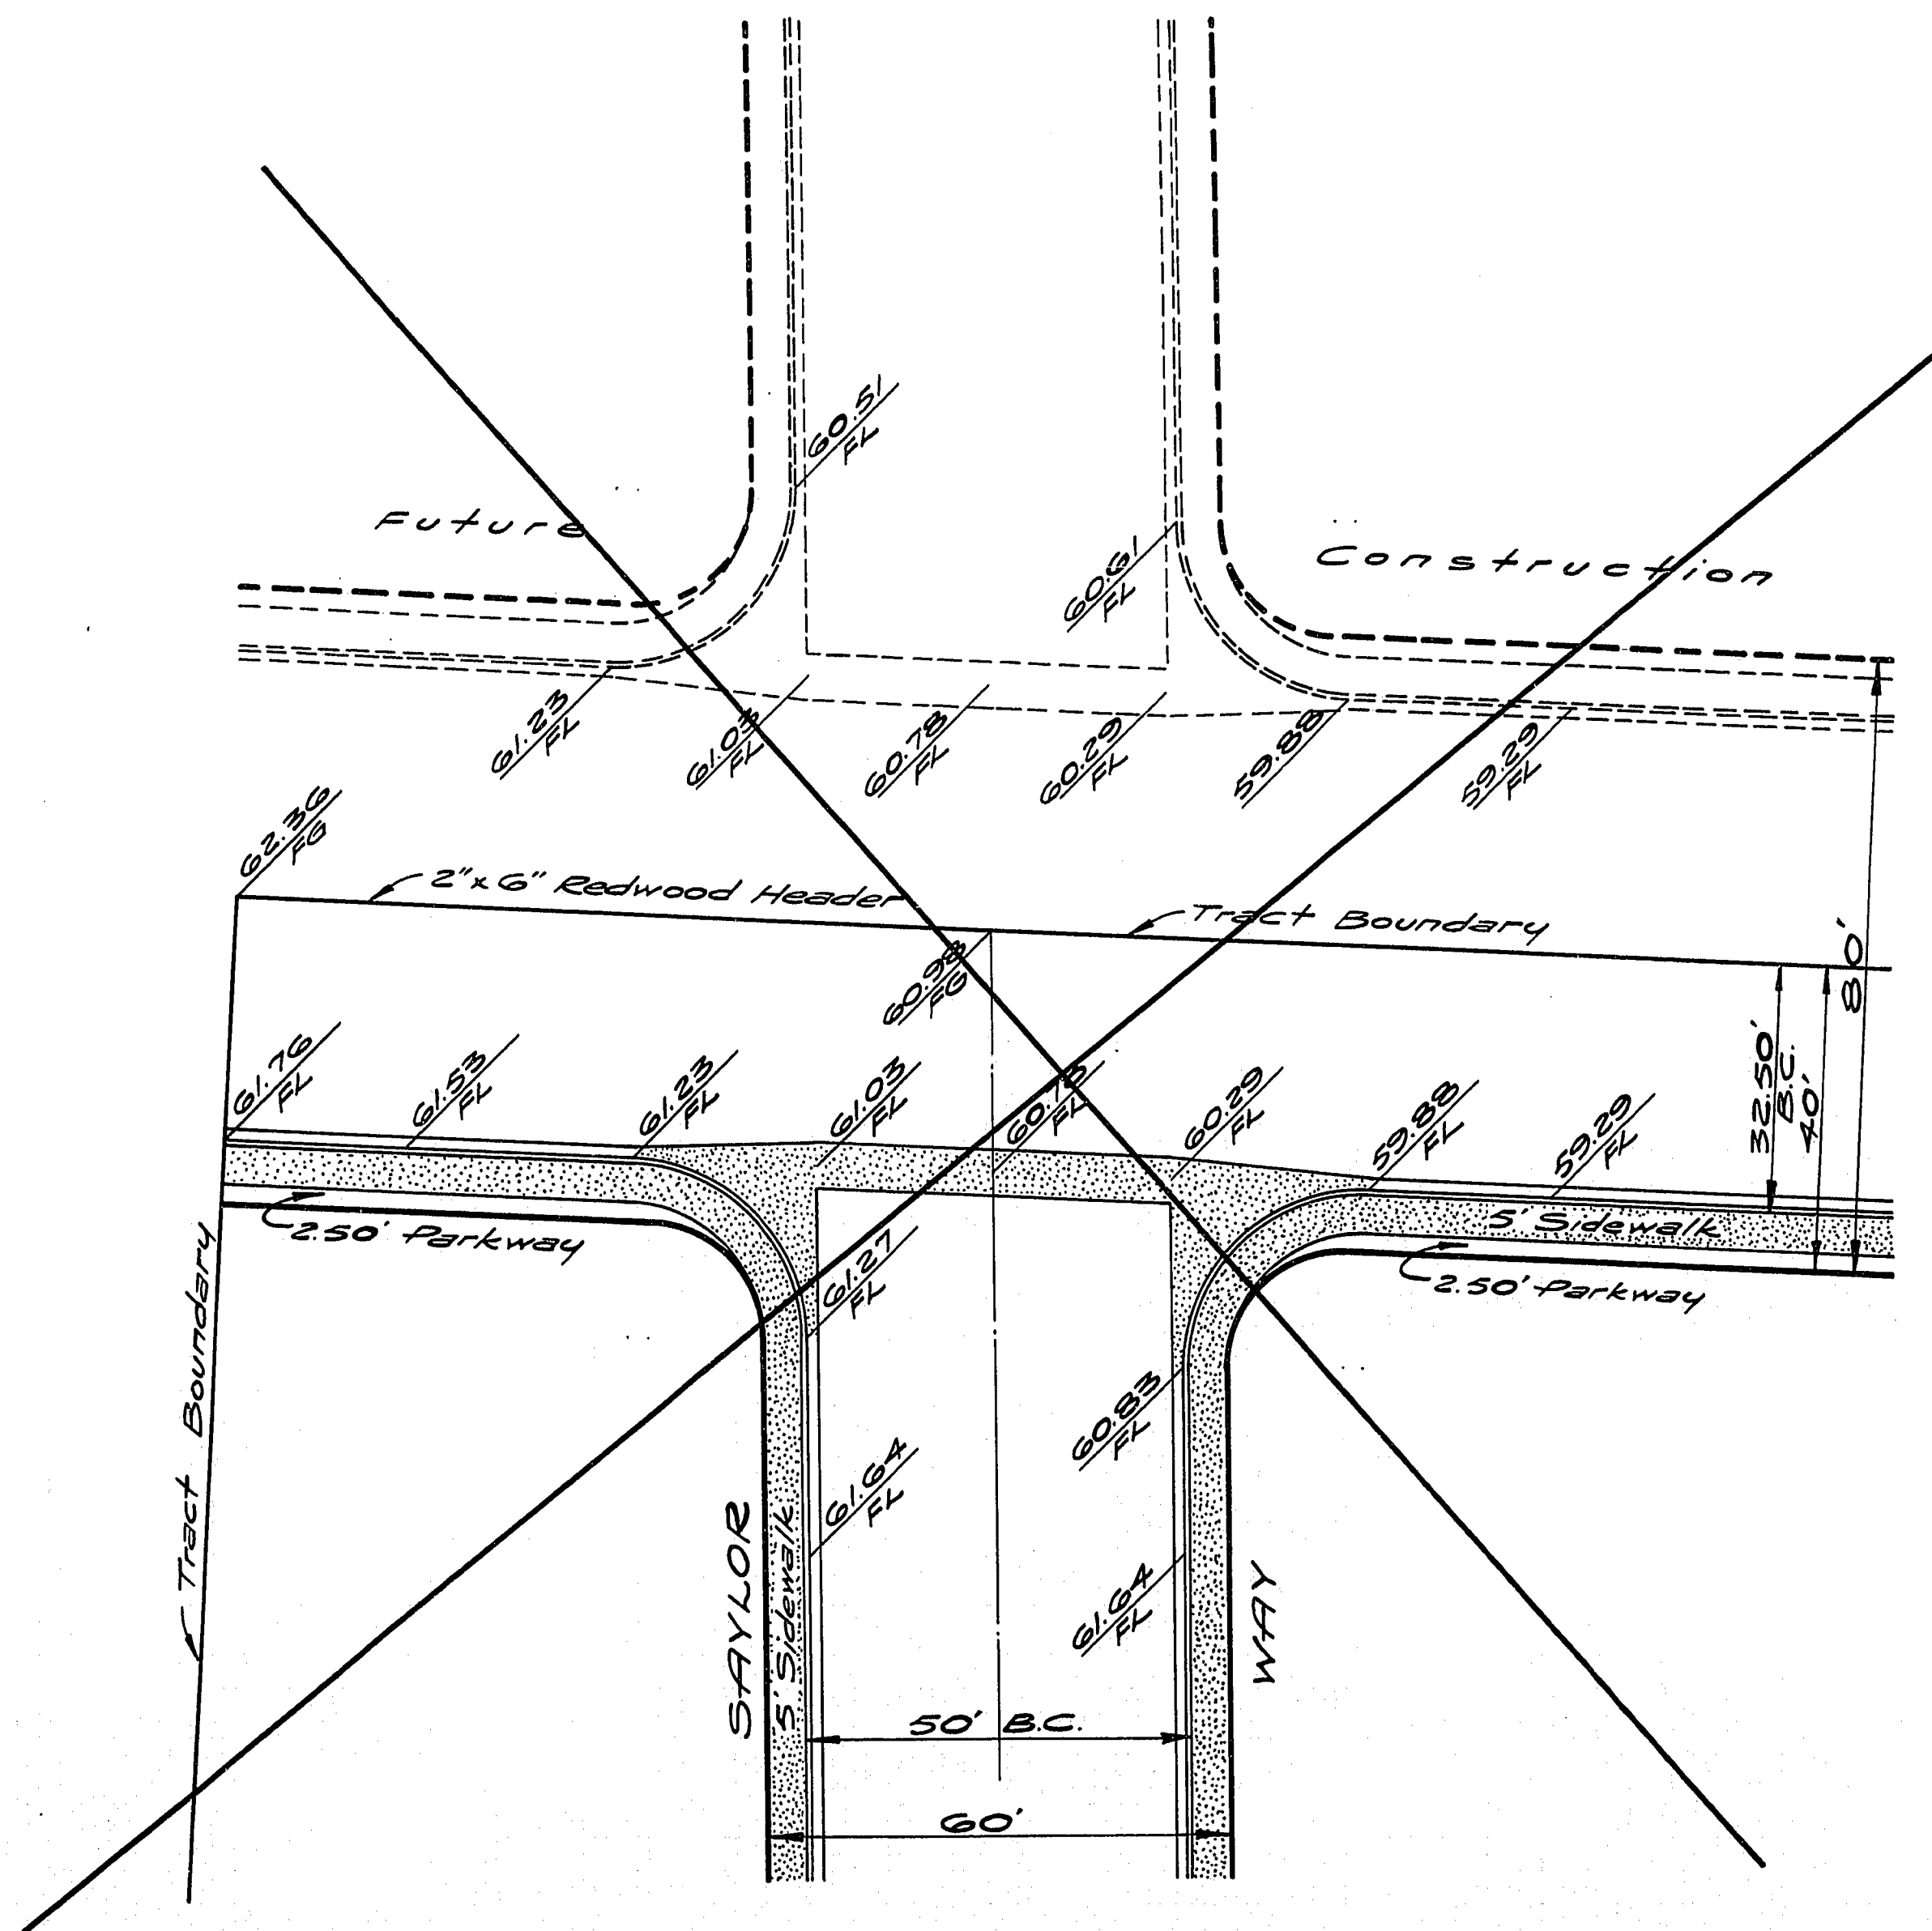

VEGAS DRIVE

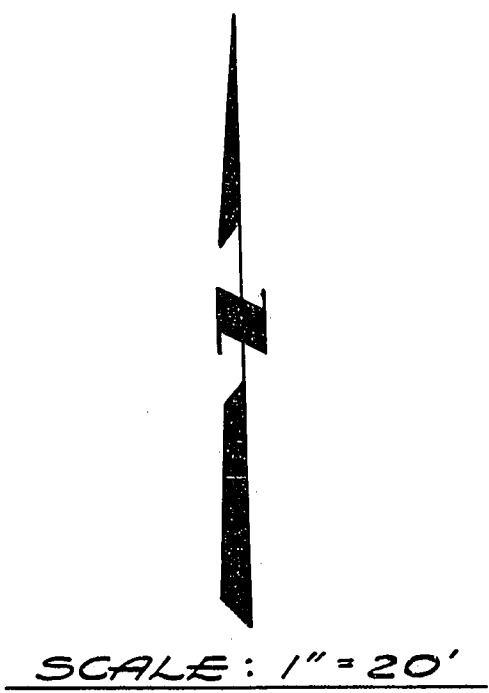

APPROVALS
Victor B. Wiley 1-8-63
 City Engineer Date
J. R. ... 1-9-68
 Field Engineer Date

CHARLESTON HEIGHTS
UNIT NO 44-A

STREET INTERSECTIONS

DESIGNED	WESTERN ENGINEERS, INC.	SHEET
DRAWN	LAS VEGAS NEVADA	4
CHECKED	APPR DATE	OF
		6