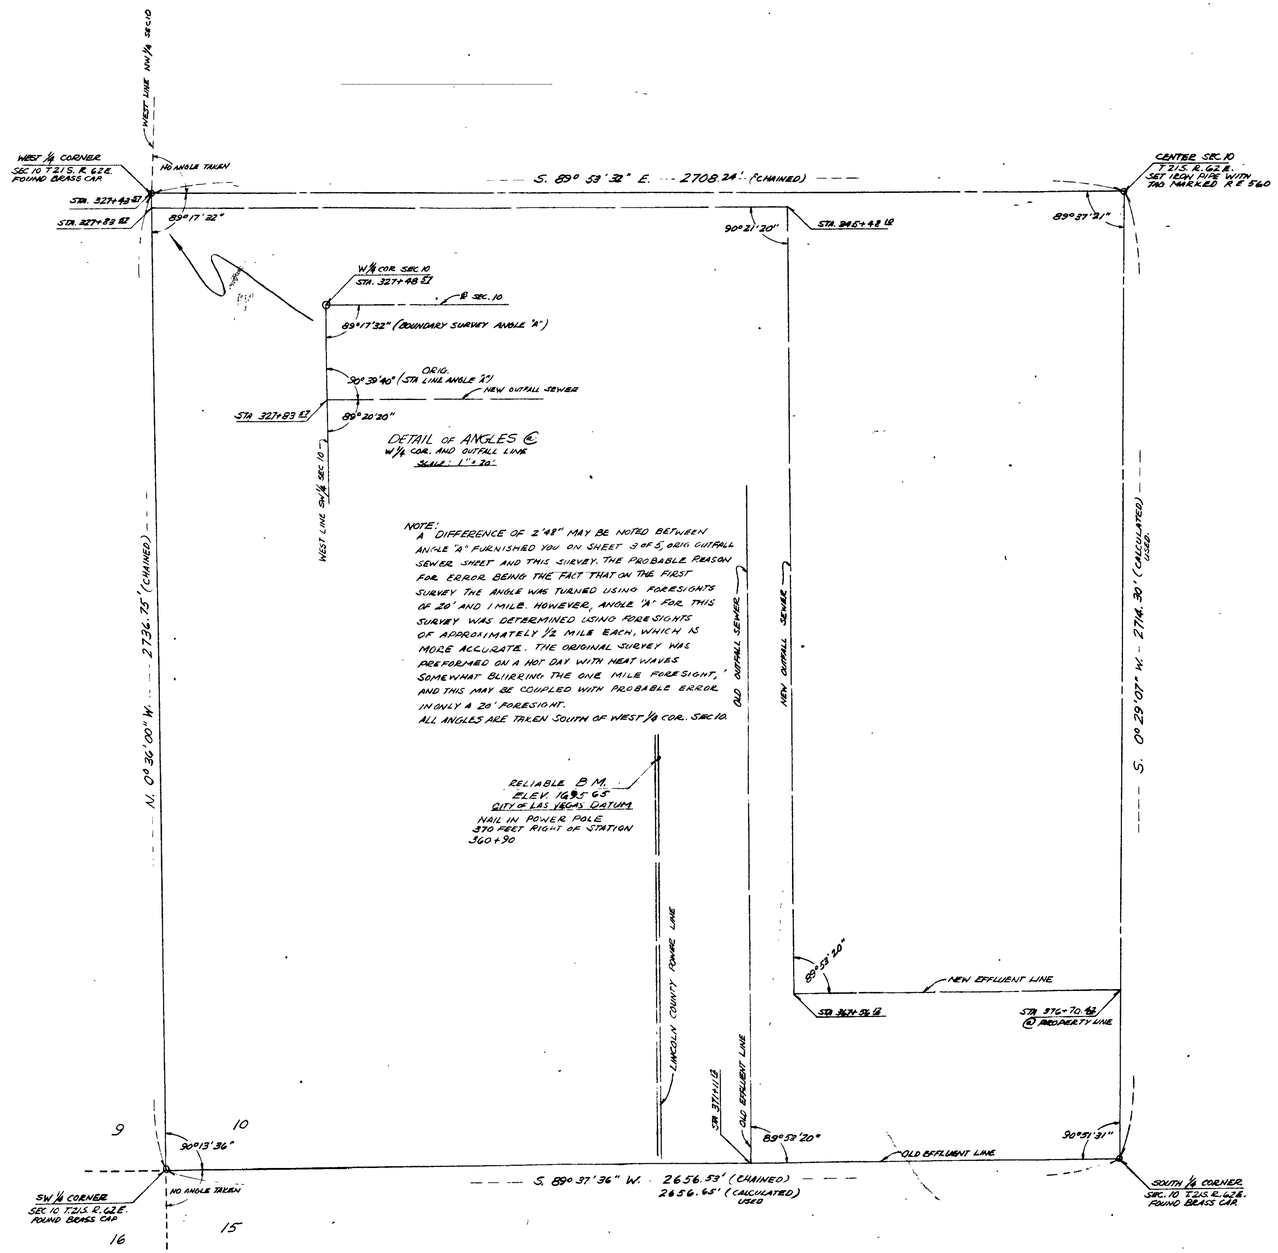

BASIS OF BEARING: (N 0°36'00" W) WEST LINE OF THE SW 1/4 SECTION 10 T.21S. R.62E. DEPENDENT RESURVEY UNITED STATES DEPARTMENT OF THE INTERIOR, BUREAU LAND MANAGEMENT.

BOUNDARY SURVEY OF SW 1/4
SEC. 10 T.21S. R.62 E. M.D.B.&M.
PREPARED FOR
HEADMAN, FERGUSON & CAROLLO
CONSULTING ENGINEERS

DATE JAN. 3 1955

DESIGNED BY
DRAWN BY
CHECKED BY

SCALE: AS SHOWN

TYSON ENGINEERING COMPANY
CONSULTING ENGINEERS
211 E. CHARLESTON BLVD. LAS VEGAS, NEV.

SHEET 1 OF 1 SHEETS

9-41

055-157