



FOR ADDITIONAL DESIGN REQUIREMENTS SEE USD #236

A

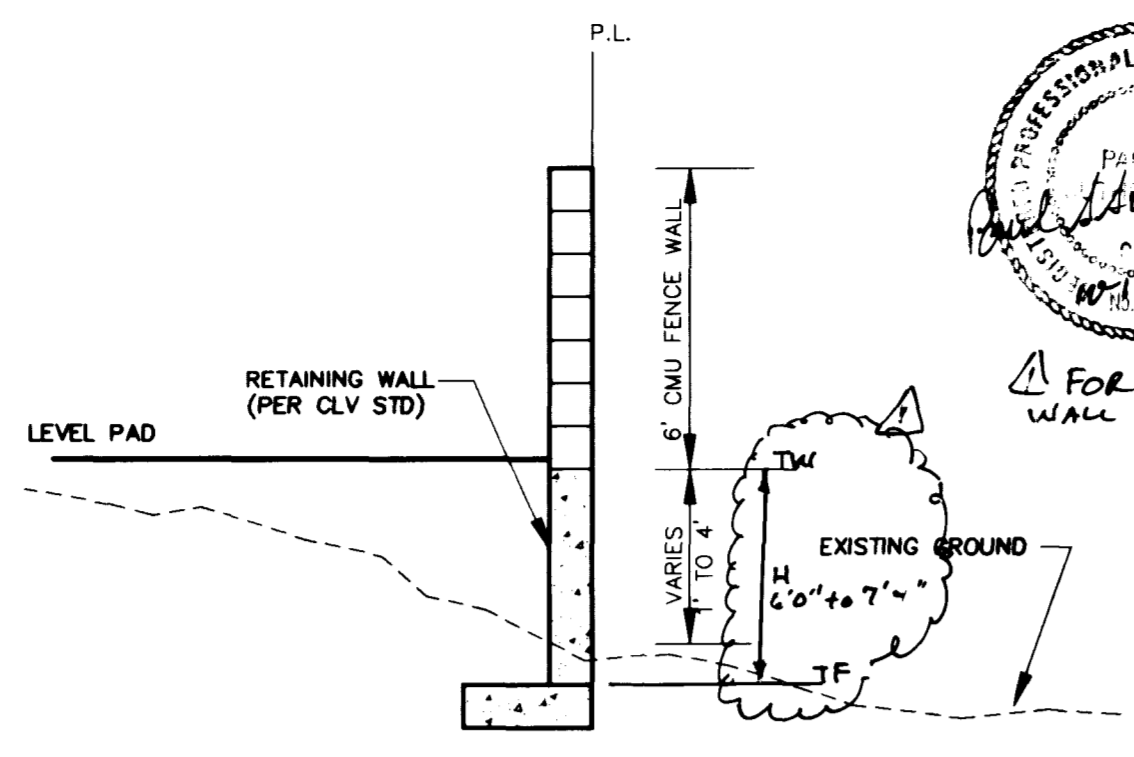


12 REAR YARD PERIMETER DETAIL

SCALE: NO SCALE

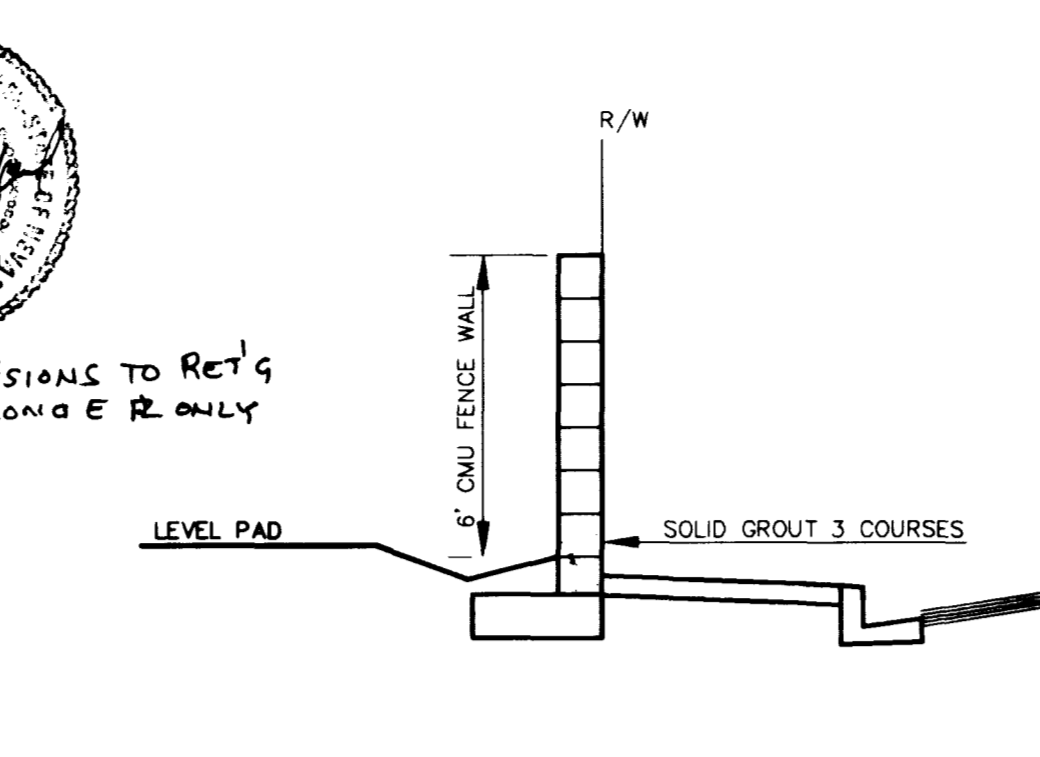


8 REAR YARD PERIMETER DETAIL

SCALE: NO SCALE

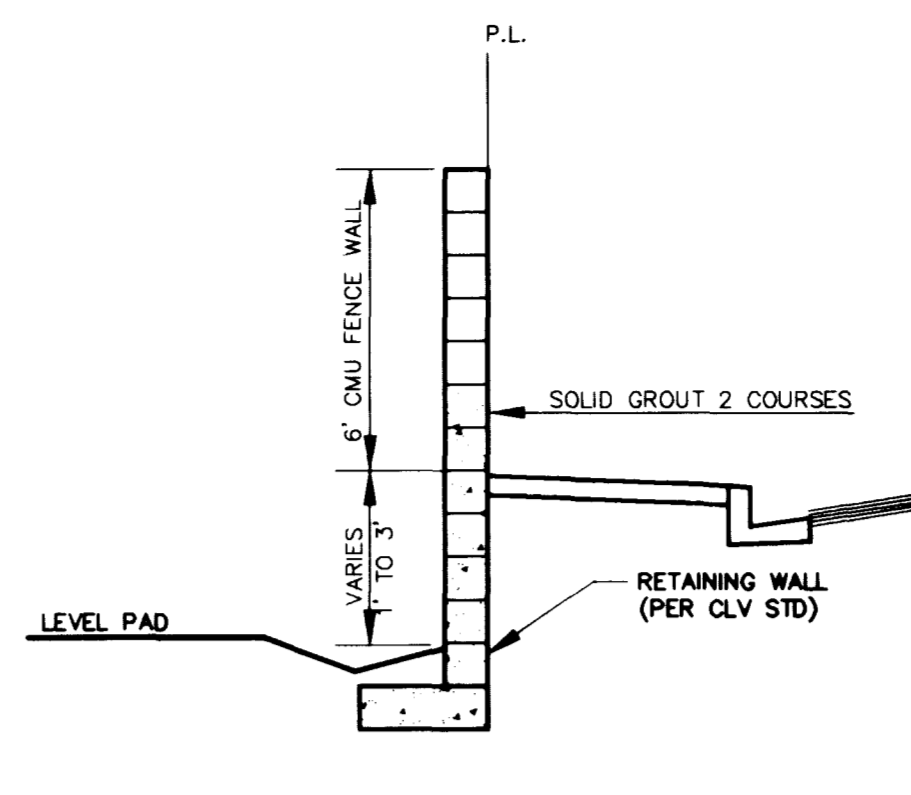

4 SIDE YARD WITH RETAINING DETAIL


SCALE: NO SCALE

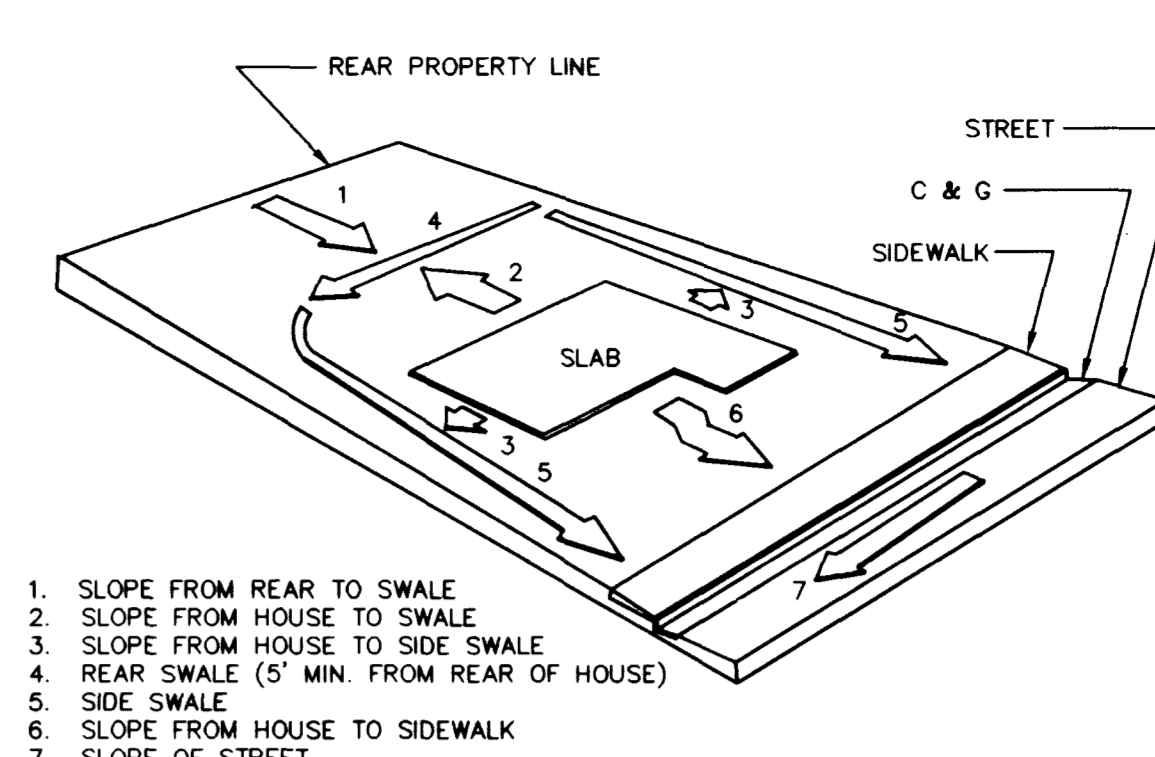

1. SLOPE FROM REAR TO SWALE
2. SLOPE FROM HOUSE TO SWALE
3. SLOPE FROM HOUSE TO SIDE SWALE
4. REAR SWALE (5' MIN. FROM REAR OF HOUSE)
5. SIDE SWALE
6. SLOPE FROM HOUSE TO SIDEWALK
7. SLOPE OF STREET


TYPICAL LOT GRADING - TYPE "A"

SCALE: N.T.S.

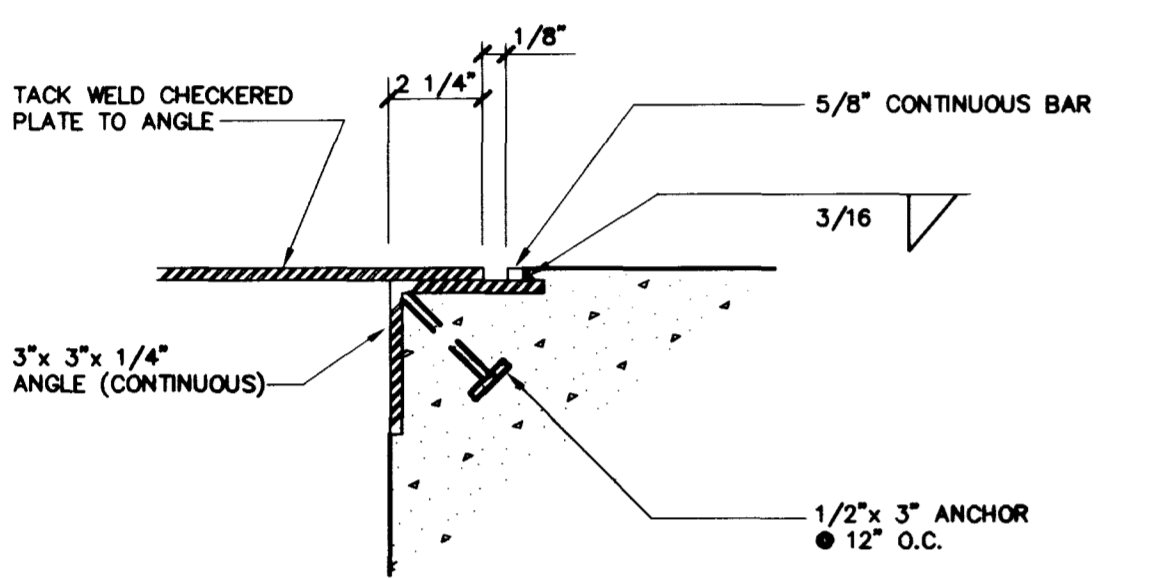


FOR ADDITIONAL DESIGN REQUIREMENTS SEE USD #236

B

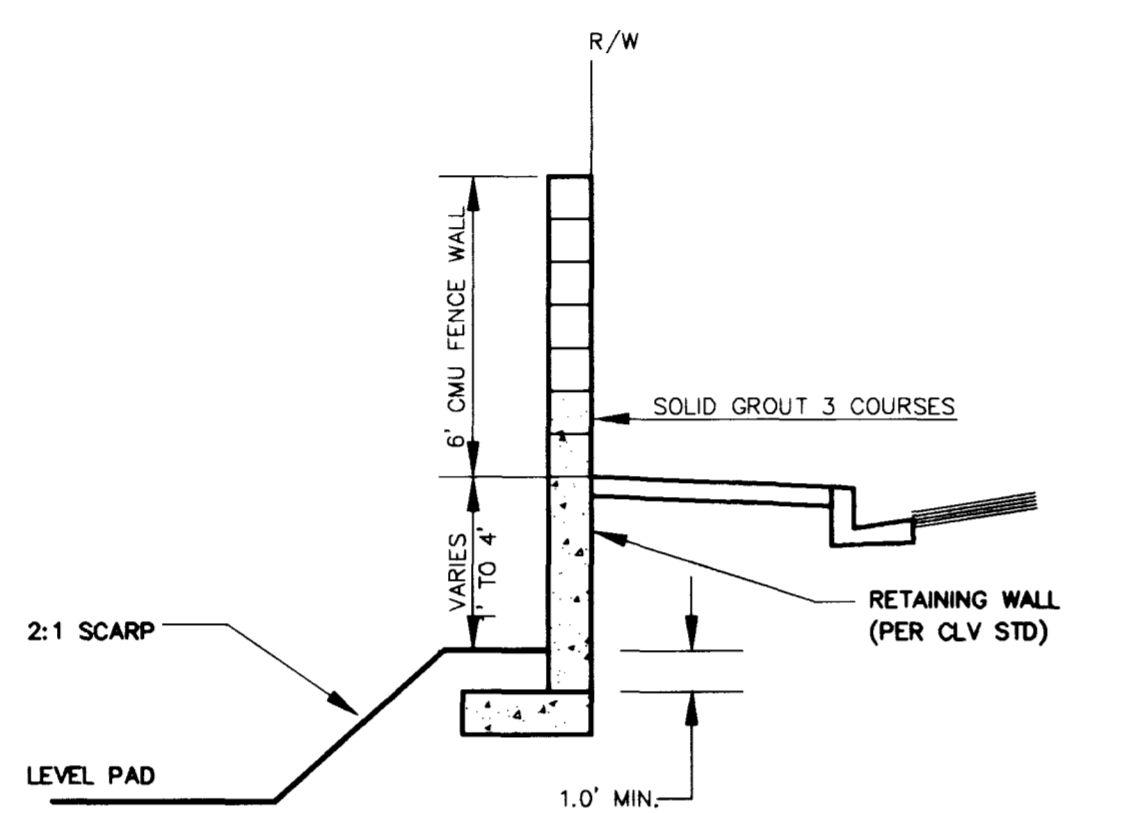


13 REAR YARD PERIMETER DETAIL

SCALE: NO SCALE

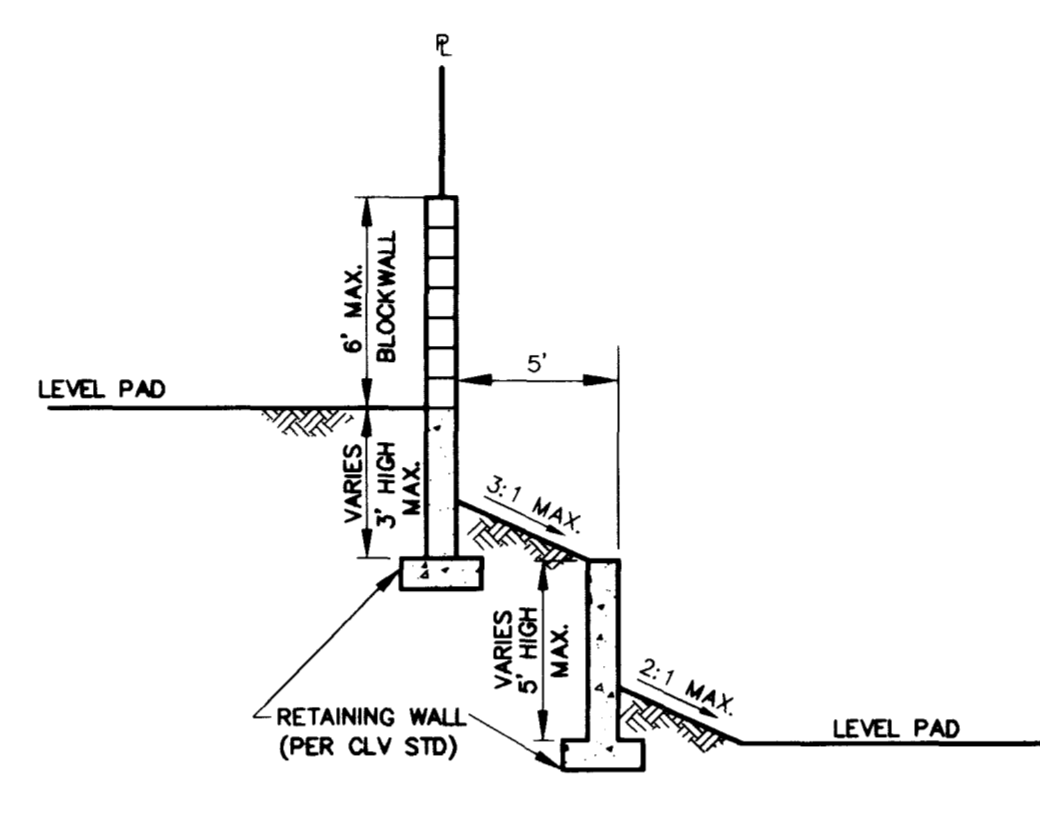


9 REAR YARD PERIMETER DETAIL

SCALE: NO SCALE

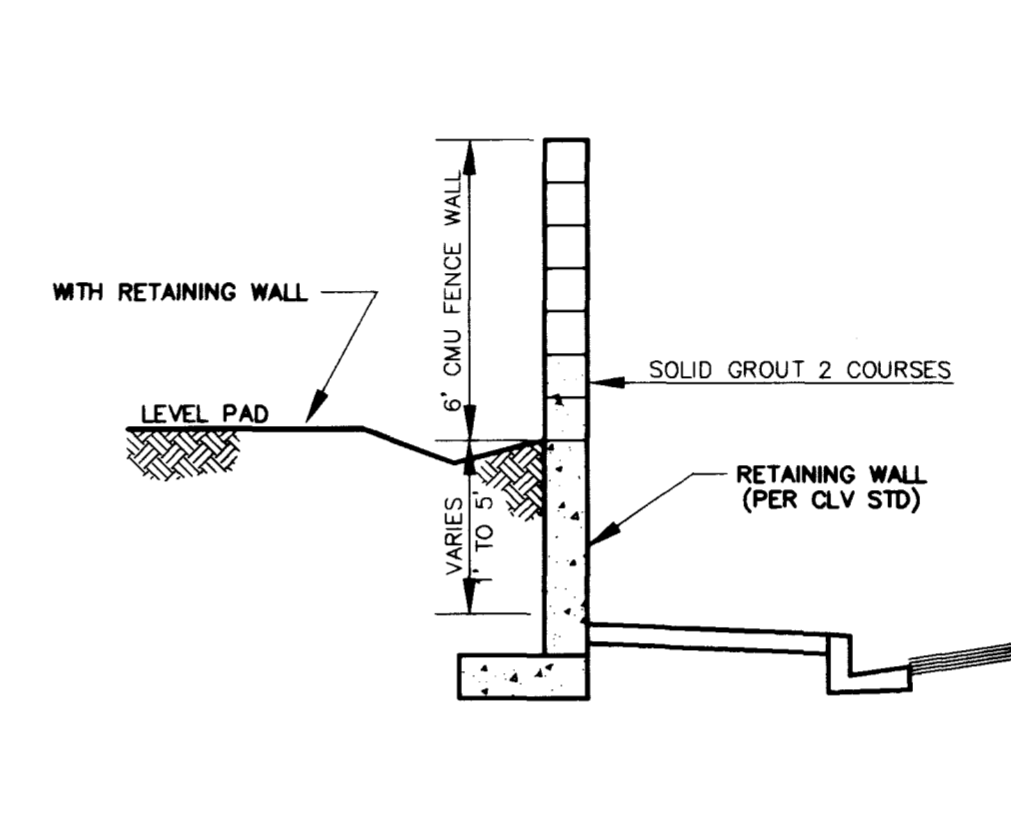


5 SIDE YARD WITH RETAINING DETAIL

SCALE: NO SCALE

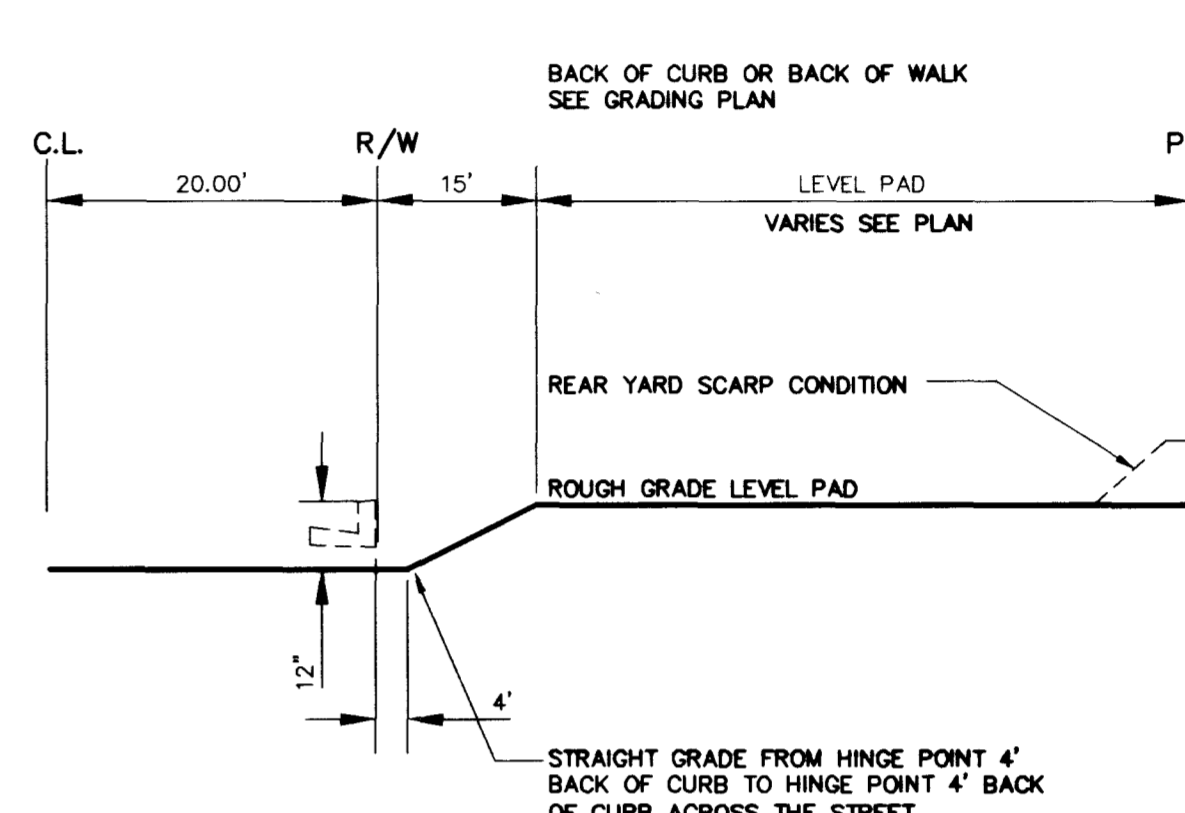

1 PAD GRADING SECTION


SCALE: NO SCALE

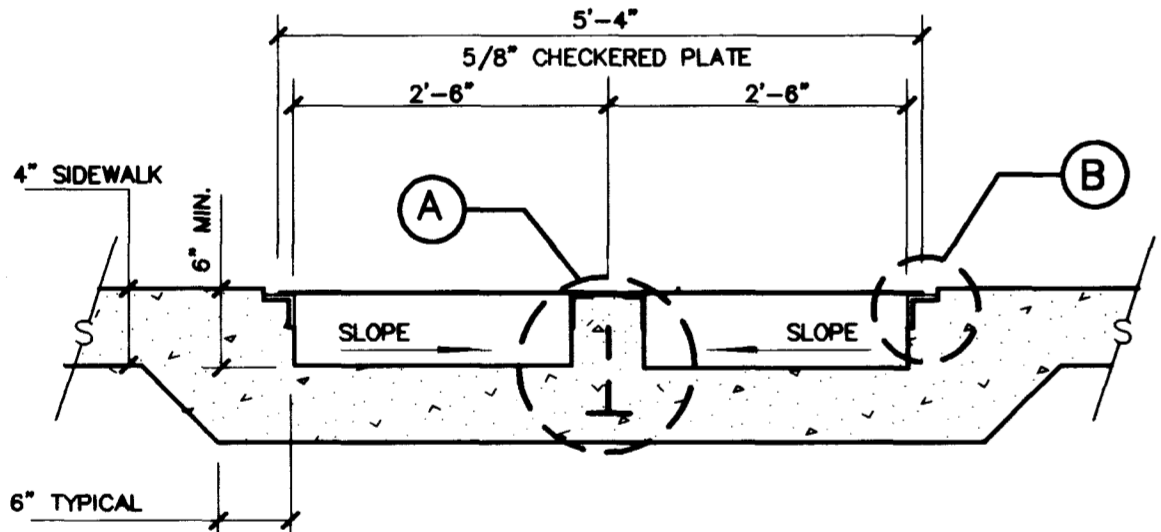

FOR ADDITIONAL DESIGN REQUIREMENTS SEE USD #236


16 SIDEWALK UNDERDRAIN DETAIL

SCALE: NO SCALE

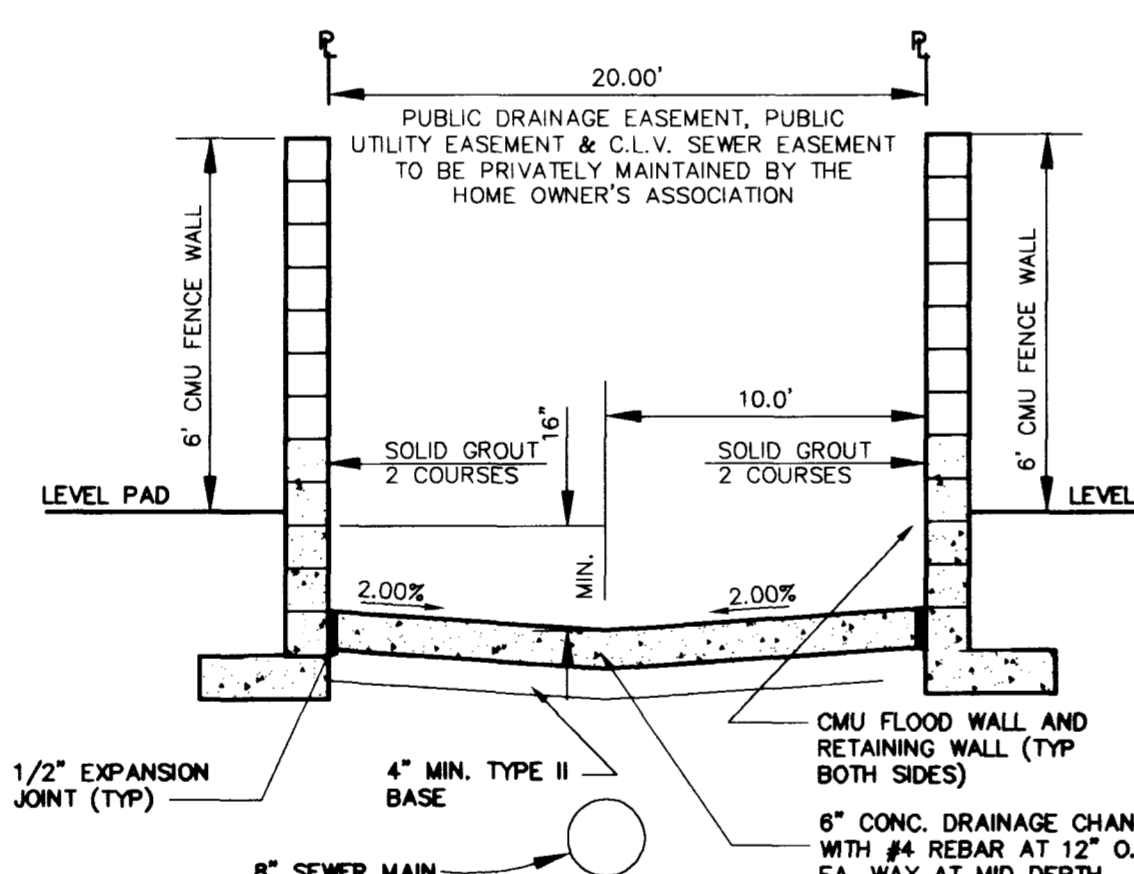


14 CONCRETE CHANNEL DETAIL

SCALE: NO SCALE

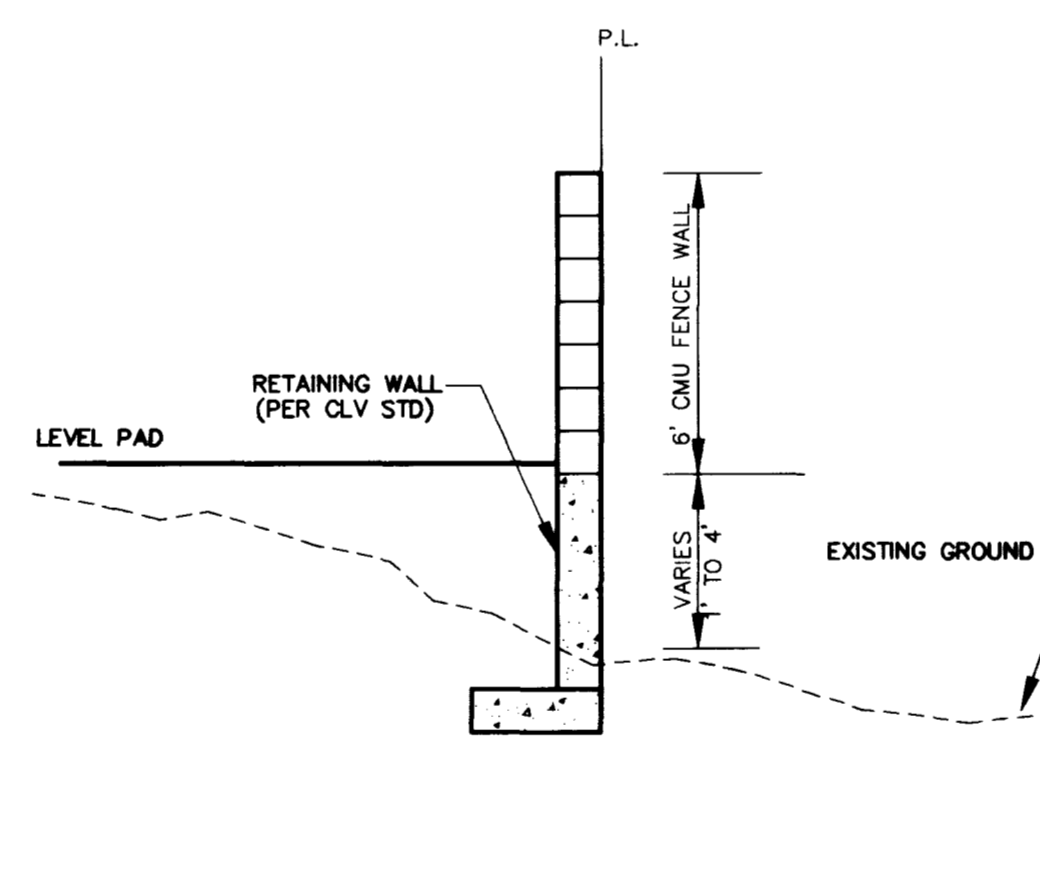


10 REAR YARD PERIMETER DETAIL

SCALE: NO SCALE

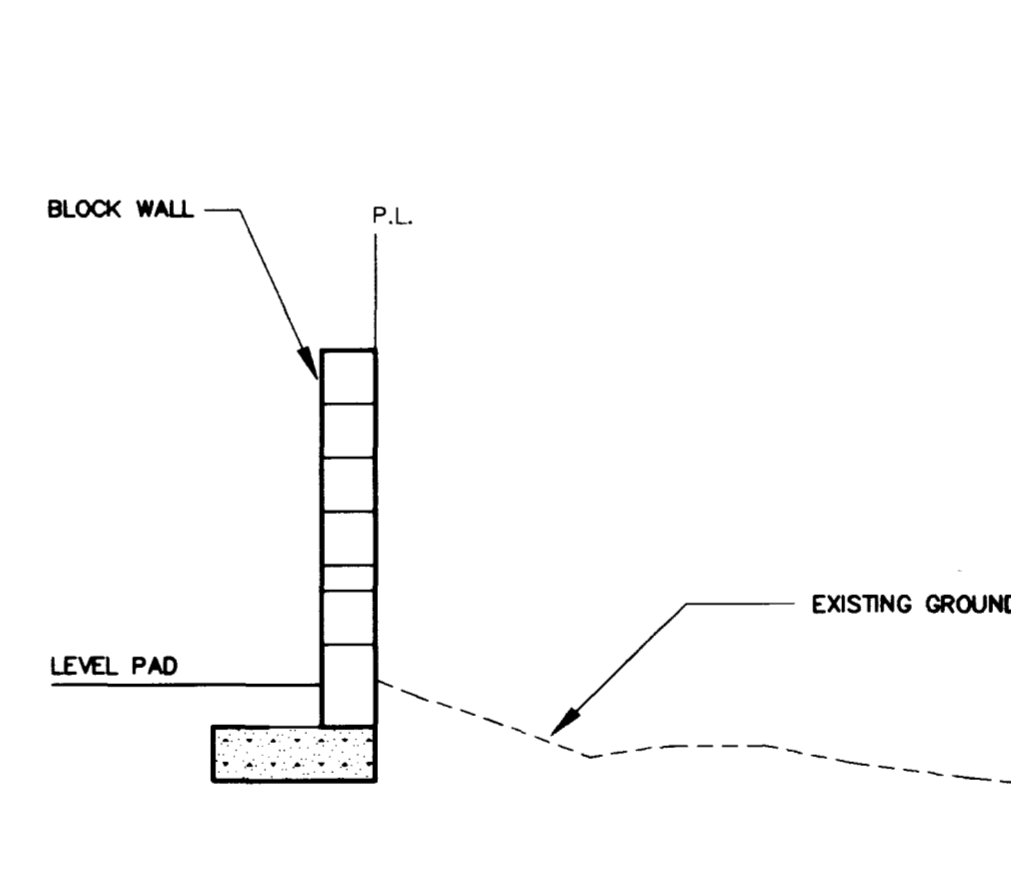


6 REAR YARD PERIMETER DETAIL

SCALE: NO SCALE

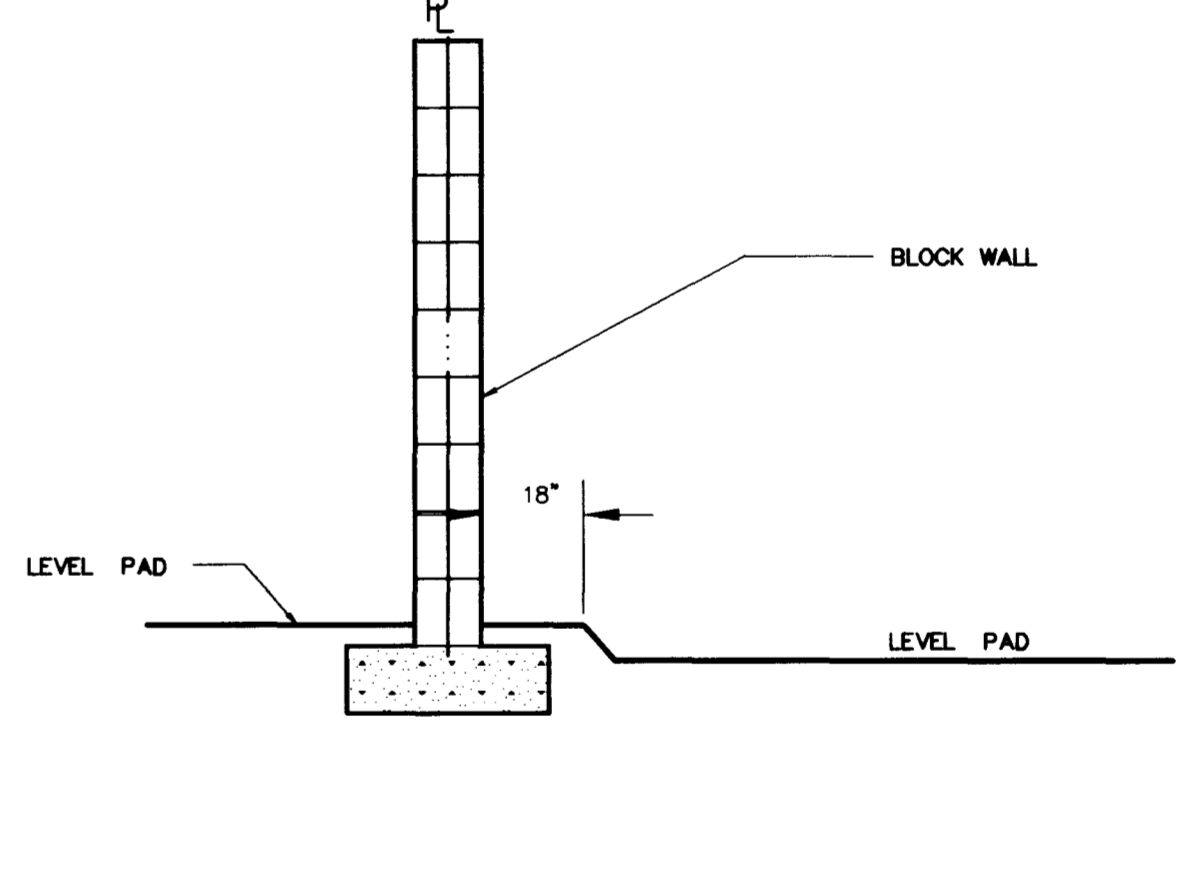


2 TYPICAL SIDE YARD DETAIL

SCALE: NO SCALE

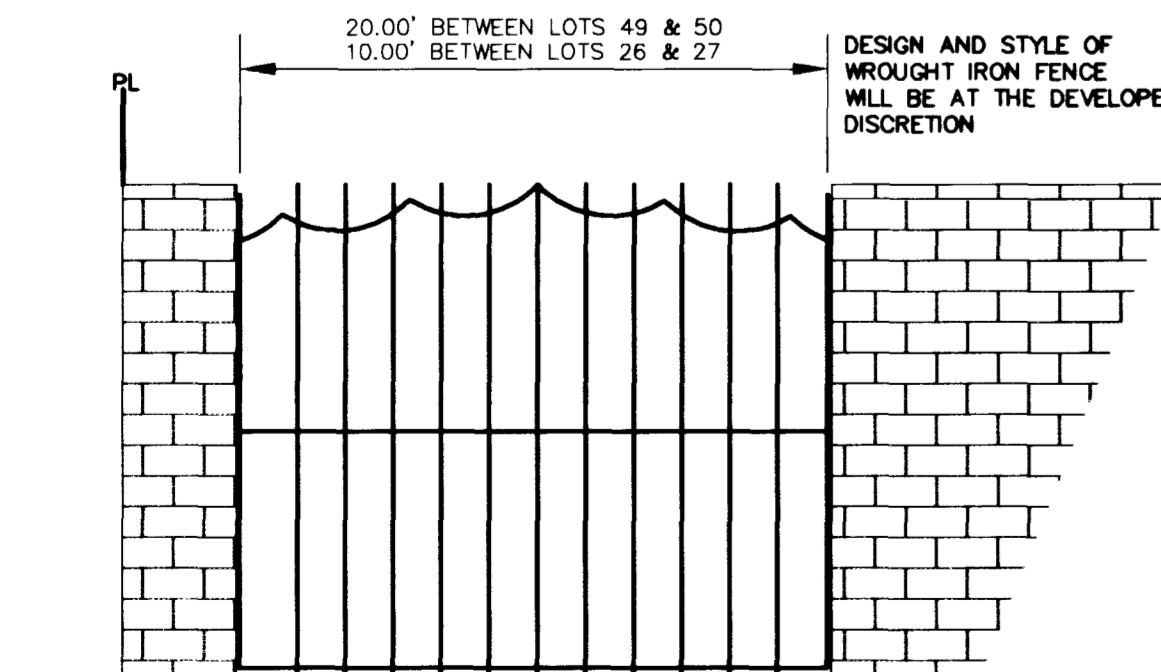


17 WROUGHT IRON FENCE

SCALE: NO SCALE

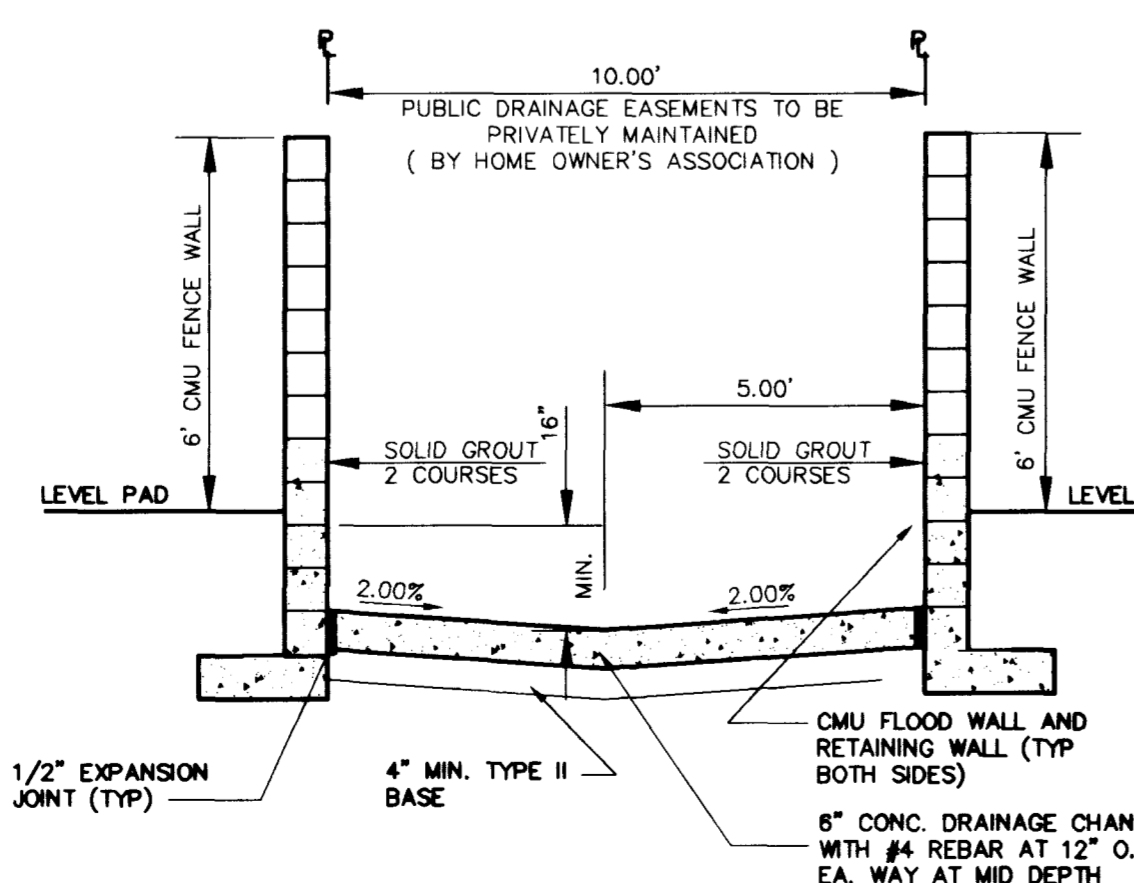


15 CONCRETE CHANNEL DETAIL

SCALE: NO SCALE

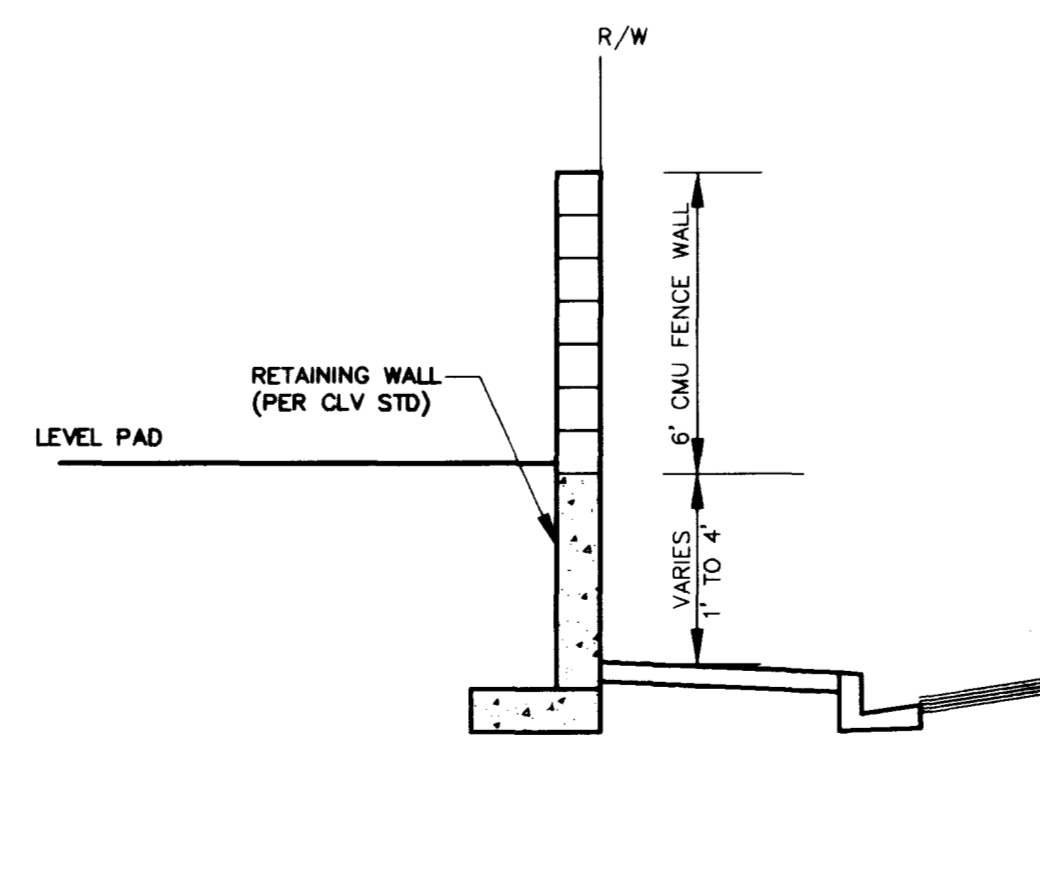


11 REAR YARD PERIMETER DETAIL

SCALE: NO SCALE

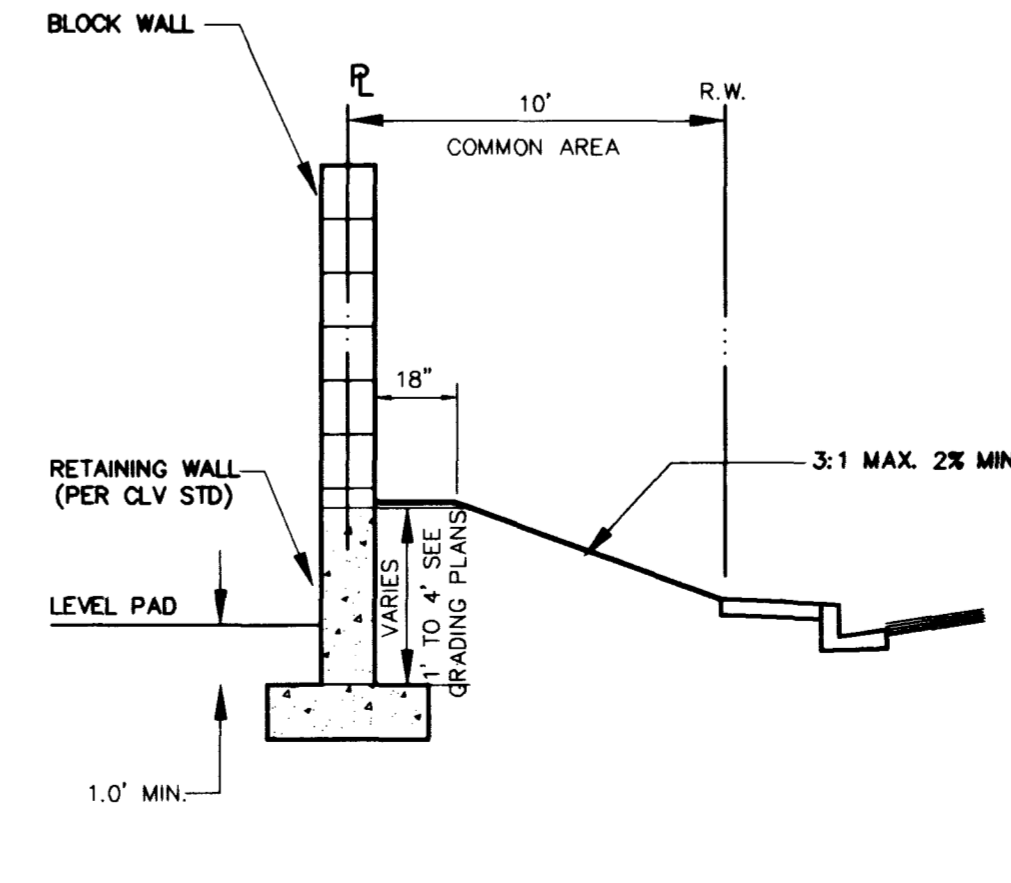

7 REAR YARD PERIMETER DETAIL / WITH RETAINING

SCALE: NO SCALE

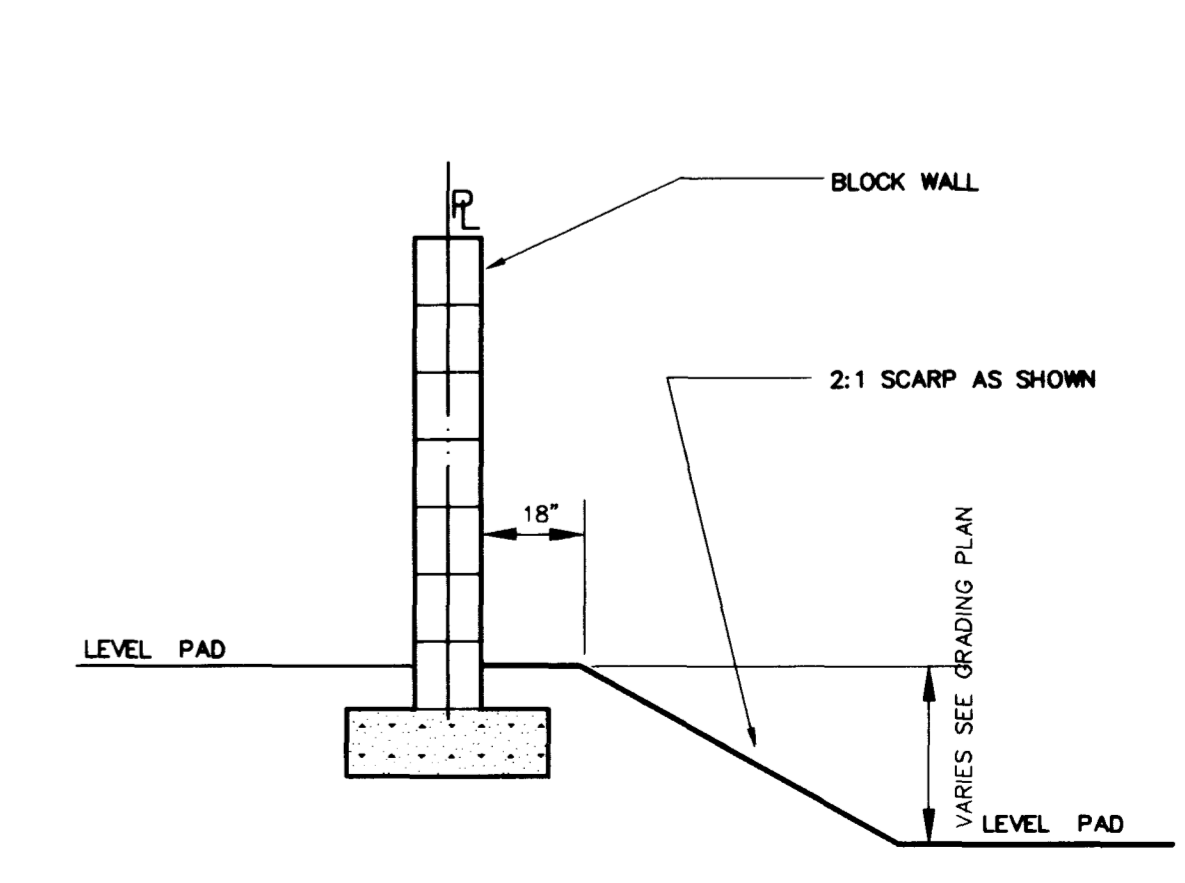

3 REAR YARD DETAIL


SCALE: NO SCALE

NO.	DESCRIPTION	DATE	APP'D.

RECOMMENDED BY: **LENNARE GROSZINSKI CIVIL**
 P. E. # 0169 0100
 NO. 8000

DATE: 08/05/98	DESIGNED BY: FC	CHECKED BY: P. E. # 0169 0100	SCALE: NONE
----------------	-----------------	-------------------------------	-------------

PENTACORE
 CIVIL ENGINEERING • LAND SURVEYING • PLANNING
 CONSTRUCTION MANAGEMENT • PCA CONSULTING
 LAS VEGAS, NEVADA 89102 (702)258-0115

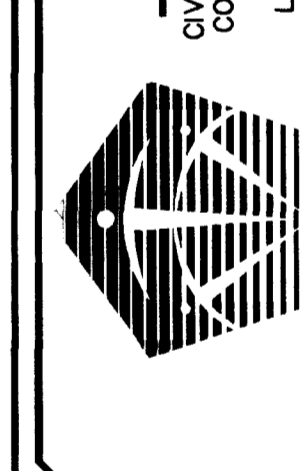

FALCON HOMES
 CHEYENNE RIDGE PHASE 2
 GRADING DETAILS


4646

11-13-120

1074-4323-2-1




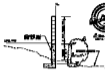












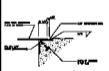















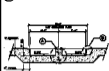
































