


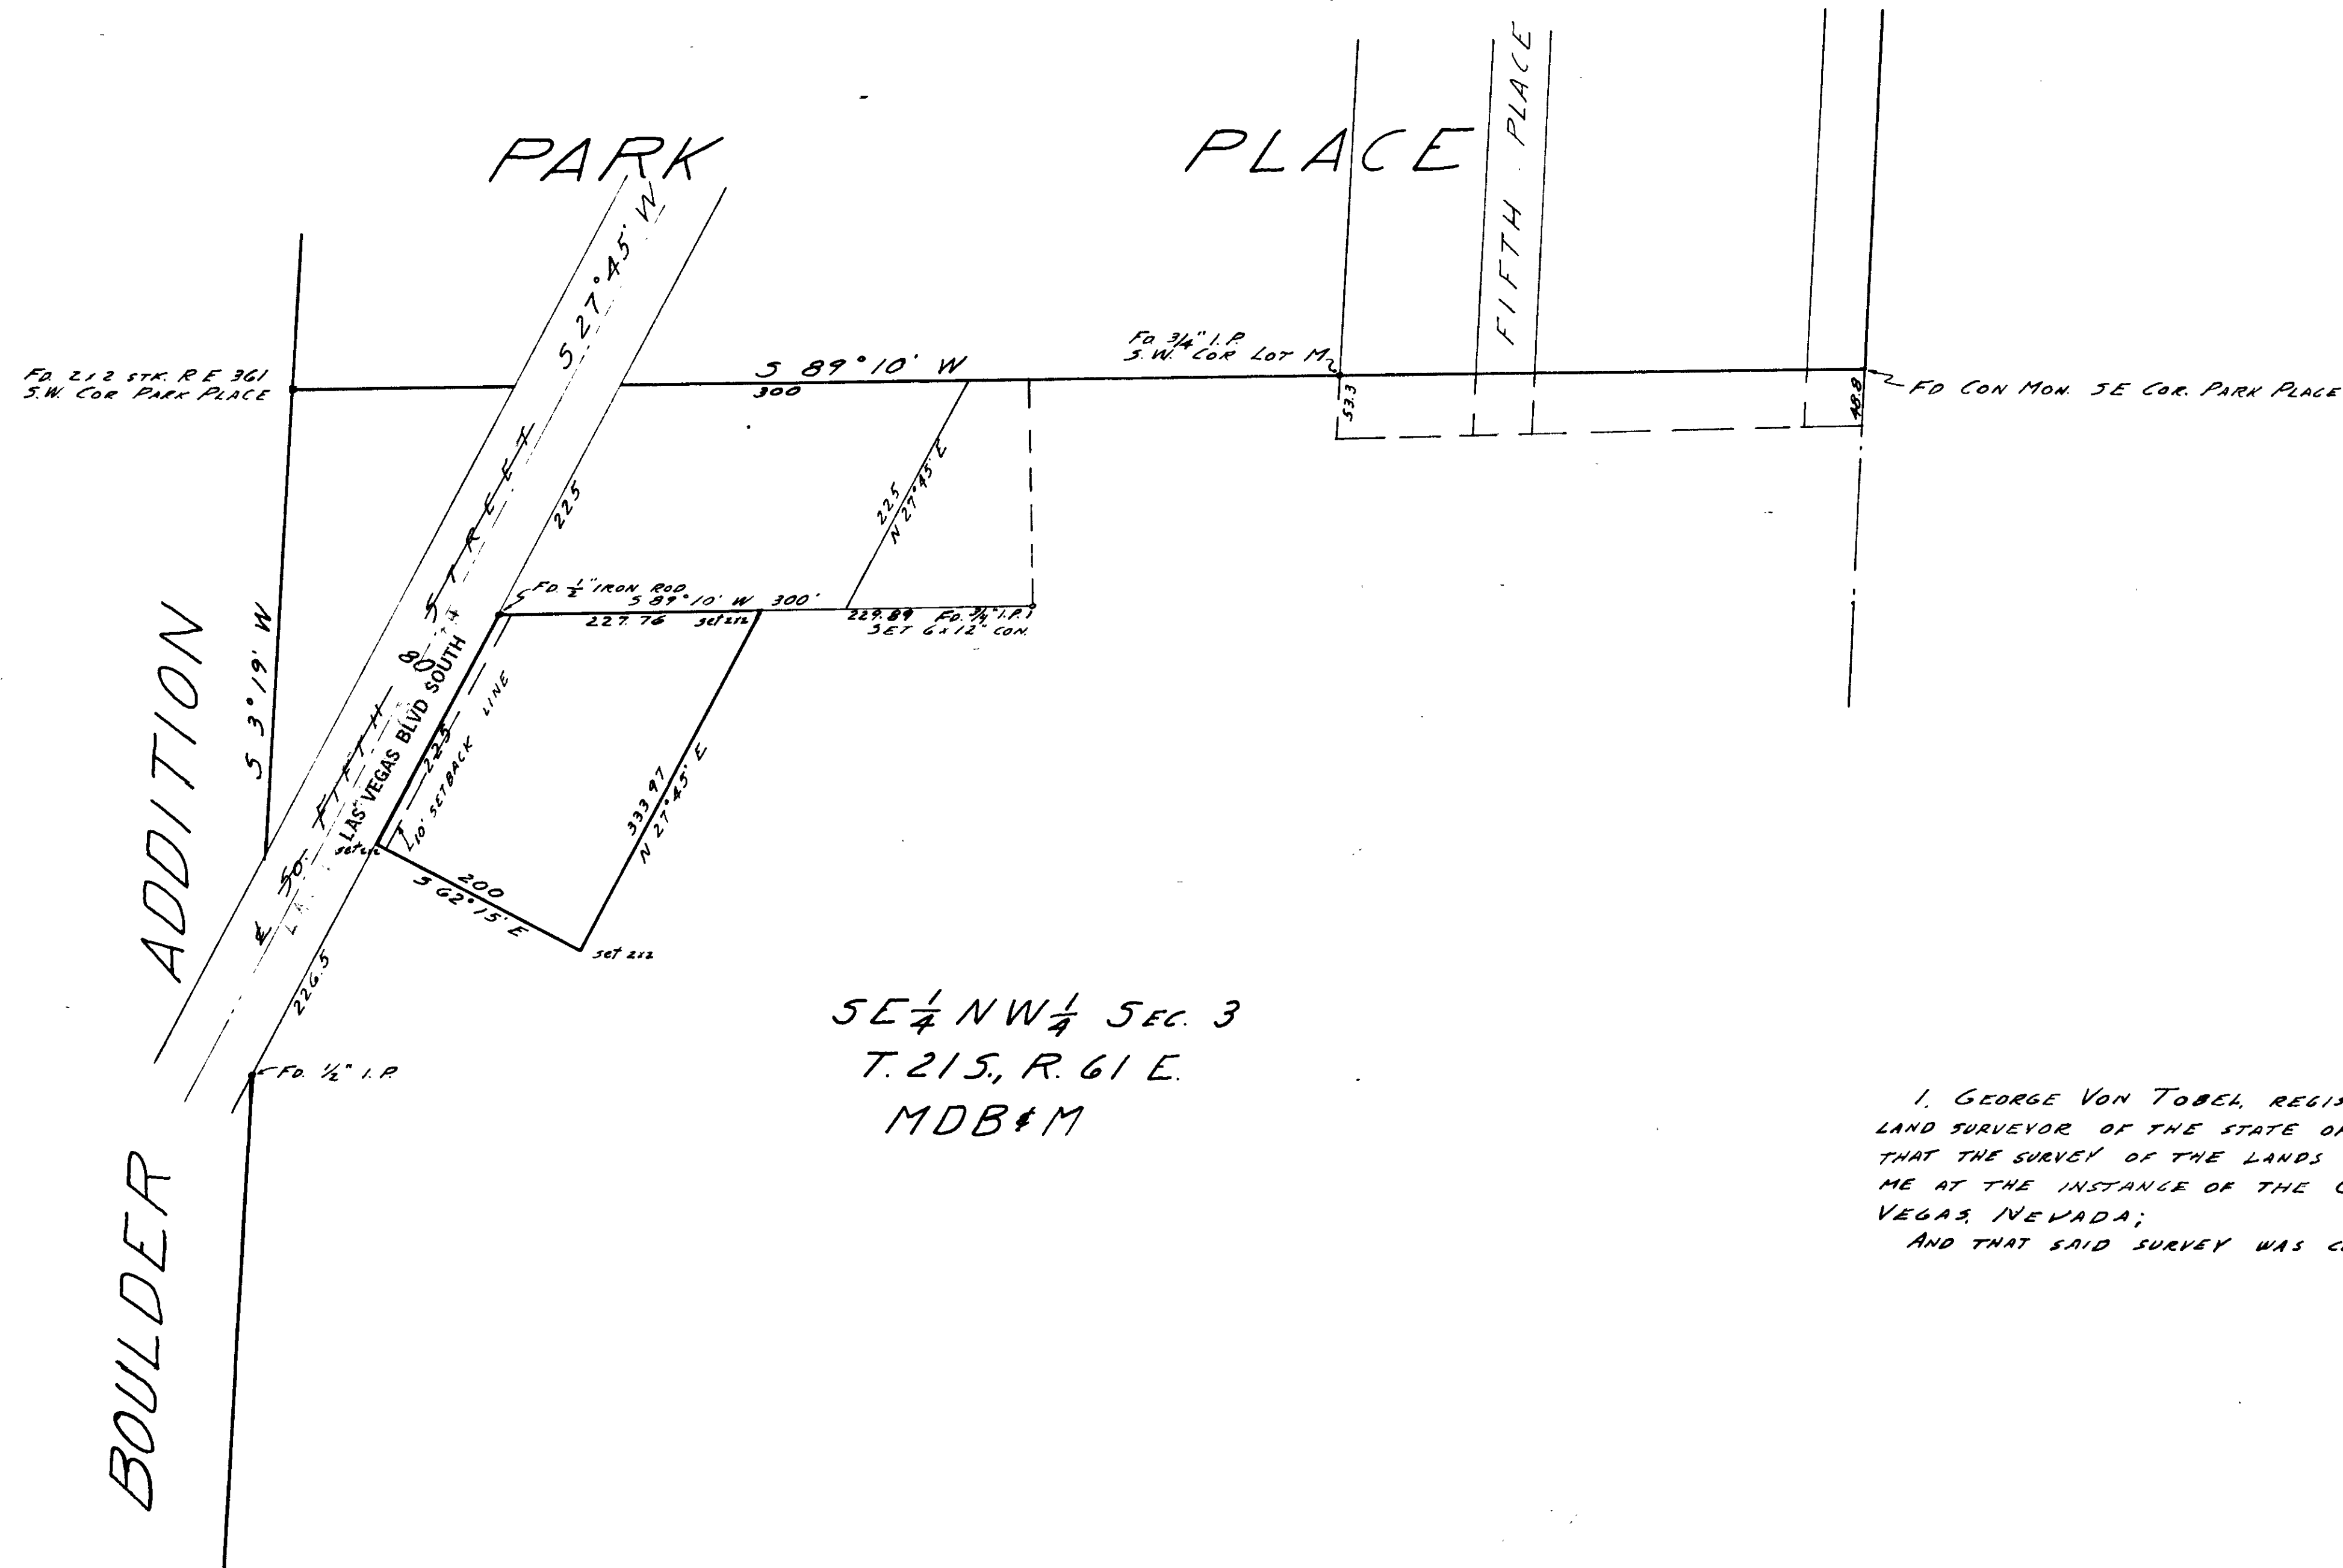

I, GEORGE VON TOBEL, REGISTERED CIVIL ENGINEER AND LAND SURVEYOR OF THE STATE OF NEVADA, DO HEREBY CERTIFY THAT THE SURVEY OF THE LANDS SHOWN HEREON WAS MADE BY ME AT THE INSTANCE OF THE CADILLAC MOTEL, LAS VEGAS, NEVADA;
AND THAT SAID SURVEY WAS COMPLETED ON DECEMBER 29, 1951

George Von Tobel
REG. CIV. ENGR.
No. 428

No. 380310
Recorded Filed at Request of
George Von Tobel
At 45 min past 2, 1-30-52
in File 1 Page 36
of
CLARK COUNTY, NEVADA RECORDS
Paul C. O'Malley, Recorder
Fee 1.00 Compared PEH