


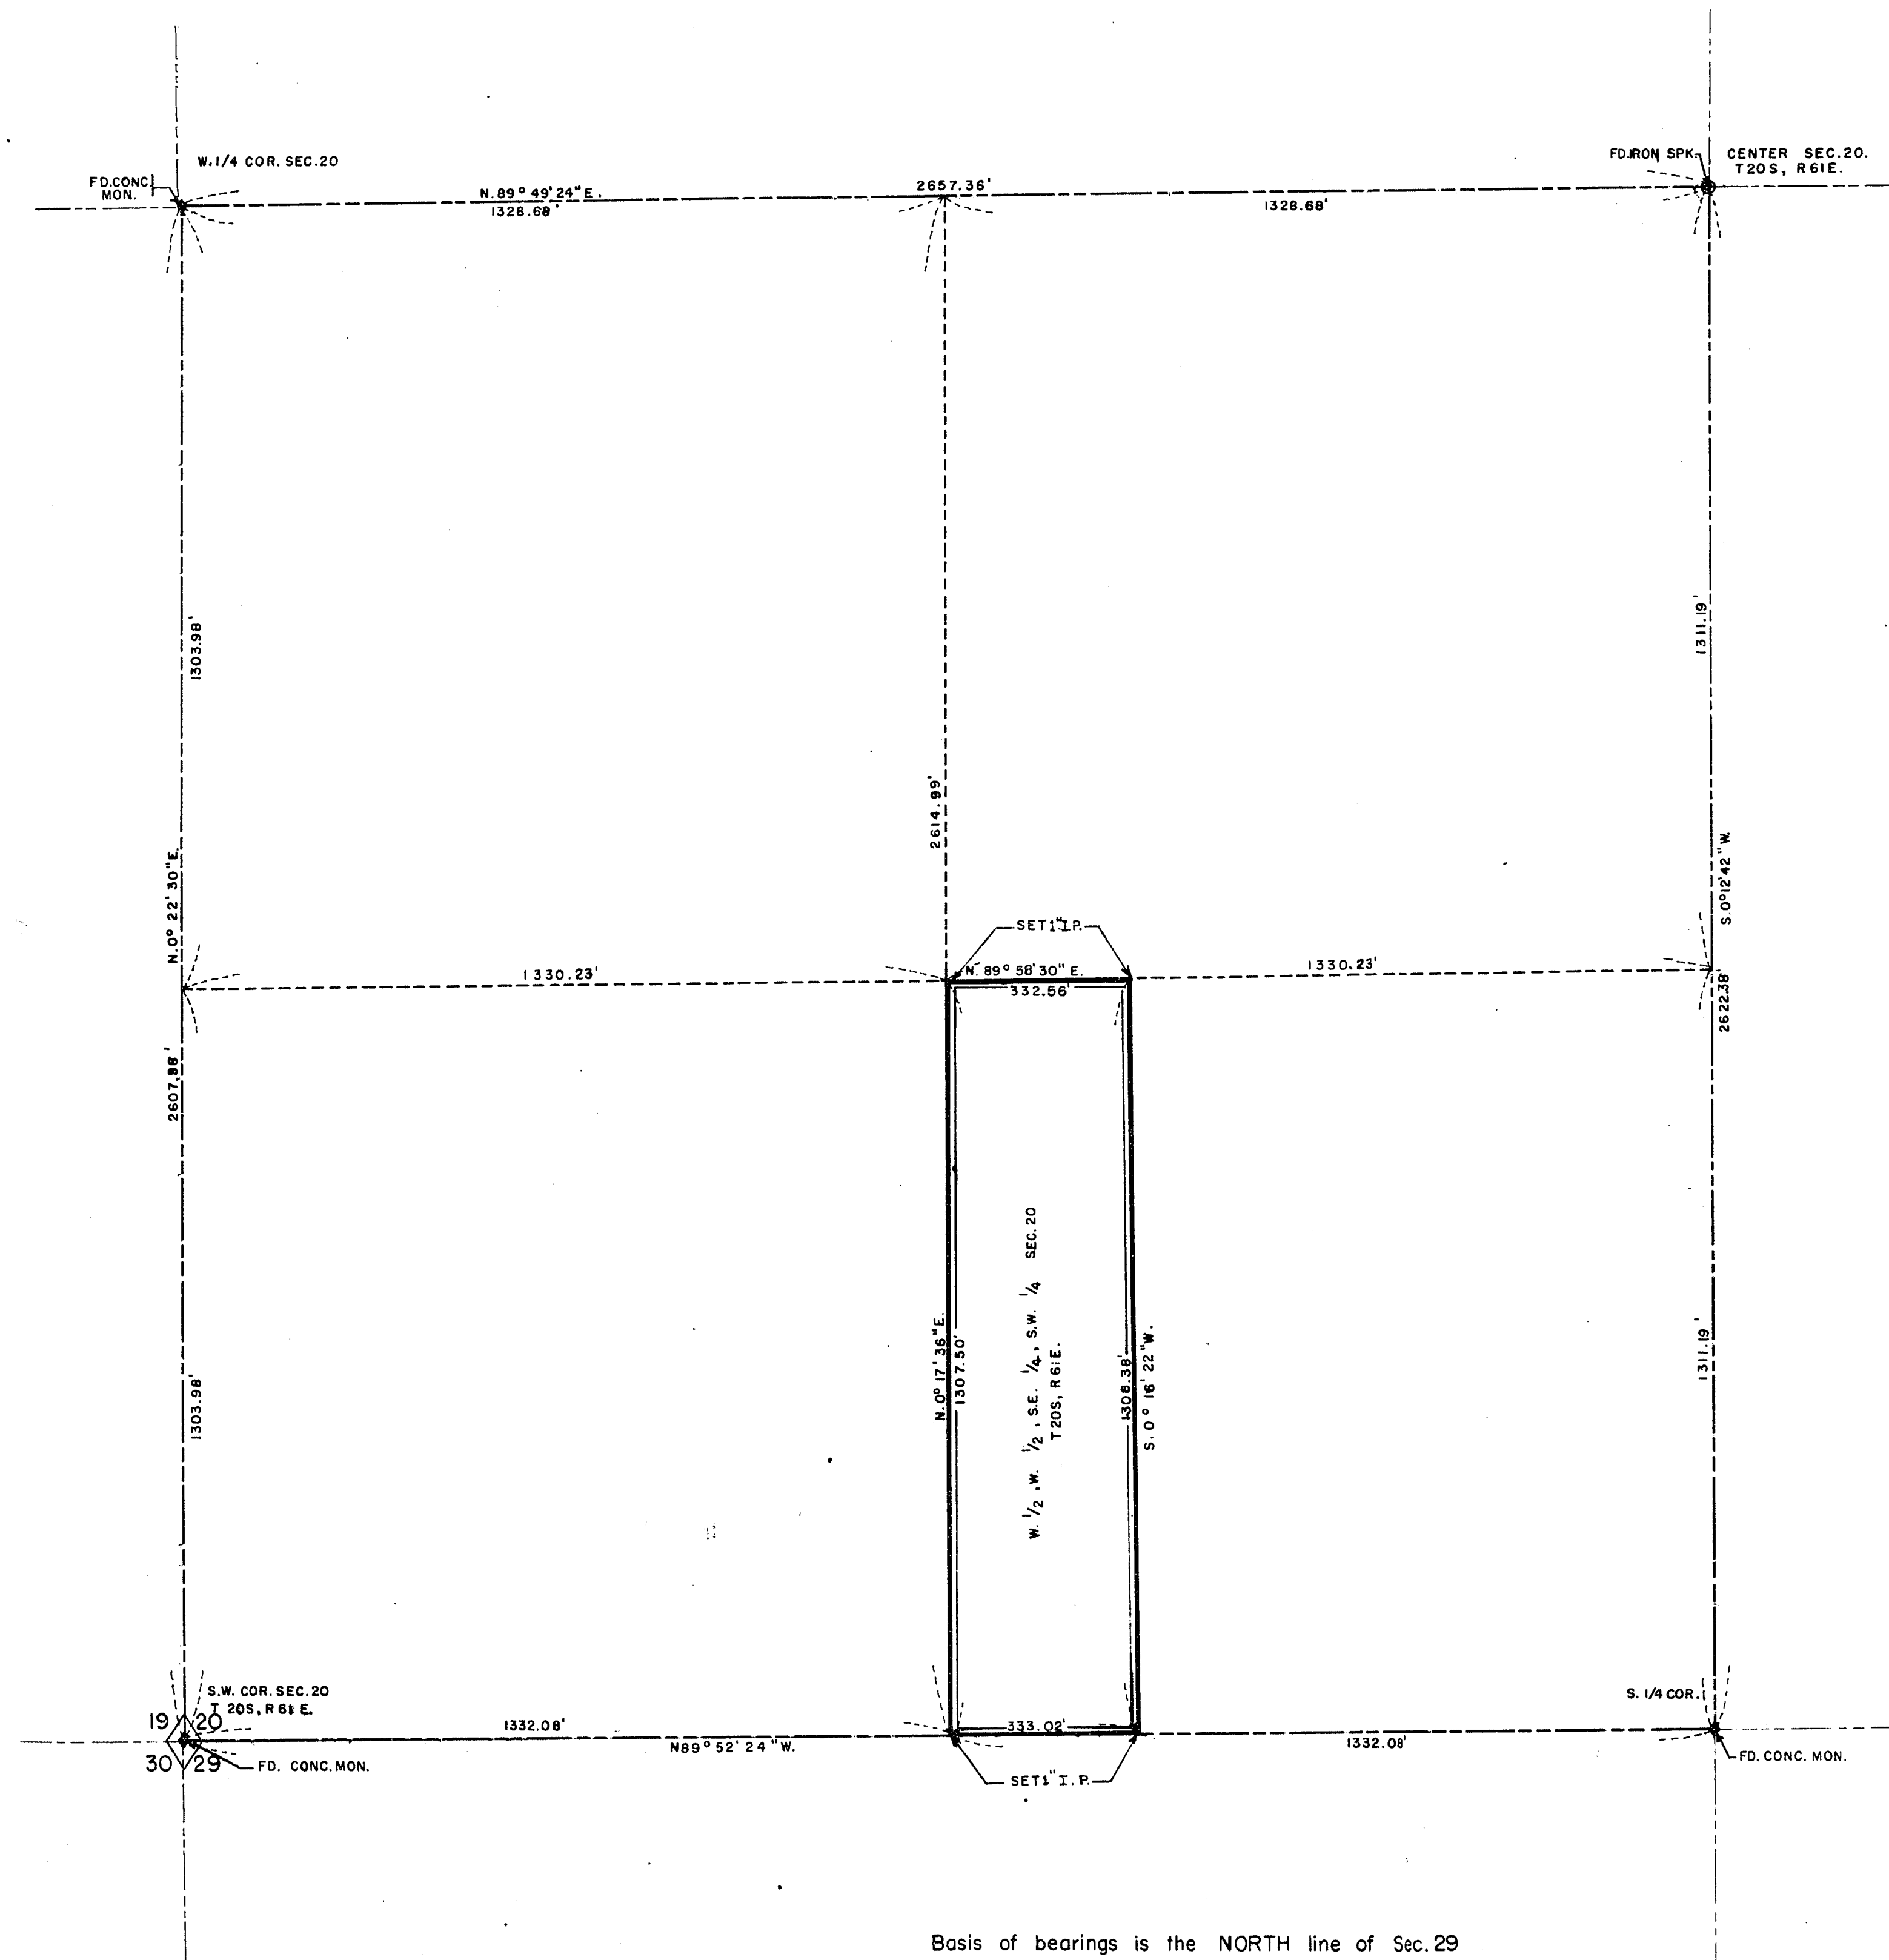


Basis of bearings is the NORTH line of Sec. 29
T20S, R61E, MDB & M. as shown on that certain
plat entitled, TWIN LAKES VILLAGE, Unit No. 5
Recorded in book 4 of plats, at page 61A in
the office of COUNTY RECORDER, CLARK
COUNTY, NEVADA.

I, L.A. HARRIS, A DULY REGISTERED ENGINEER &
LAND SURVEYOR, do hereby certify that this map truly and
correctly represents the results of a survey made under my
supervision and completed on the 2nd day of August
1956 of and for the City of LAS VEGAS, NEVADA. This
survey is not a subdivision as defined in planning & Zoning
Laws as shown in 1943-1949 Supplement, Nevada
Compiled Laws.

L.A. Harris
REGISTERED ENGINEER & LAND SURVEYOR
NEVADA R.E. 24

APPROVED this 30 day of Aug 1956

James E. Hade
CITY ENGINEER
NEVADA R.E. 280

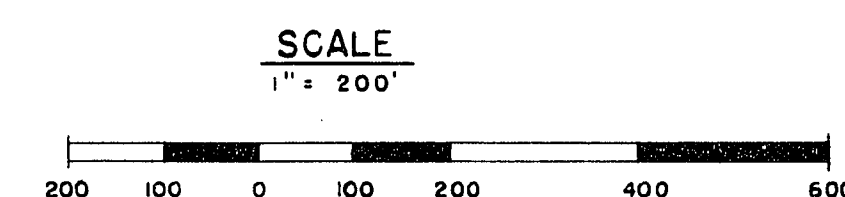

CITY OF LAS VEGAS, NEVADA
ENGINEERING DEPT.

Boundary Survey of the W. 1/2, W. 1/2, S.E. 1/4, S.W. 1/4
of Section 20, T20S, R61E., M.D.B. & M.
Annexed to the City of LAS VEGAS, NEVADA
under Ord. No. 723.

DRAWN BY LEA HARPER	CHECKED BY KENNEDY <i>Ed</i>	APPROVED BY <i>EAH</i>
DATE 8-8-56 FIELD REF. 85-18	DATE 8-21-56 P-272	DATE 8-21-56

88362
City of Las Vegas
9-6-56 10:22A
6-48

RECORDED
City of Las Vegas
SEP 6 10 42 AM '56
CLARK COUNTY, NEVADA
RECORDS & DEEDS
2408

055-276
File 6 PAGE 48