


78-11

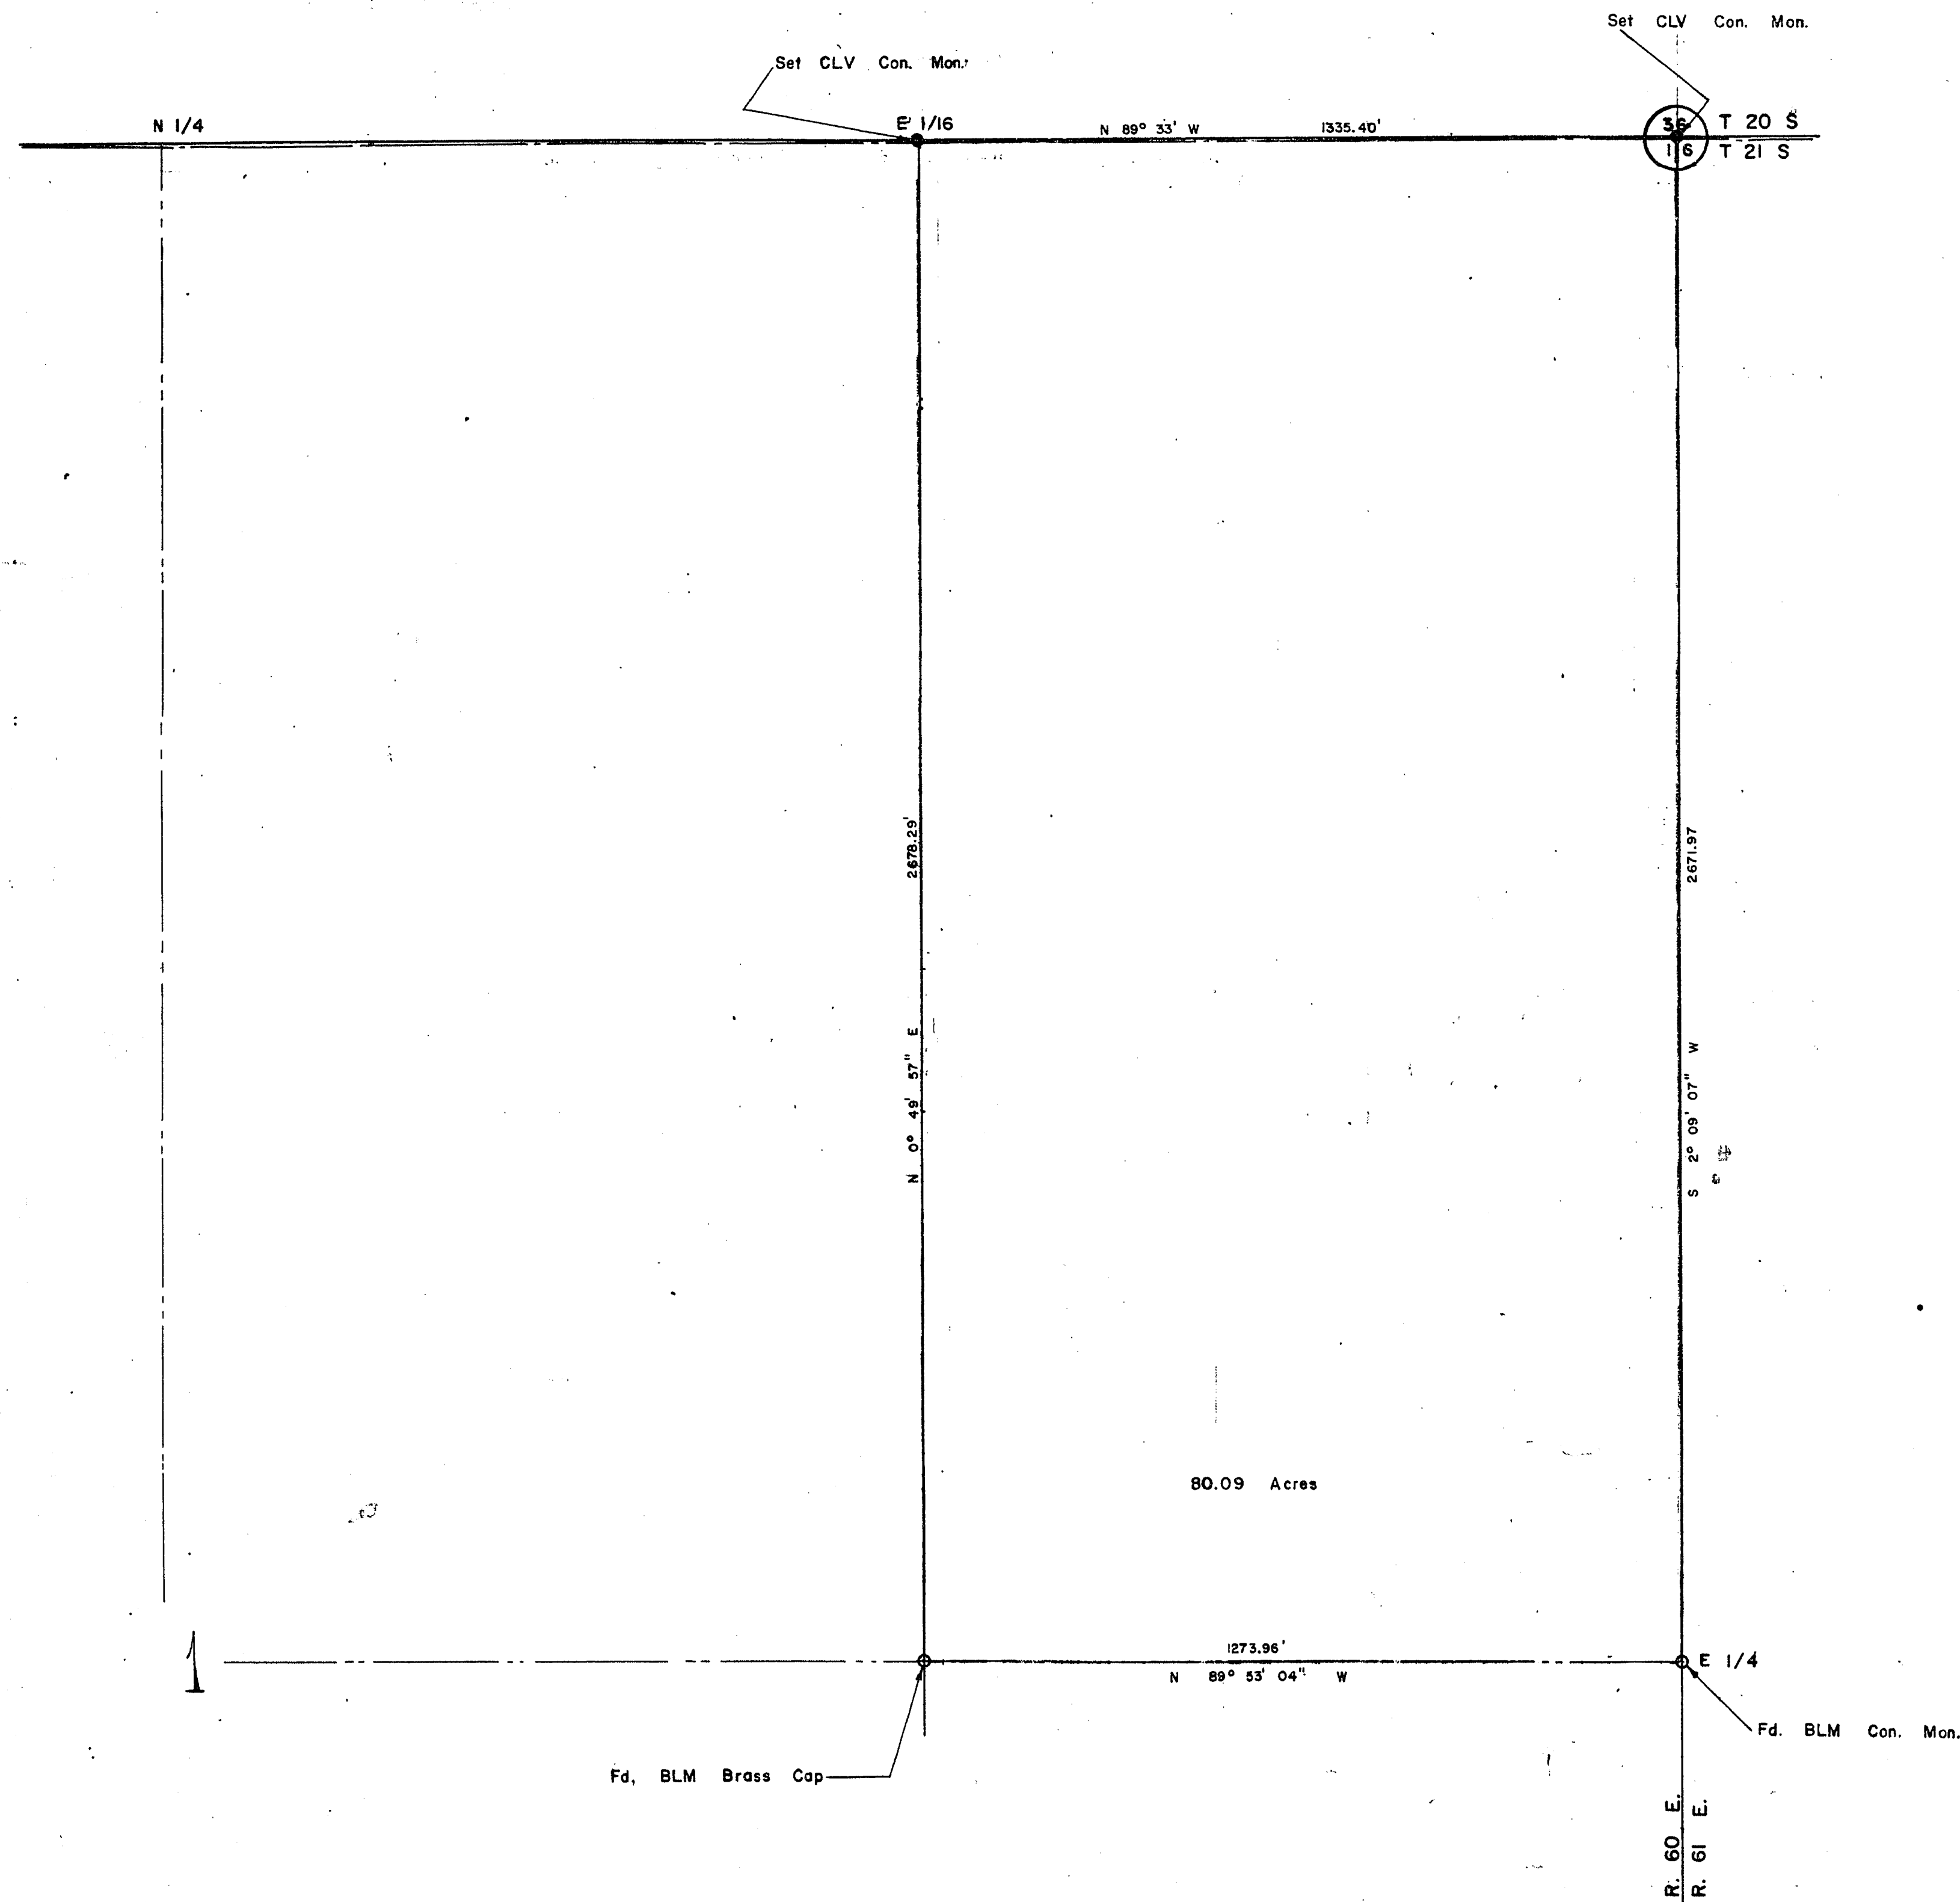


I, L. A. Harris, A DULY REGISTERED
ENGINEER & LAND SURVEYOR, do hereby certify that this
map truly and correctly represents the results of a survey
made under my supervision and completed on the 20th day of DEC. 1955
of and for the City of Las Vegas, Nevada.

L. A. Harris
REGISTERED ENGINEER AND LAND SURVEYOR
NEVADA R.E. 24




APPROVED this 7th day of FEB. 1956

Simon E. Stodd
CITY ENGINEER
NEVADA R.E. 280

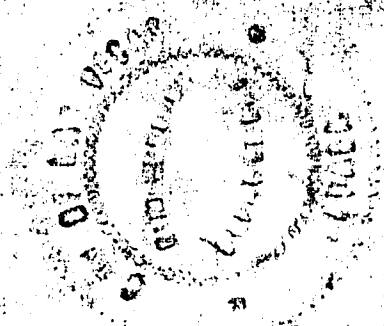

SCALE

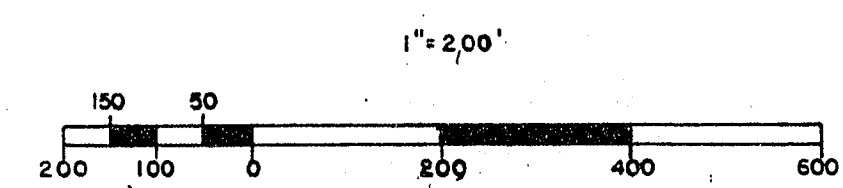

Basis of bearings is the North line of the Northeast one quarter
of Section 1, T. 21 S., R. 60 E., M.D.B. & M. as shown on Bureau of Land
Management plat of retracement, dated June 8, 1953.

○ MONUMENTS FOUND
● MONUMENTS SET

No. 71555
FILED AT THE REQUEST OF
City of Las Vegas
Date 2-2-56 at 11:45 A.M.
FILE 5 PAGE 23
Reg. Prof. Eng. Surveys
CLARK COUNTY, NEVADA, RECORDS
PAUL C. O'MALLEY, RECORDER
Fee \$ 50 100 Deputy

71555

RECORDED AT THE REQUEST OF
City of Las Vegas

MAR 2 11 40 AM '56

OFFICIAL RECORDS BOOK NO. 26
CLARK COUNTY, NEVADA
PAUL C. O'MALLEY, RECORDER
FOR Simon E. Stodd DEPUTY

CITY OF LAS VEGAS, NEVADA
ENGINEERING DEPT.

Boundary Survey of the E 1/2, NE 1/4,
of Section 1, T. 21 S., R. 60 E., MDB&M.
Annexed Area to the City of
Las Vegas, Nevada under Ordinance
No. 698

DRAWN BY <u>D. P. [unclear]</u>	CHECKED BY <u>[unclear]</u>	APPROVED <u>[unclear]</u>	FIELD BOOK REF.
DATE: <u>2-6-56</u>	DATE: <u>2-6-56</u>	DATE: <u>2-6-56</u>	<u>55-5</u>

055-273

File 5-11-56