



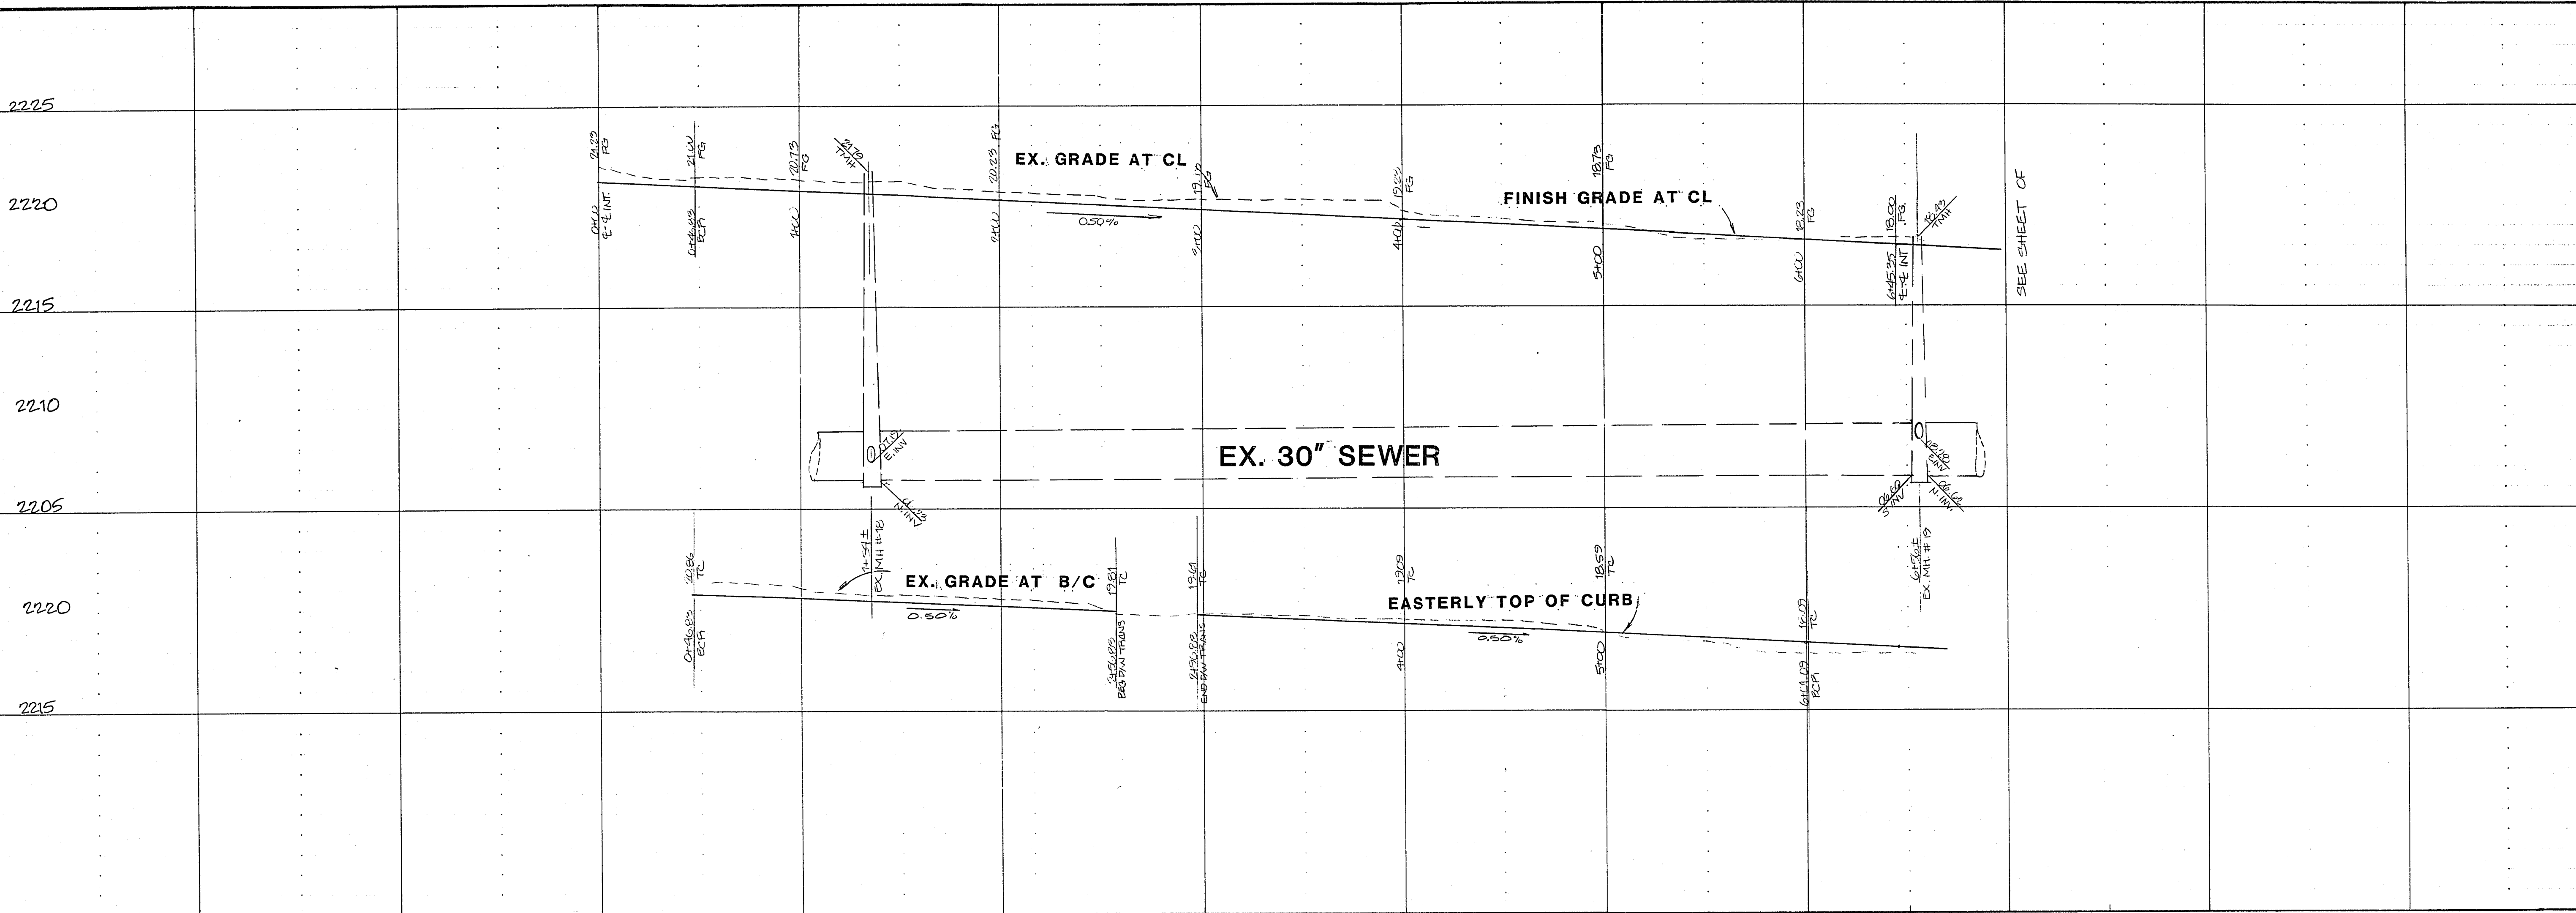

NO.	DATE	BY	REVISION
1	7/10/88	BM	ADDED PEDESTAL WALK
2	7/10/88	BM	INCREASED A/C THICKNESS
3	7/10/88	BM	ADD ASP. D/W
4	7/10/88	BM	ADDED TRAFFIC DELINEATION

7/6/88

SOUTHWEST ENGINEERING
LAND PLANNING • MAPING • DEVELOPMENT
1725 S. RAINBOW BLVD., STE. 23 • LAS VEGAS, NEVADA 89102
(702) 363-9700

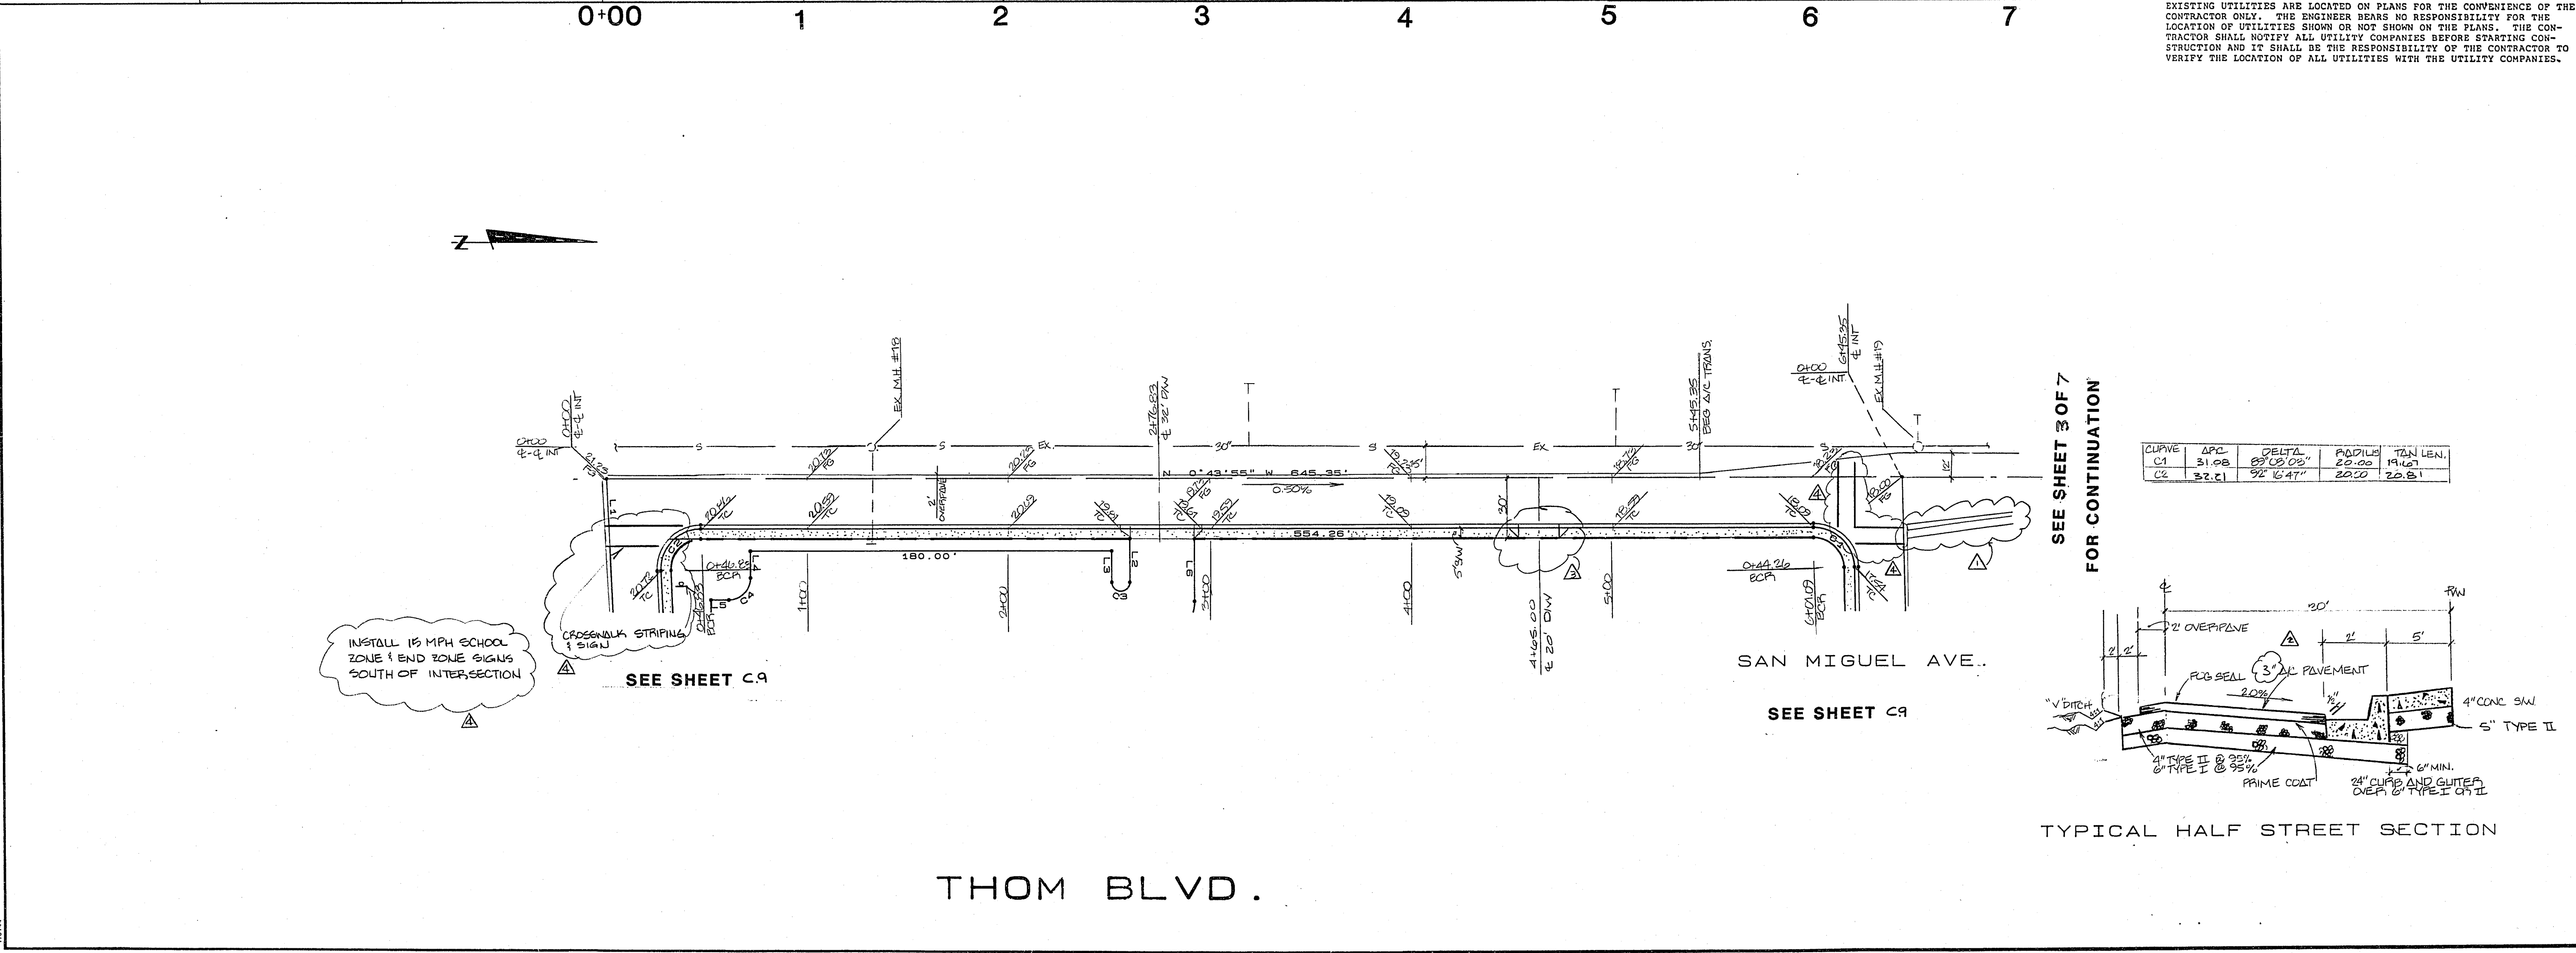

STREET PLAN & PROFILE
THOM BLVD

CLAUDE H. & STELLA PARSONS
ELEMENTARY SCHOOL

PROJECT

W.O. No. 871023
BY BM
DATE 6/88
1" = 4' VER. 1" = 40' HORZ.

SHEET 2 OF 7 SHEETS

715-63

EXISTING UTILITIES ARE LOCATED ON PLANS FOR THE CONVENIENCE OF THE CONTRACTOR ONLY. THE ENGINEER BEARS NO RESPONSIBILITY FOR THE LOCATION OF UTILITIES SHOWN OR NOT SHOWN ON THE PLANS. THE CONTRACTOR SHALL NOTIFY ALL UTILITY COMPANIES BEFORE STARTING CONSTRUCTION AND IT SHALL BE THE RESPONSIBILITY OF THE CONTRACTOR TO VERIFY THE LOCATION OF ALL UTILITIES WITH THE UTILITY COMPANIES.