RECORD OF SURVEY
FOR THE
NE¼, SE¼, SE¼, SEC. 20
T20S; R61E
CLARK CO. NEV

Abe & Louise Jaramillo — Owner

Map Scale 1"=30'

708-15

File A Map #1

Engineers Certificate

I Jack Pavin a Registered Prof Engineer and Land Surveyor in the State of Nevada do hereby certify that this survey of the parcel of land as shown was made at the instance of Abe and Louise Jaramillo, owners. That all monuments shown on this map exist physically and may be retraced from bearings and measurements as shown. That this survey was completed on Feb 15 1997. The boundaries of said tract being more specifically described as follows:

Commencing at the SE cor said Sec 20, T20S, R61E, which bears N0°33 25"W a distance of 6590 along said section line to the **True Point of Beginning**; thence N0°33 25"W a distance of 659.90' to a point, thence N89°50 03"W a distance of 661.62 to a point, thence S0°33 33"E a distance of 659.49 to a point, thence N89°46 08"E a distance of 661.15 to the **True Point of Beginning**

Reg Prof Engr & Land Surveyor no 286

Map Scale — 1 = 30

— Basis of Bearing —

Bearing accepted from Record of Survey Flat, File 1, Page 77 which is recorded on the East boundary of Sec 20 from the SE cor sec 20 to N ¼ cor 20 & 21 as S0°33 25"E

— General Notes —

o — Indicates Iron Pipe 4' below surf

—·—·— " Fence in place

⊕ ✚ — " Found sec cor

—— — — " Boundary

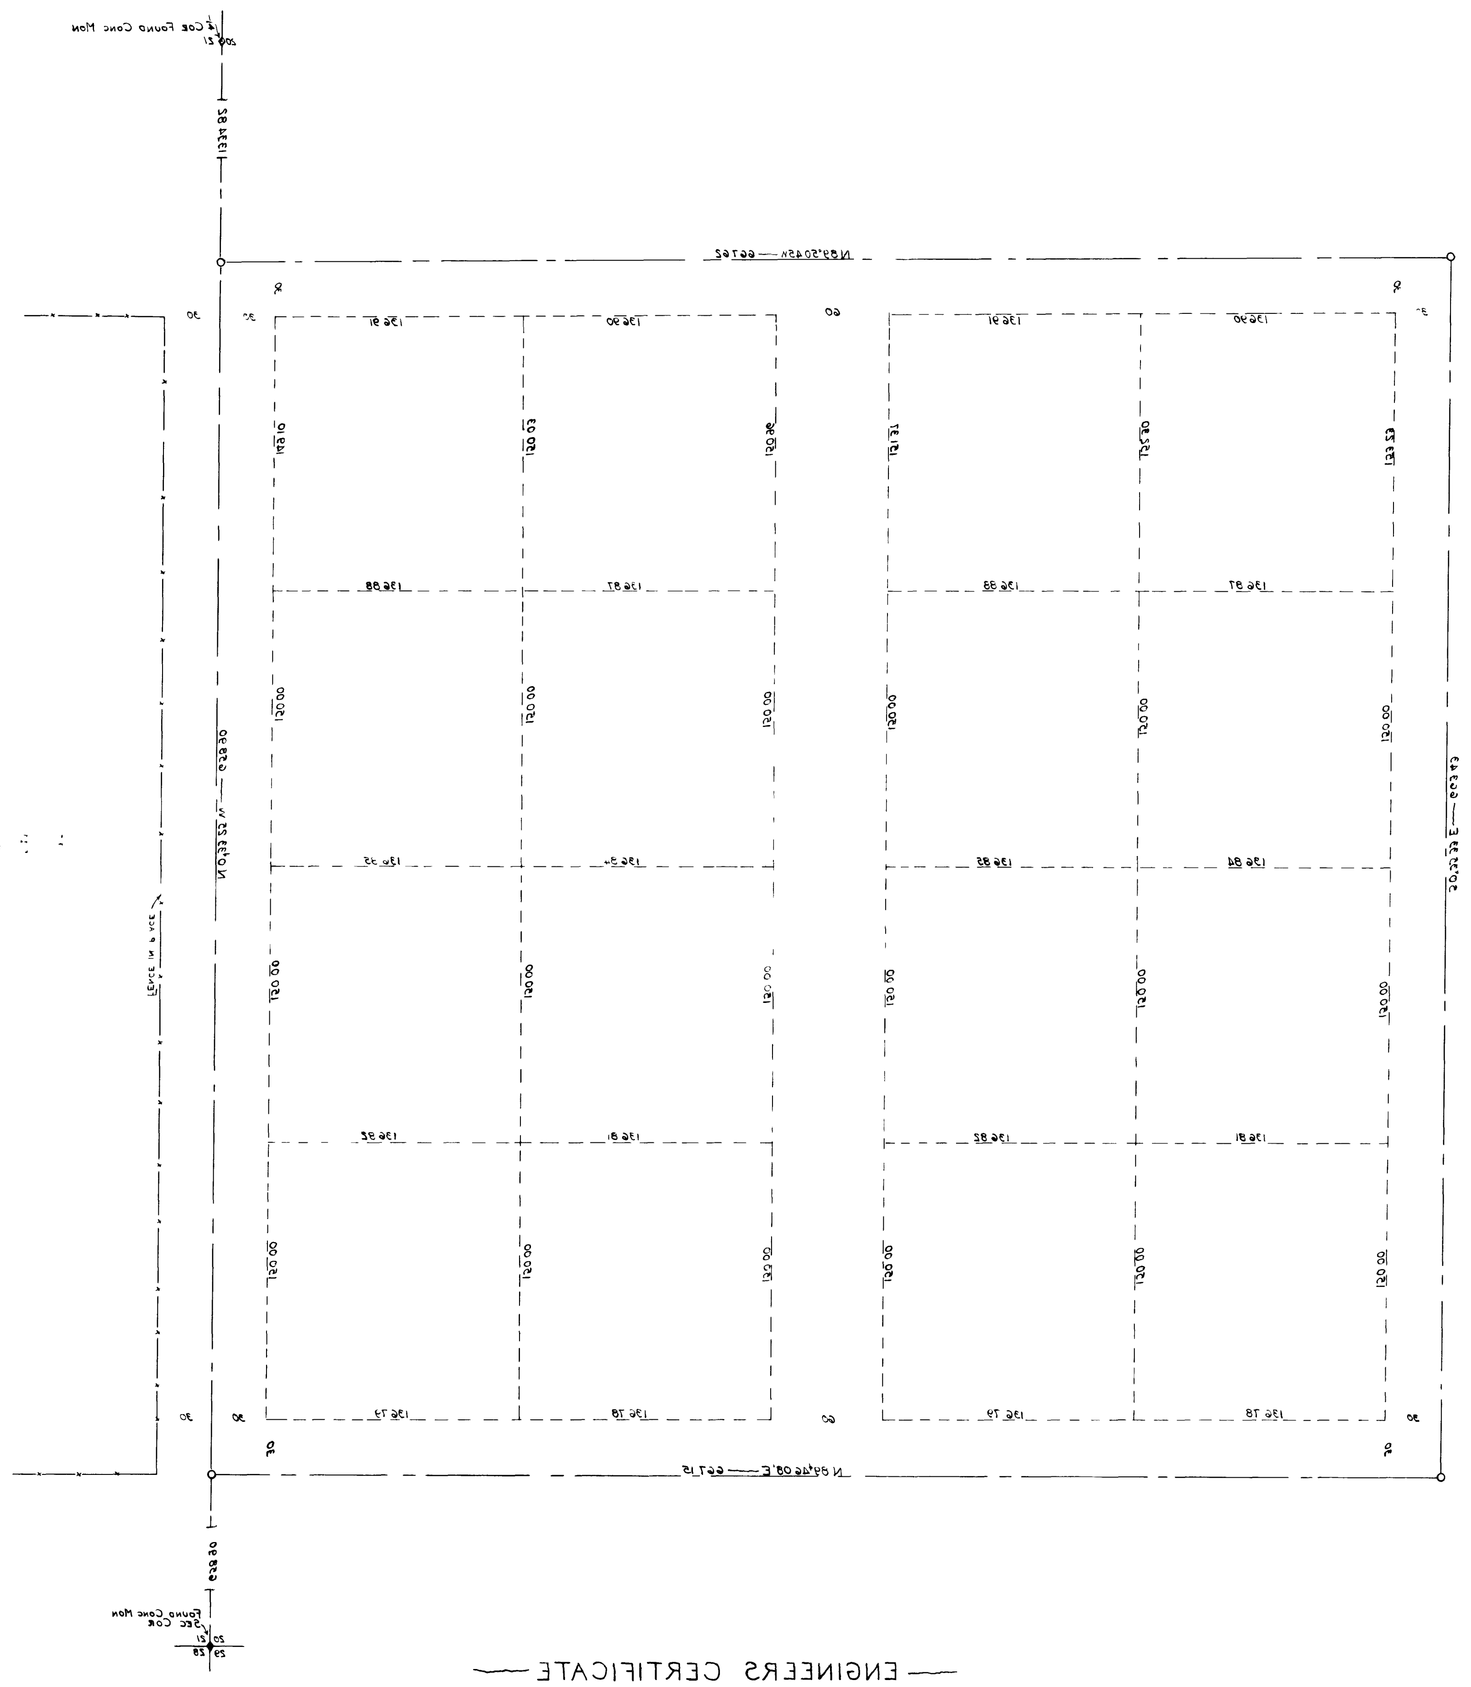
N89°50'03"W — 661.62
N 89°46'08"E — 661.15
S 0°33'33"E — 659.49
N 0°33'25"W — 659.90
1324.82
Found Cone Mon
Sec Cor
20 21
29 28
Found Cone Mon
Sec Cor
20 21
20 21
30
30
30
30
60
60
136.81
136.90
136.81
136.90
136.82
136.81
136.82
136.81
136.84
136.88
136.84
136.88
136.87
136.98
136.87
136.98
136.91
136.90
136.91
136.90
136.74
136.78
136.74
136.78
