MAP FOR RECORD OF SURVEY

FOR

JOHN ANTOSKY

W½ NW¼ NW¼ SEC.25,T21S,R60E.,
M.D.B&M.
CLARK COUNTY, NEVADA.

pl-80r

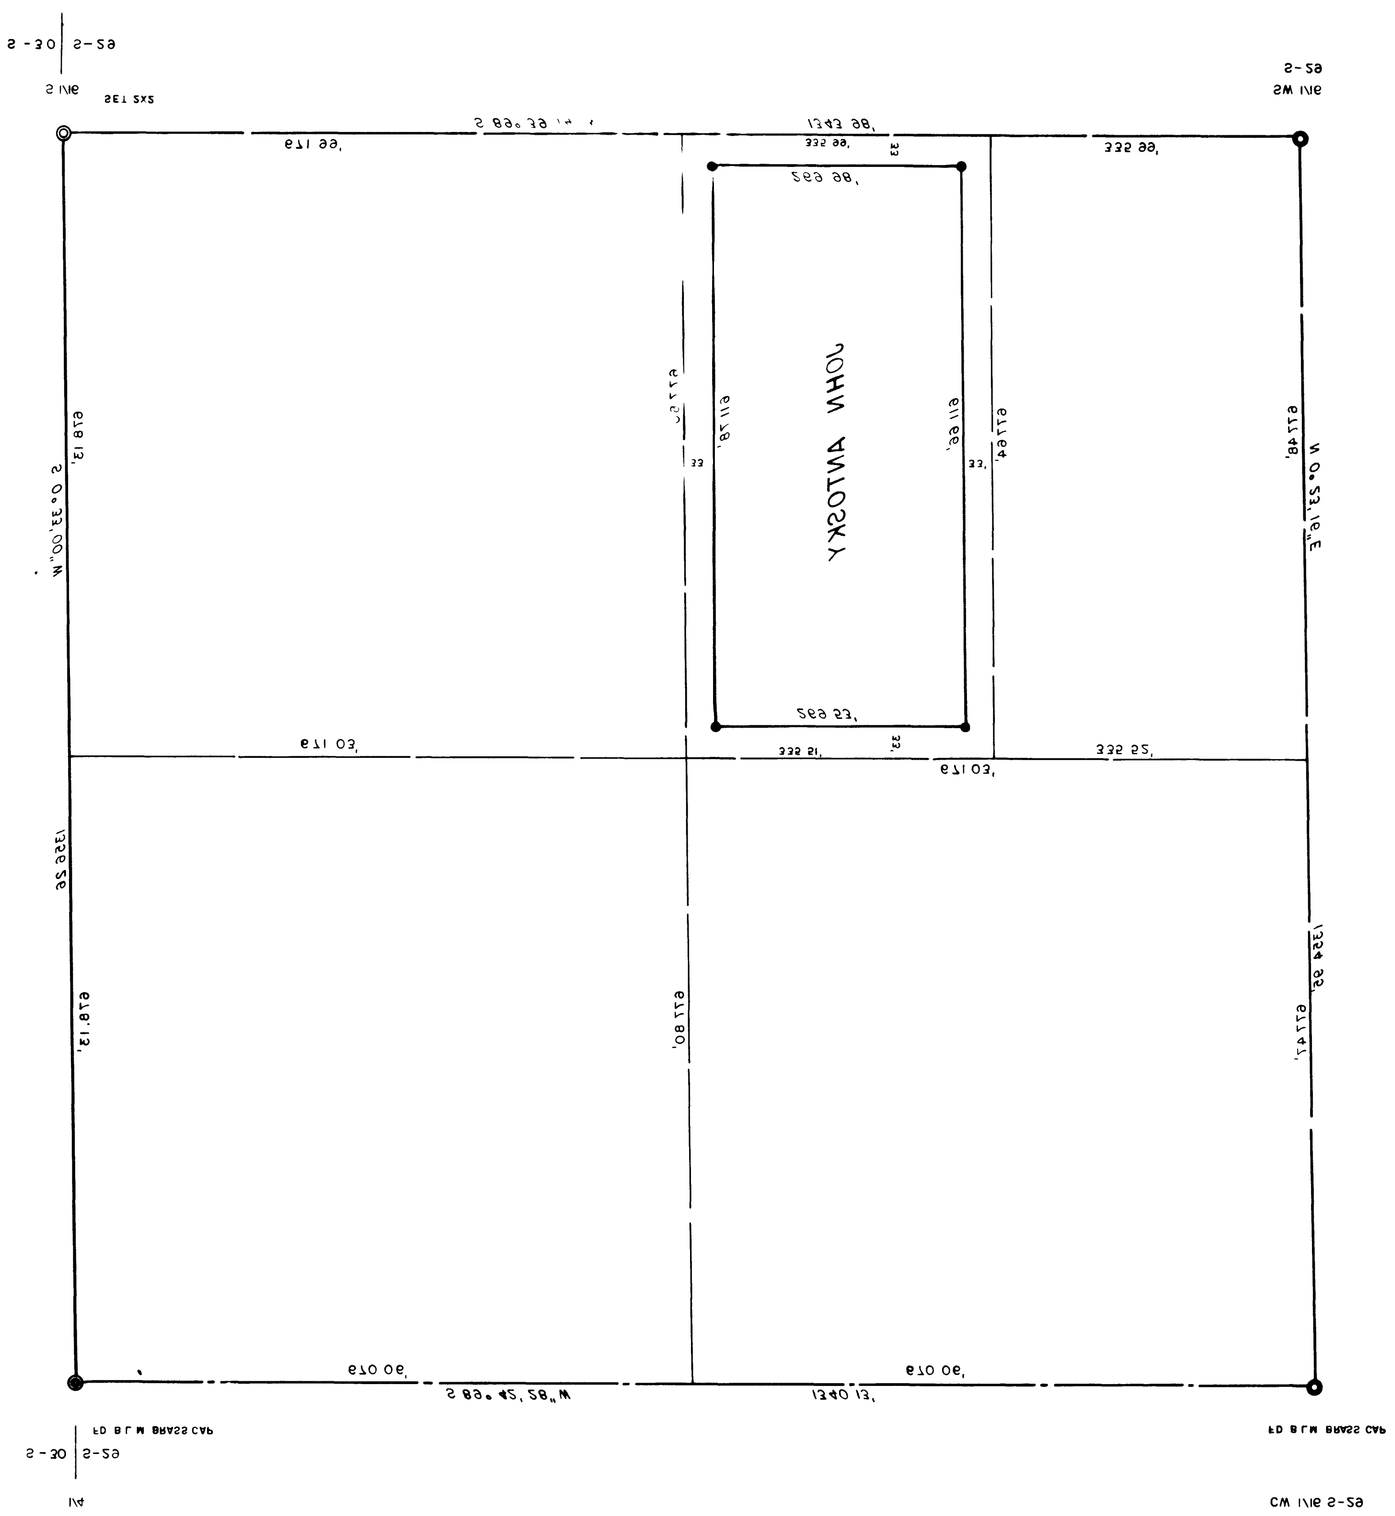
YKSOTNA NHOJ


