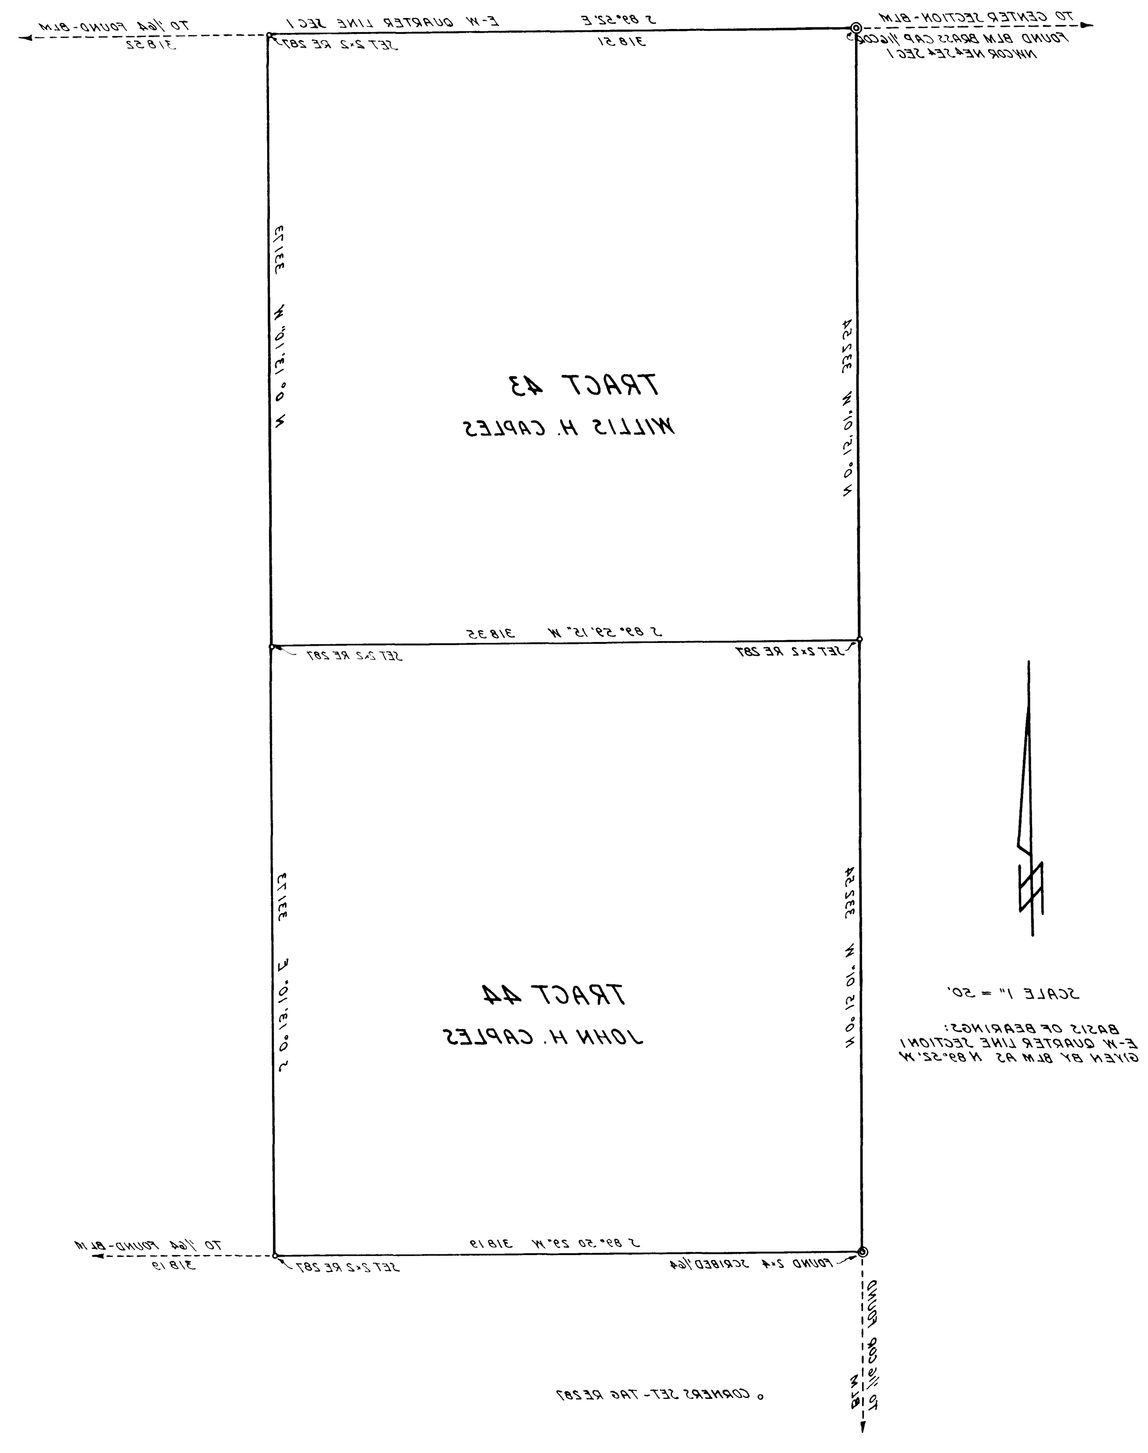

ENGINEER'S CERTIFICATE

I, F.M. Eaton, a duly registered Civil Engineer and Land Surveyor do hereby certify that the accompanying map truly and correctly represents the results of a survey made by me or the informer, of Vernon J. Caples on behalf of his sons Millis H. and John H. Caples, lessees of the tracts shown hereon that the map has proposed in field notes of said survey completed October 18 1982.

Registered Civil Engineer & Land Surveyor - 287

RECORD OF SURVEY

TRACTS 43 & 44

COMPRISING THE W½ NW¼ NE¼ SE¼ OF

SECTION 1, T.21S. R.60E. MDB&M

FOR

MILLIS H. CAPLES & JOHN H. CAPLES

LAS VEGAS-NEVADA

708-4

Vernon J. Caples

10 21 60 S 2.03 ST

Vernon J. Caples

Sec 24

708-4

File Sheet 37

708-4