


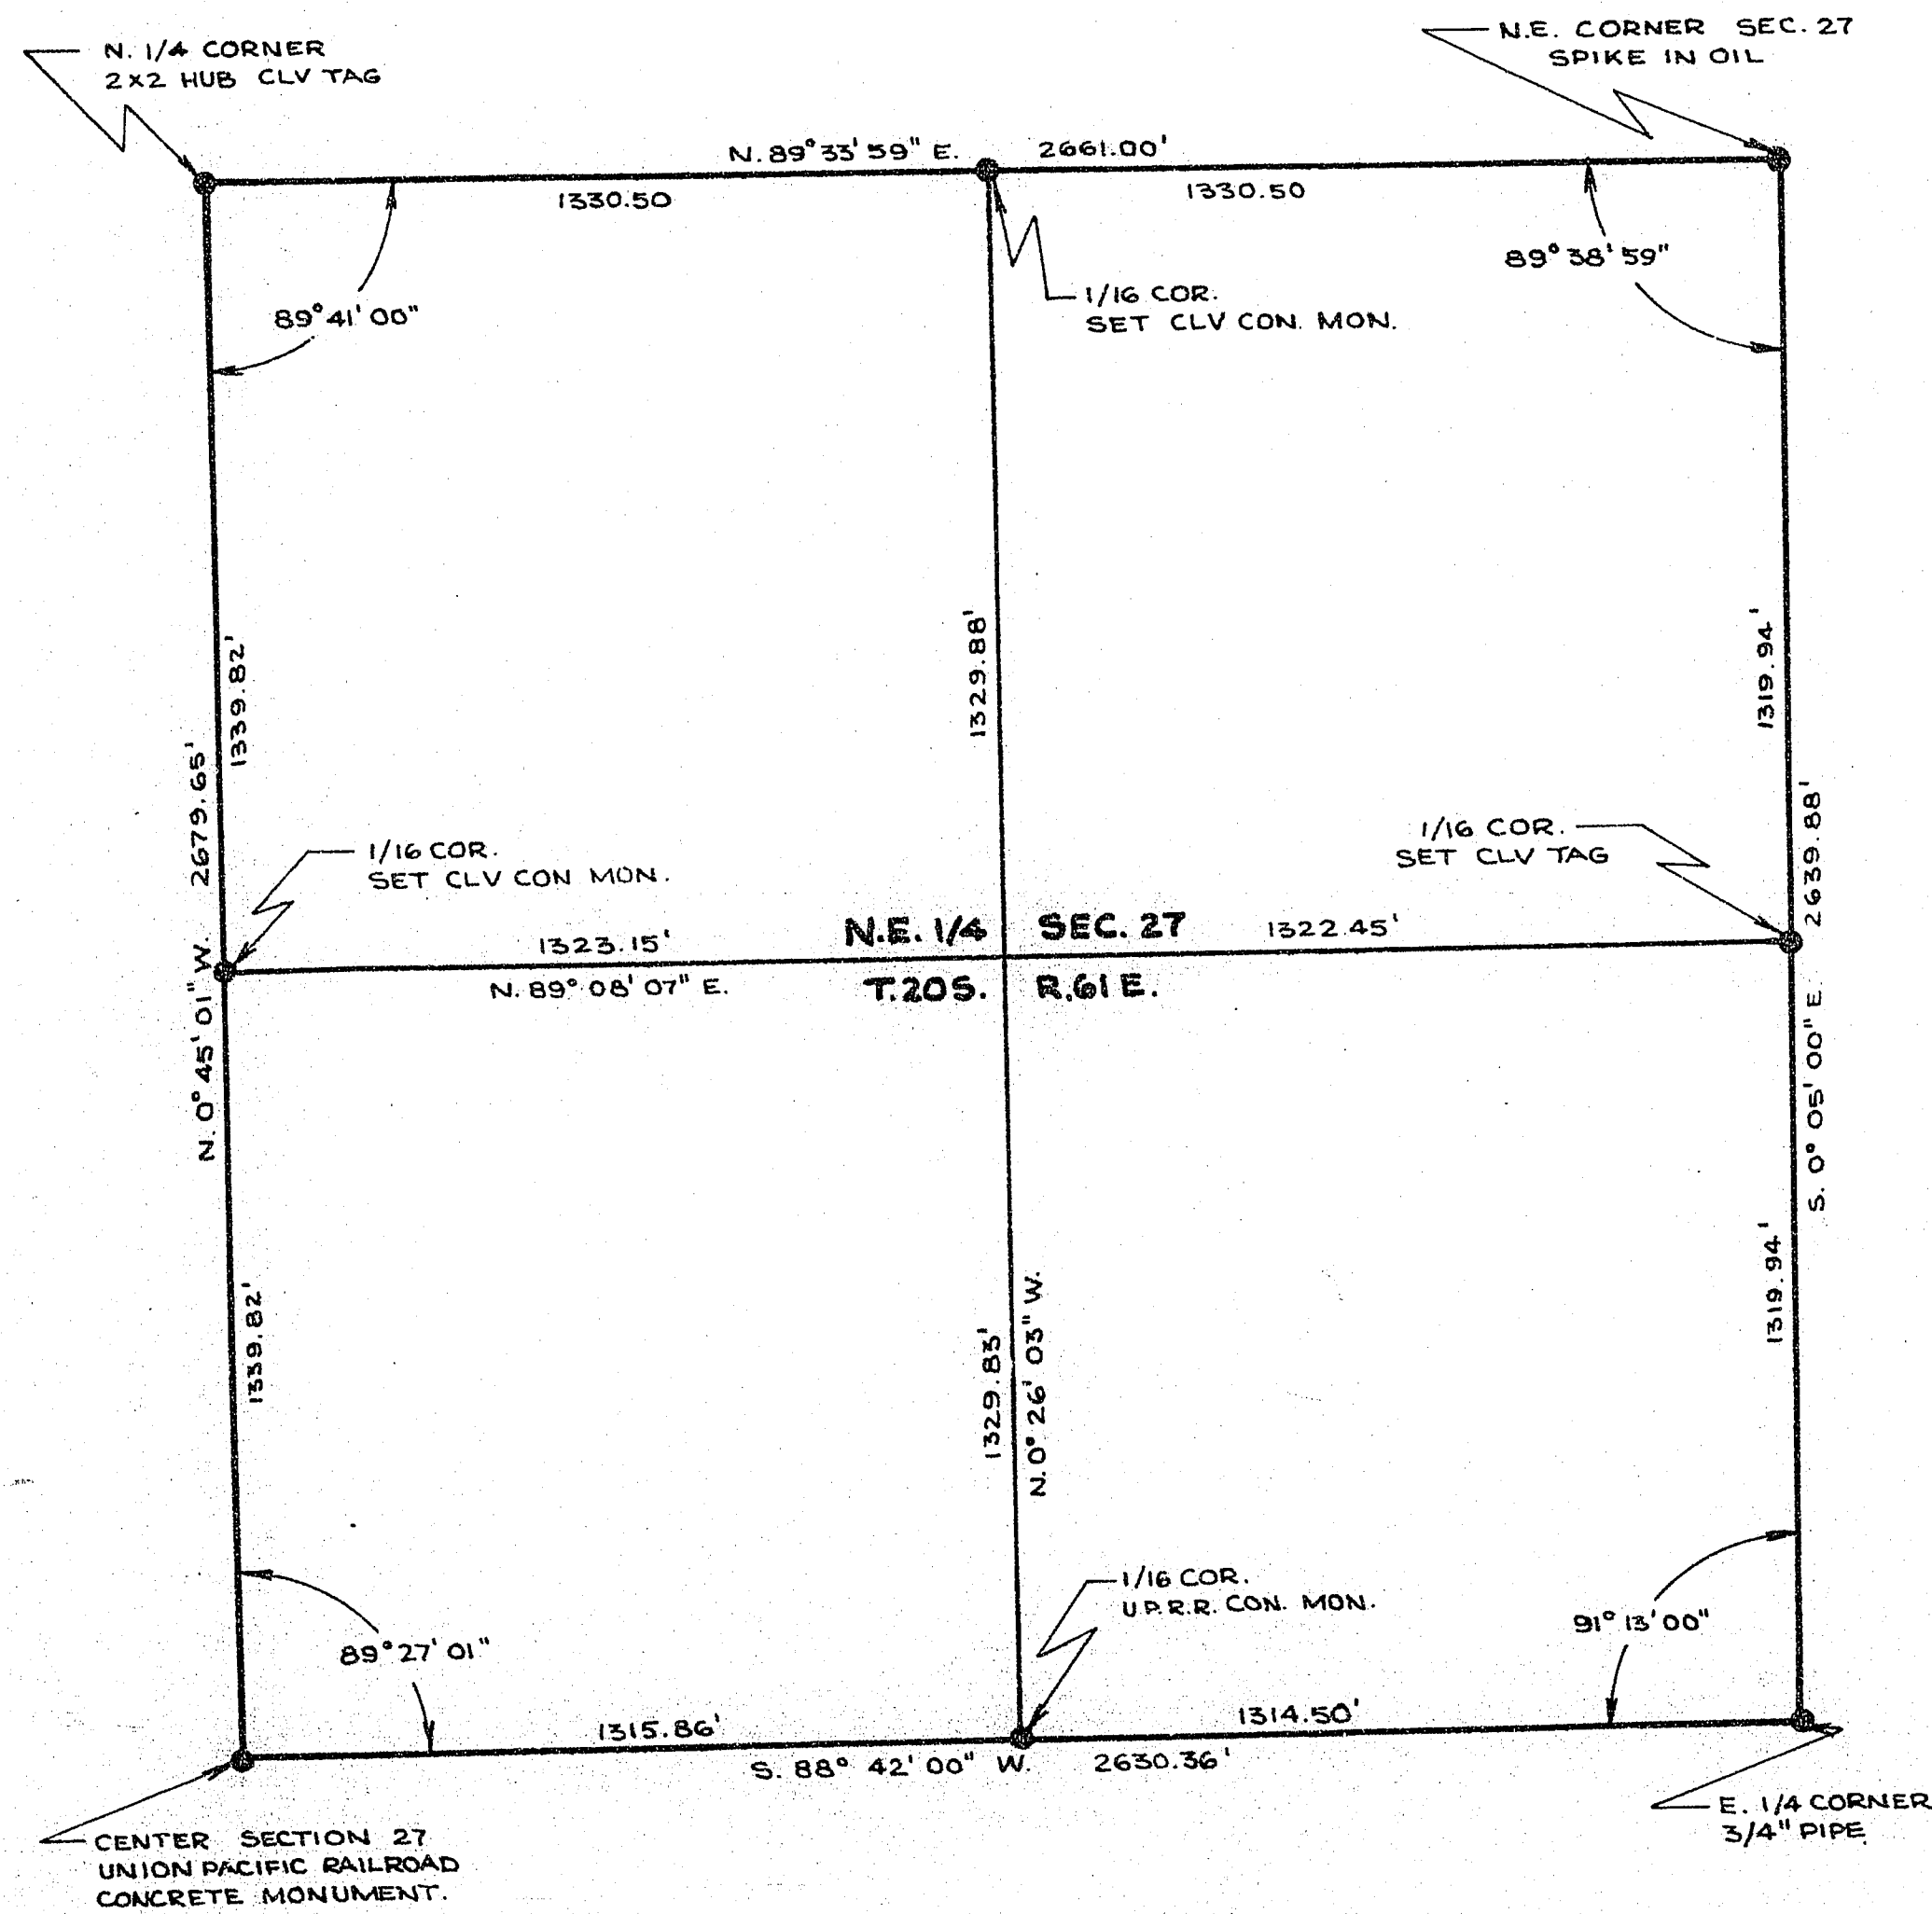

BASIS OF BEARINGS IS EAST SECTION
LINE SECTION 27. REF. RECORDED
SURVEY FILE 2 PAGE 84.



CITY OF LAS VEGAS NEVADA
ENGINEERING DEPT.

BOUNDARY SURVEY of NE 1/4 SECTION 27
T.20S., R.61E. M.D.B. & M.

DESIGNED BY	DATE	SCALE 1" = 30'
DRAWN BY R. WHITNEY	9/25/54	FIELD BOOK NO. 7X-107
CHECKED BY		WORK ORDER NO.
APPROVED		DRAWING NO.
CITY ENGR.		056 - 12

15-44