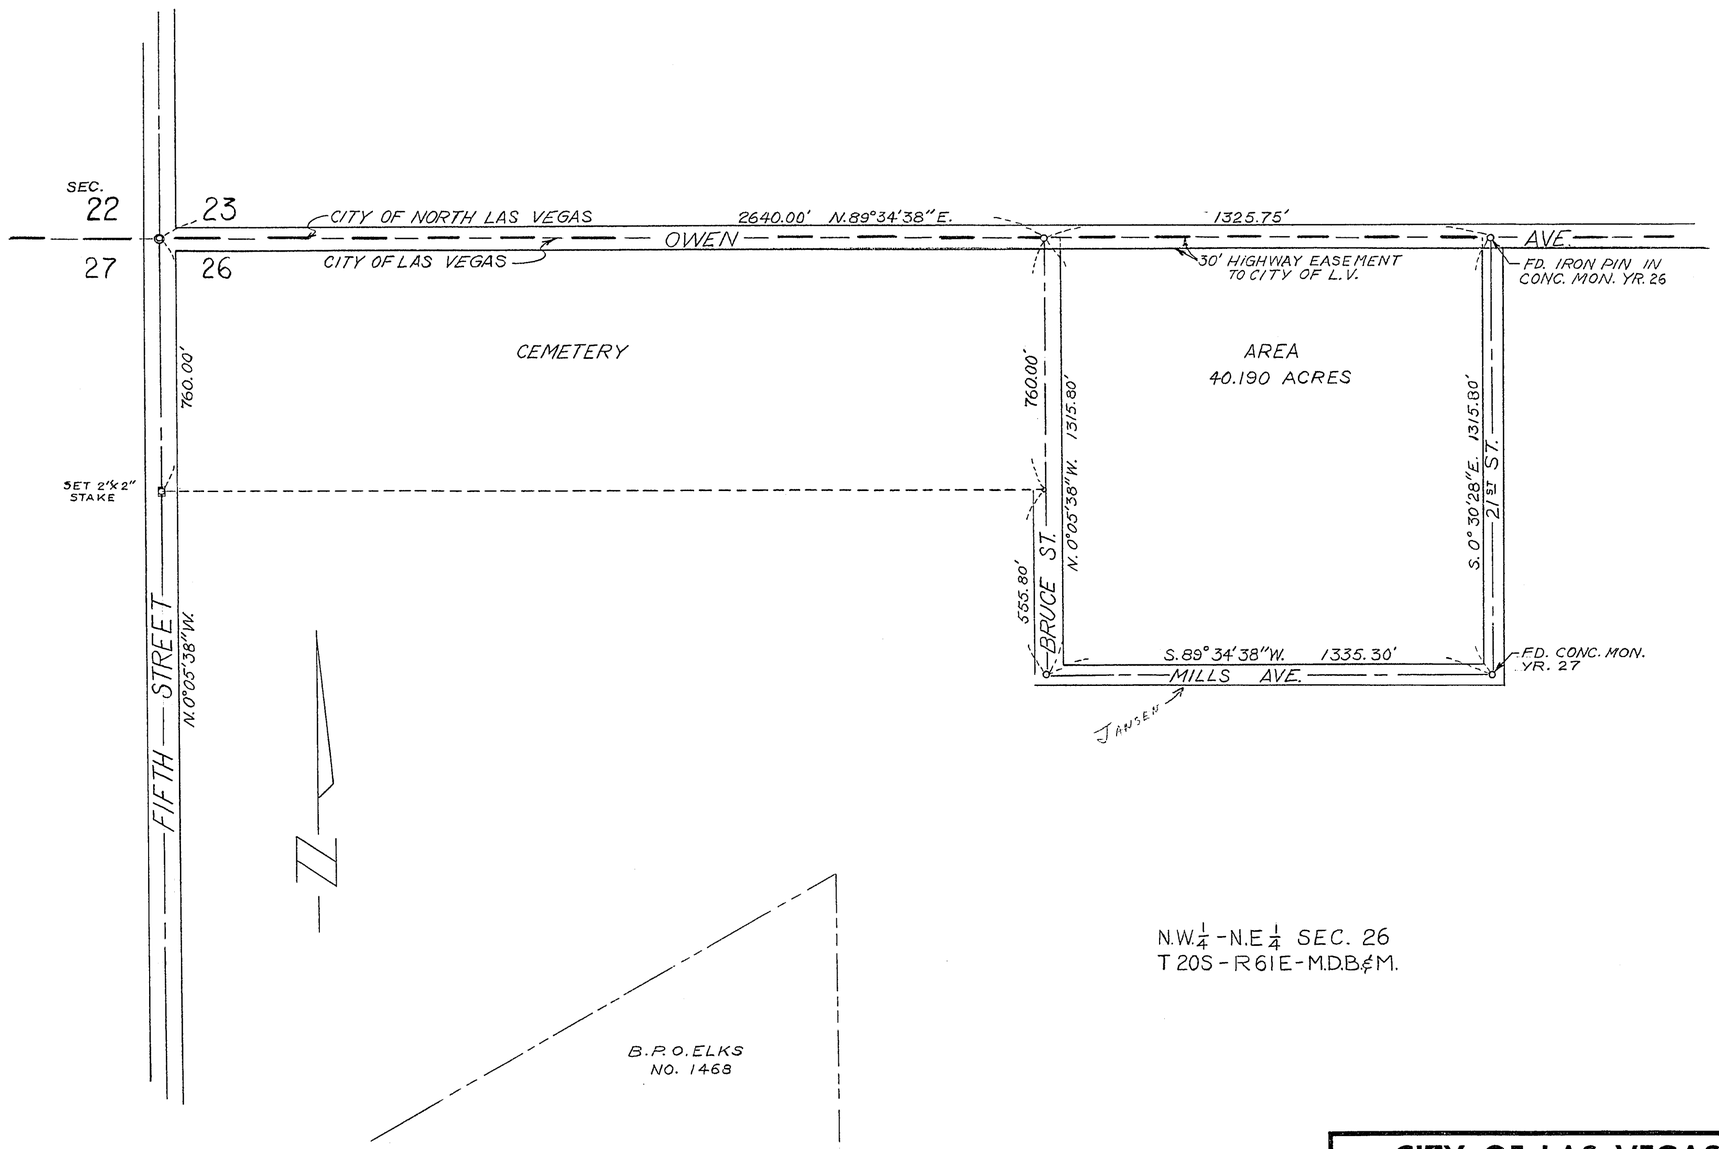

A-5A-28

CITY OF LAS VEGAS NEVADA
ENGINEERING DEPT.

L.V.L. & W.Co. BOUNDRY SURVEY
OF LAND DEEDED TO L.V.U.H.S. DISTRICT ← RANCHO HIGH

	DATE	SCALE 1" = 300'
DESIGNED BY	12-6-54	L.V.L & W.Co. F.B. 247 L. Pg 123-4
DRAWN BY LEA HARPER		L.V.L & W.Co. DWG. NO. B-631
CHECKED BY		DRAWING NO.
APPROVED CITY ENGR.		056-19

LIETZ 1118 TOPFLIGHT 150 10-54