


CONSTRUCTION KEY NOTES




1. CONSTRUCT TYPICAL SECTION PER STD. DWG. NO. 205.
2. CONSTRUCT 5' SIDEWALK PER STD. DWG. NO. 234
3. CONSTRUCT "L" TYPE CURB AND GUTTER PER STD. DWG. NO. 216.
4. CONSTRUCT 8" CROSS GUTTER PER STD. DWG. NO. 228.
5. LIMITS OF SAWCUT.
6. REMOVE EXISTING PAVEMENT.
7. REMOVE EXISTING SIDEWALK.
8. REMOVE EXISTING CURB AND GUTTER.
9. RELOCATE EXISTING STREETLIGHT, CONSTRUCT FOUNDATION PER STD. DWG. NO. 318 (REMOVE EXISTING CONDUIT & PULLBOXES).
10. ADJUST MANHOLE TO FINISHED GRADE.
11. INSTALL 1 1/4" STREETLIGHT CONDUIT W/2-#4, 1-#8THW (TYP) (BENEATH SIDEWALK).
12. CONSTRUCT SIDEWALK DRAIN PER STD. DWG. NO. 236.
13. CONSTRUCT SIDEWALK RAMP STD. DWG. NO. 235 CASE III(A=B=8)
14. CONSTRUCT SIDEWALK RAMP PER STD. DWG. NO. 235 CASE III(A=4.5, B=12)
15. CONSTRUCT SIDEWALK RAMP PER STD. DWG. NO. 235 CASE III(A=4.5, B=9.5)
16. SEE DETAIL "P" ON SHEET C6.01 FOR STREET LIGHT LOCATION AND NOTE.

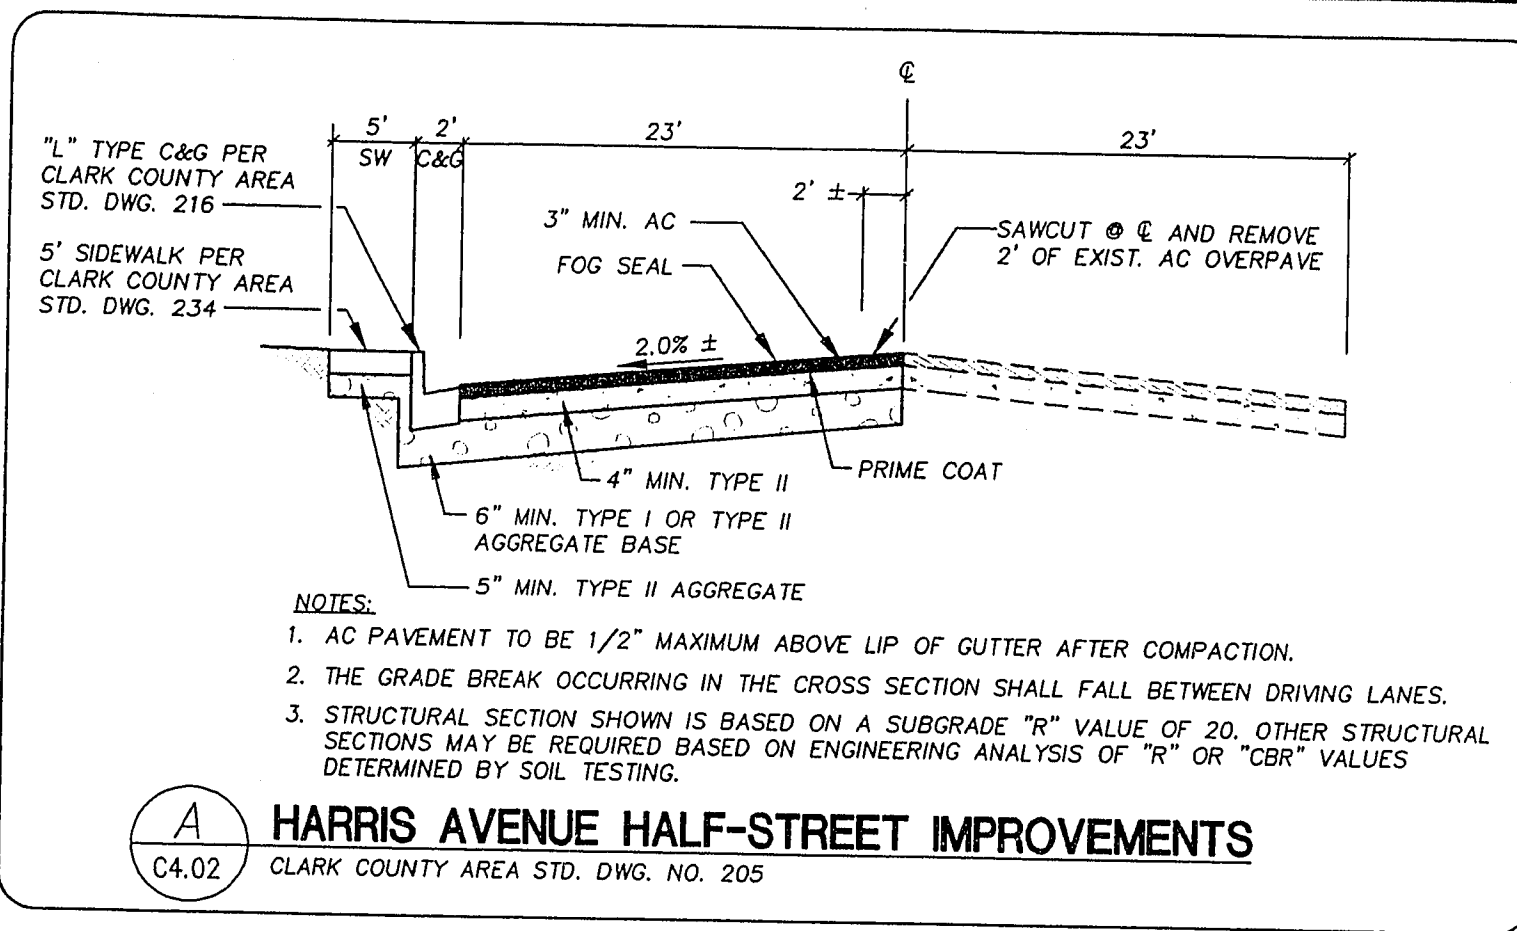

BENCHMARK

CITY OF LAS VEGAS BENCHMARK NUMBER 2LV01-25SSSW6:
RIVET AND PLATE IN TOP OF CURB ON THE NORTHEAST RETURN OF BONANZA ROAD AND MCKNIGHT STREET.
NAVD 88 DATUM
ELEVATION = 1828.30 FEET
ELEVATION = 557.266 METERS

Call before you Dig
1-800-227-2600

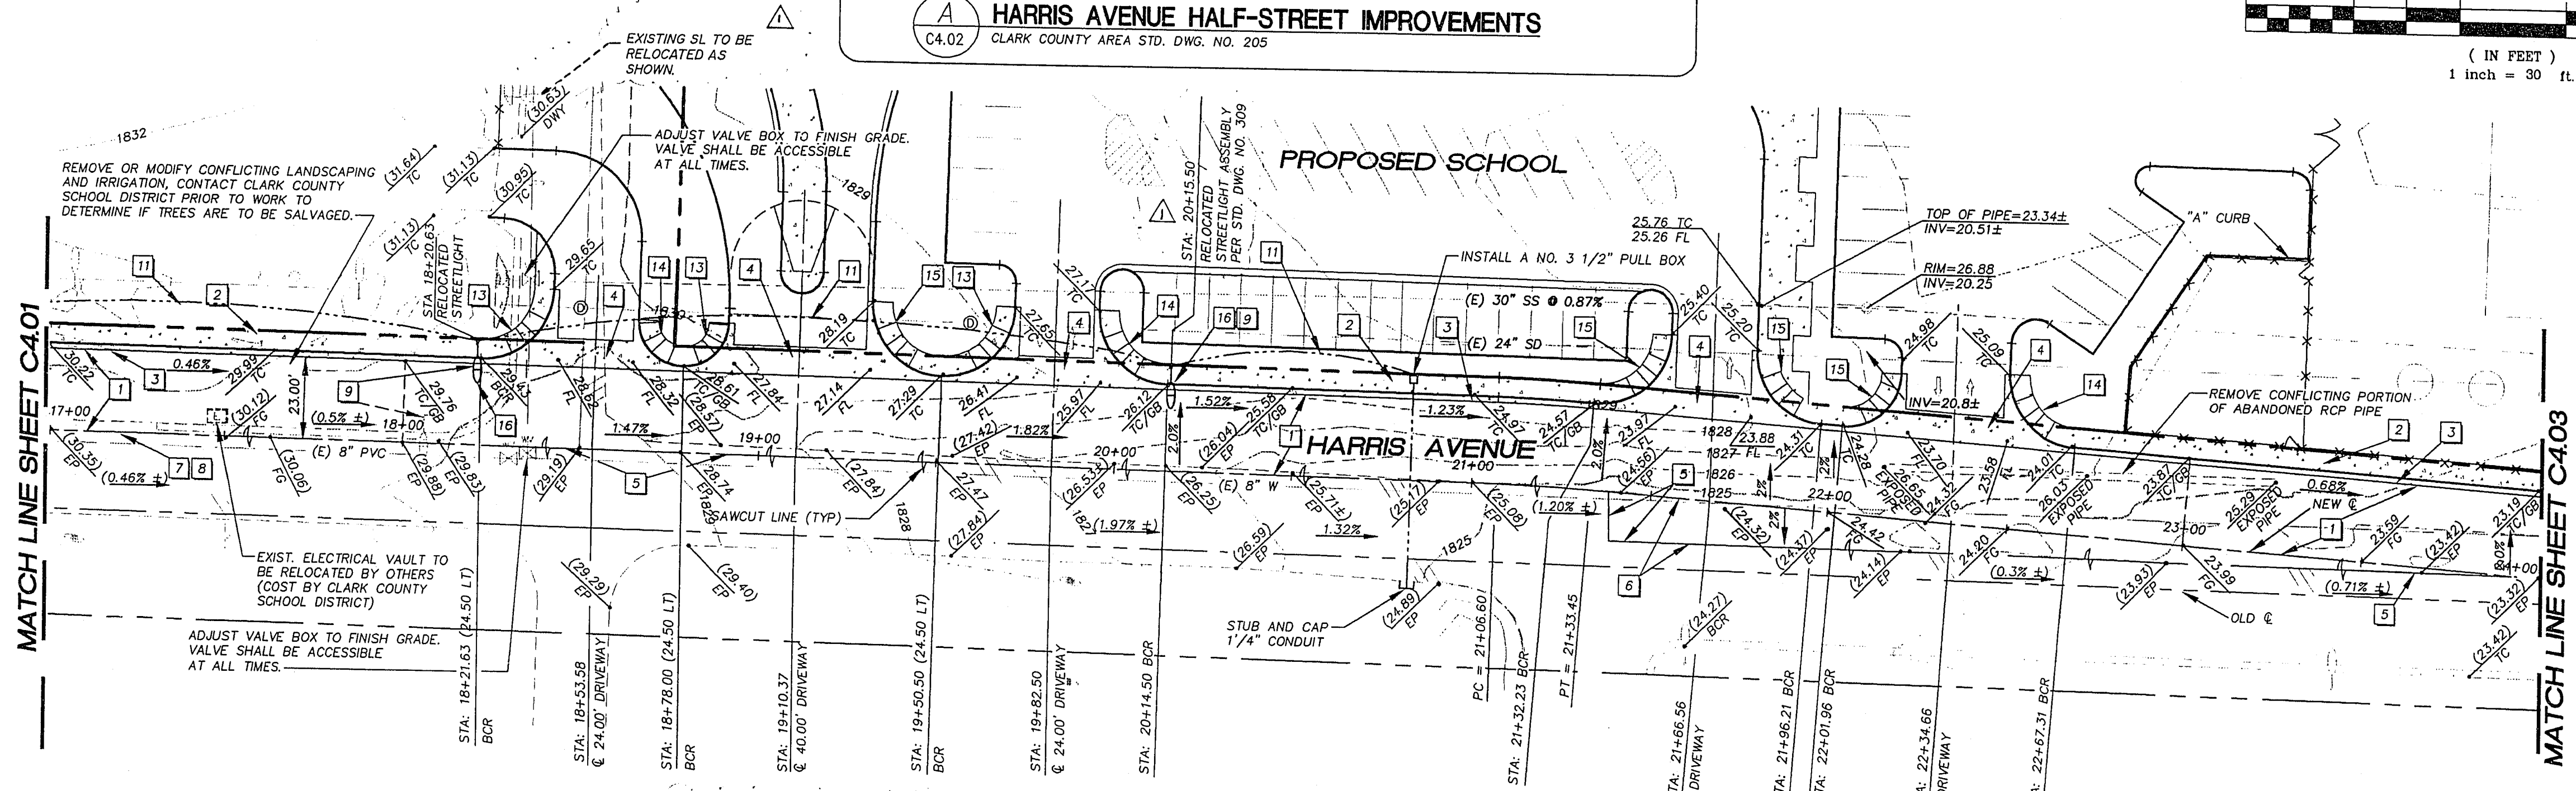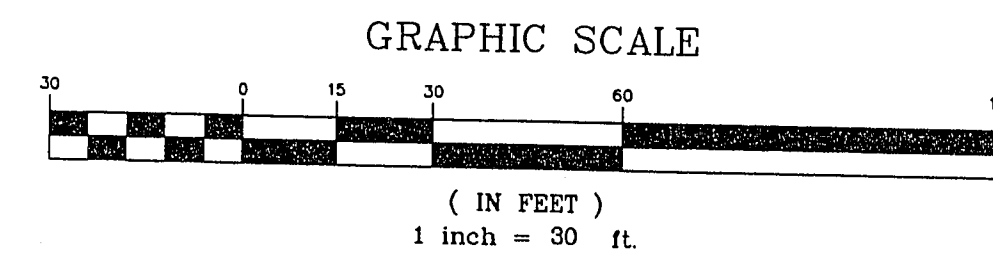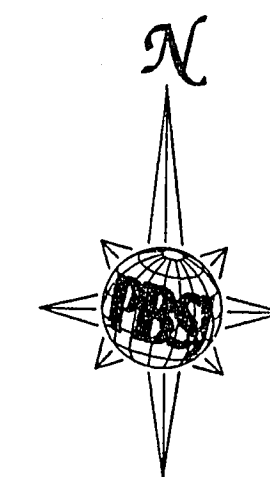


- NOTES:**
1. REFER TO SHEET C4.01 FOR ADDITIONAL STREETLIGHT IMPROVEMENTS.
 2. CONTRACTOR TO MINIMIZE DOWN TIME OF STREETLIGHTS. REFERENCE SECTION 6236.03.01 IN THE "UNIFORM STANDARDS SPECIFICATIONS FOR PUBLIC WORKS" CONSTRUCTION OFF-SITE IMPROVEMENTS, CLARK COUNTY AREA, NEVADA.


REVISIONS			
REV	DESCRIPTION	DATE	BY
1	STREETLIGHT AND SL NOTE REVISIONS PER CLV	5/22/96	VRH

DOMINGO CAMBEIRO CORPORATION 1995

All designs, arrangements and plans indicated or presented by this drawing, as instruments of service, are owned by and the property of DOMINGO CAMBEIRO CORPORATION. To alter these documents for any project by anyone other than the original architect is a violation of NRS 623. The plans and/or specifications shall be restricted to the original site for which they were prepared and publication thereof is expressly limited to such use. Reproduction, publication or re-use by any method in whole or in part, is prohibited. None of such designs, arrangements or plans shall be used by or disclosed to any person, firm, agency, or corporation without the written permission of DOMINGO CAMBEIRO CORPORATION. Visual contact with these plans and specifications shall constitute prima facie evidence of acceptance of these restrictions.

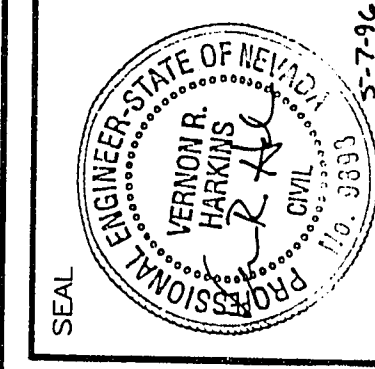

PROJECT NO.	0828
DATE	5/01/96
DESIGNED BY	KAW
CHECKED BY	VRH
APPROVED BY	5/01/96
DATE	95252

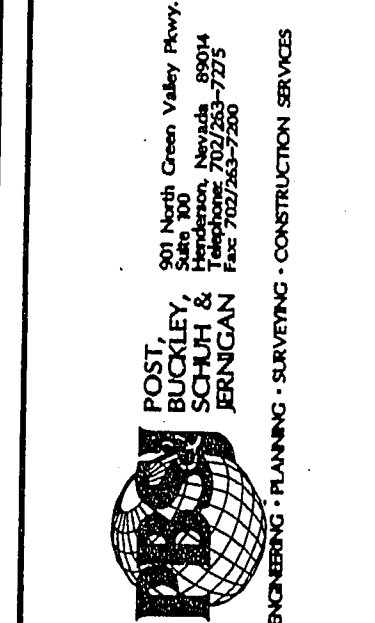

Domingo Cambeiro Corporation

ARCHITECTURE • ENGINEERING • PLANNING • INTERIORS

3555 PECOS-MCLEOD IC. LAS VEGAS, NEVADA 89121-3805 (702) 732-0084

CLARK COUNTY SCHOOL DISTRICT

LAS VEGAS, NEVADA 89121

28TH AND HARRIS ELEMENTARY SCHOOL

HARRIS AVENUE STA. 17+00.00 THRU 24+00.00

SHEET NO.

C4.02

SHEET 9 OF 17

JOB NO. 51843
FILE NO. 84305.DWG BR-052