



CONSTRUCTION KEY NOTES (THIS SHEET ONLY)


1. CONSTRUCT 24' PAVED ACCESS ROAD PER CLARK COUNTY AREA STD DWG NO. 209
2. MATCH PROPOSED AC TO EXISTING AC ELEVATION
3. CONSTRUCT A 4" WIDE CONCRETE VALLEY GUTTER

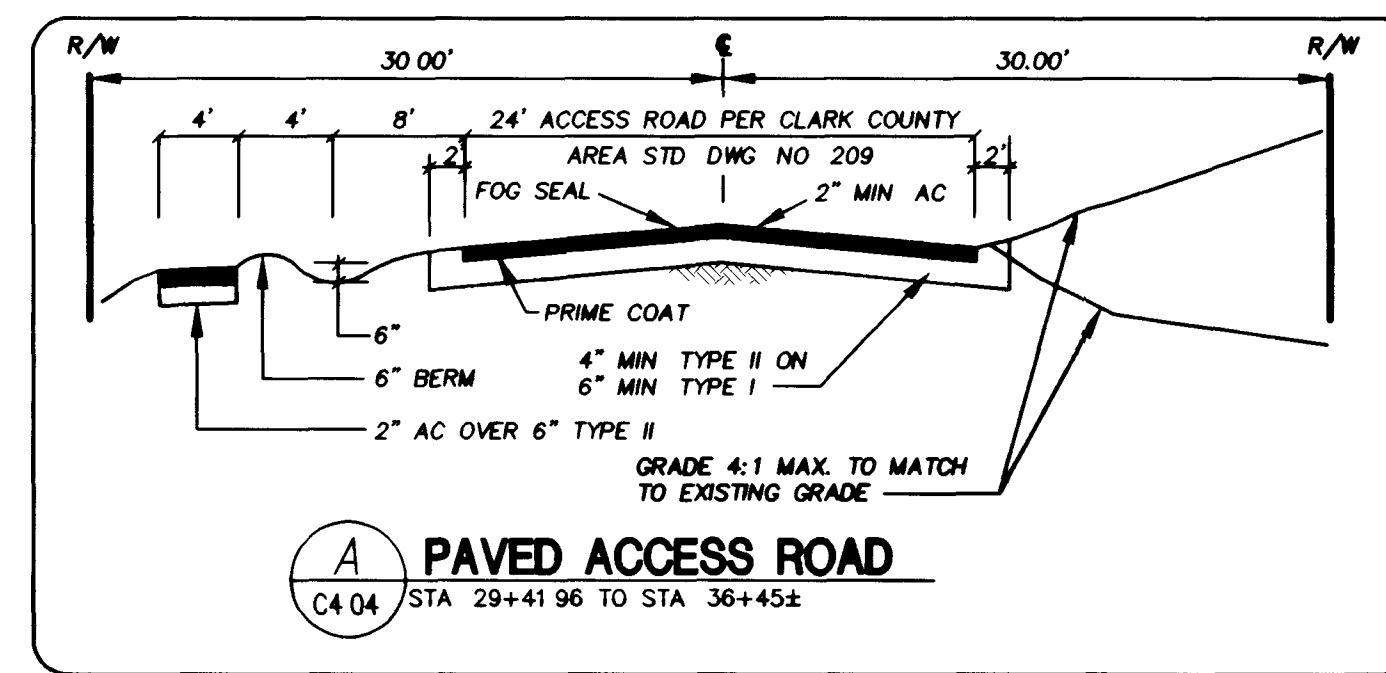


BENCHMARK
CITY OF LAS VEGAS BENCHMARK NUMBER 2LW1-25SSSW6
RIVET AND PLATE IN TOP OF CURB ON THE NORTHEAST RETURN OF BONANZA ROAD AND MCKNIGHT STREET
NAVD 88 DATUM
ELEVATION = 1828.30 FEET
ELEVATION = 557.266 METERS

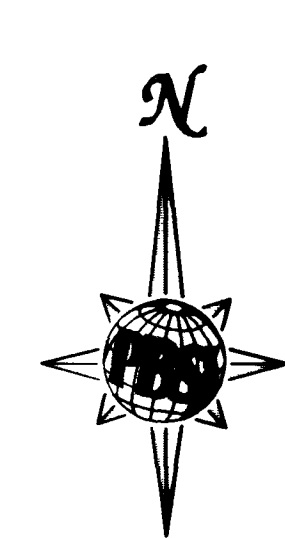

Call before you Dig
1-800-227-2600

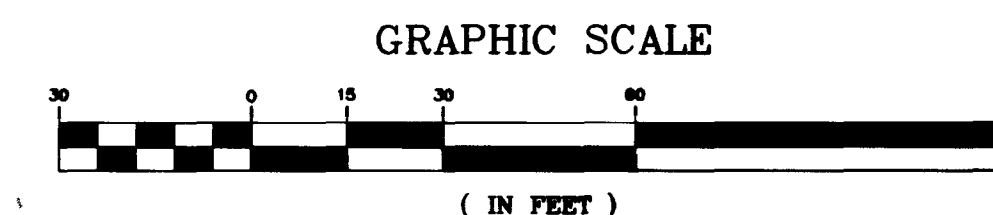


MATCH LINE SEE SHEET C4.03

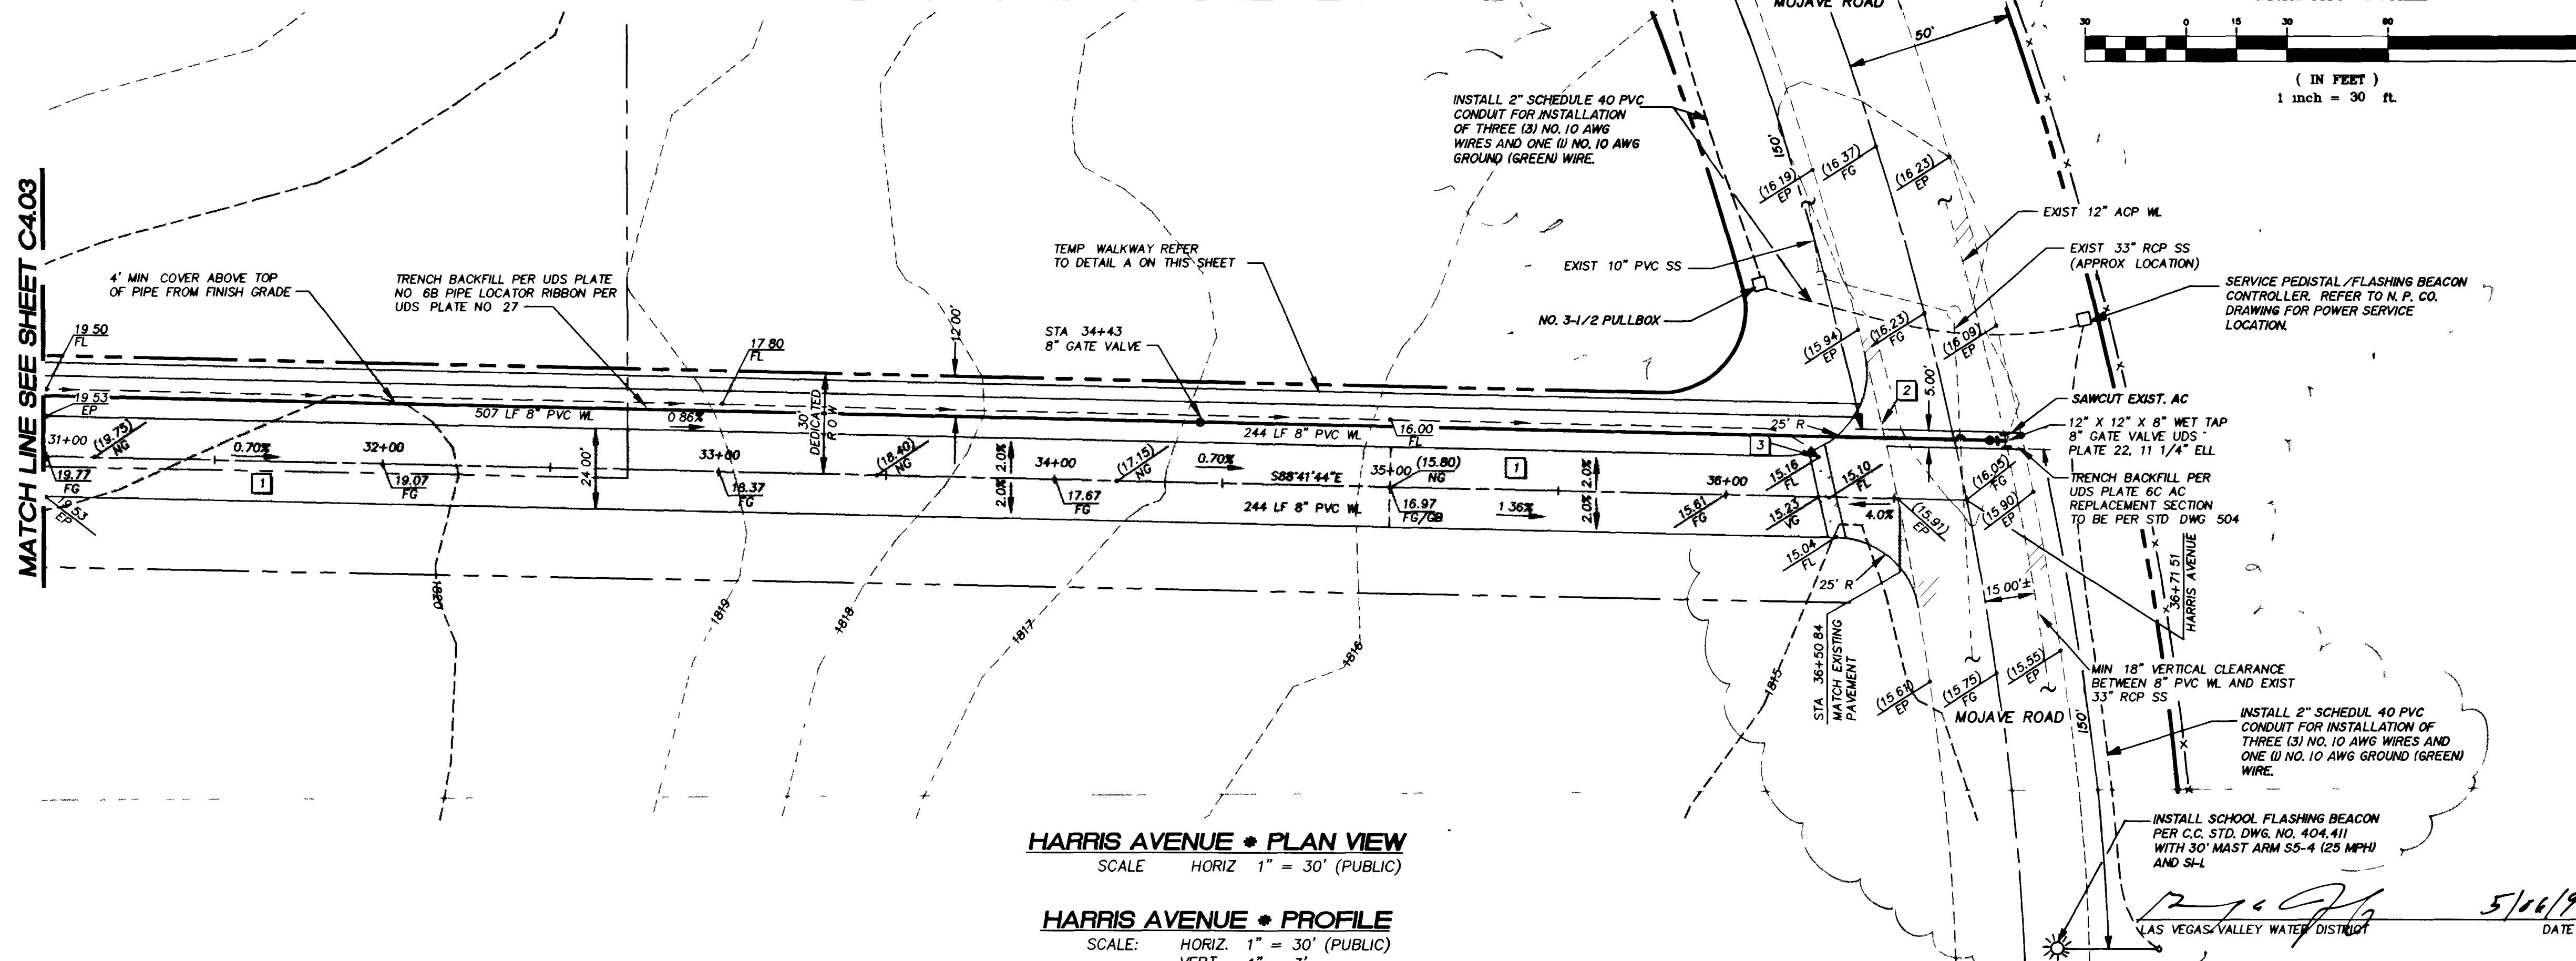

HARRIS AVENUE - PLAN VIEW
SCALE: HORIZ. 1" = 30' (PUBLIC)

HARRIS AVENUE - PROFILE
SCALE: HORIZ. 1" = 30' (PUBLIC)
VERT. 1" = 3'

MATCH LINE SEE SHEET C4.03

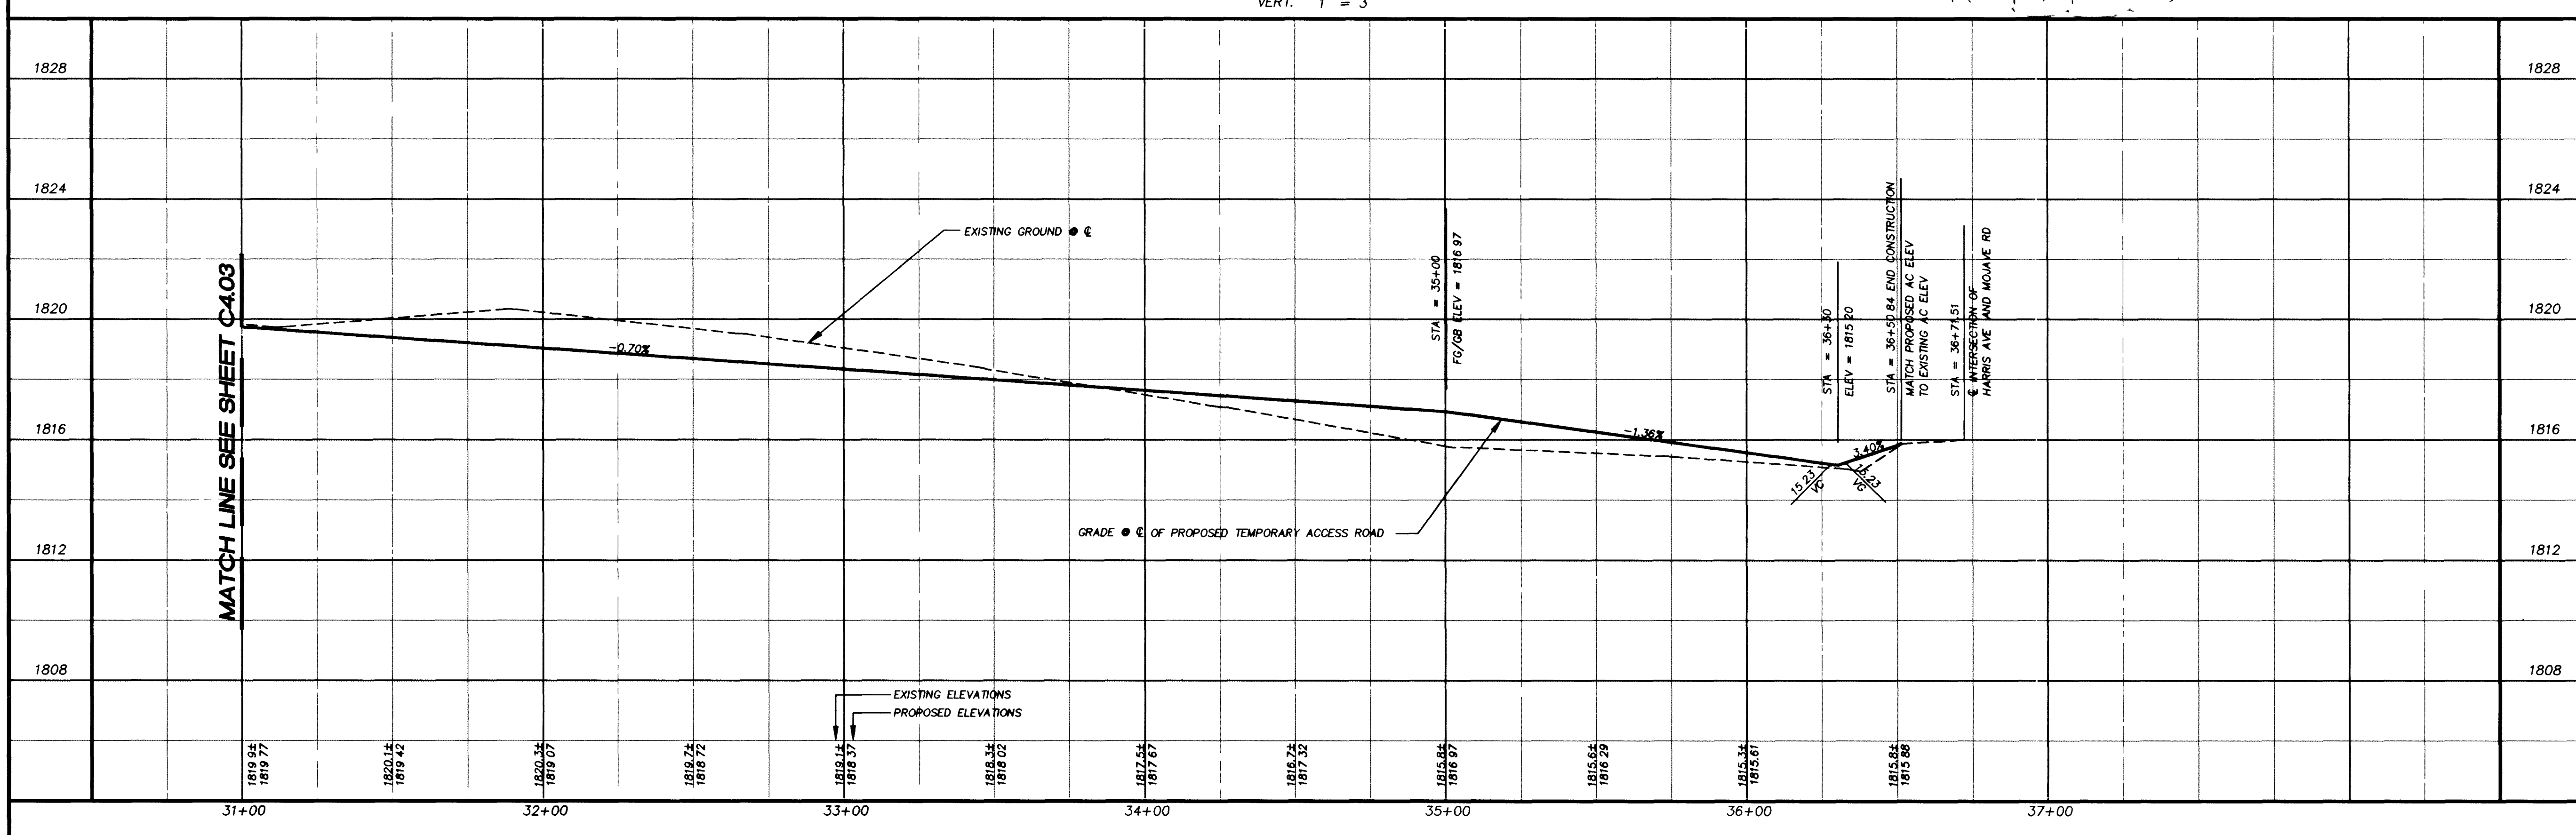

REVISIONS			
REV	DESCRIPTION	DATE	BY
1	ADDED FLASHING BEACONS ON MOJAVE	7/26/96	VRH

© DOMINGO CAMBEIRO CORPORATION 1995

All designs, arrangements and plans indicated or presented by this drawing, as instruments of service, are owned by and the property of DOMINGO CAMBEIRO CORPORATION. To alter these documents for any project by anyone other than the original architect is a violation of NRS 623. The plans and/or specifications shall be restricted to the original site for which they were prepared and publication thereof is expressly limited to such use. Reproduction, publication or re-use by any method in whole or in part is prohibited. None of such designs, arrangements or plans shall be used by or disclosed to any person, firm, agency, or corporation without the written permission of DOMINGO CAMBEIRO CORPORATION. Visual contact with these plans and specifications shall constitute prima facie evidence of acceptance of these restrictions.

SEAL	VERNON R. CAMBEIRO	REGISTERED PROFESSIONAL ENGINEER	NO. 9551	STATE OF NEVADA
DATE	5/01/96	BY	KAW	5/01/96
DATE	5/01/96	BY	VRH	5/01/96
DATE	5/01/96	BY	95252	5/01/96

POST OFFICE BOX 1000
CLARK COUNTY SCHOOL DISTRICT
LAS VEGAS, NEVADA 89121


DOMINGO CAMBEIRO CORPORATION
ARCHITECTURE • ENGINEERING • PLANNING • INTERIORS
3555 PECOS-MCLEOD IC LAS VEGAS, NEVADA 89121-3805 (702) 732-0084

CLARK COUNTY SCHOOL DISTRICT
CONSTRUCTION MANAGEMENT
4828 PEARL ST.
LAS VEGAS, NEVADA 89121

28TH AND HARRIS ELEMENTARY SCHOOL
HARRIS AVENUE STA. 31+00.00 THRU 36+71.51

SHEET NO.
C4.04
SHEET 11 OF 17
JOB NO. 51843
FILE NO. 84305.DWG BR-054

525

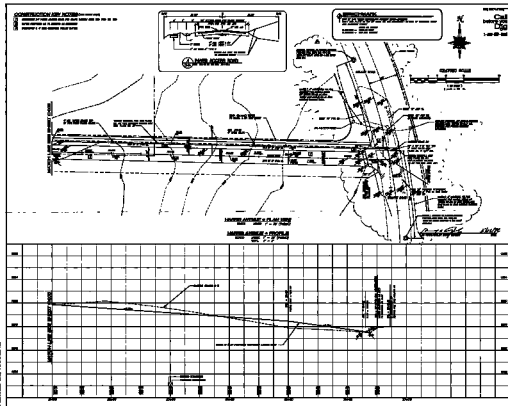

574

Page 1 of 1	
Page 1 of 1	














































 WEST 98

C404





