



C-66

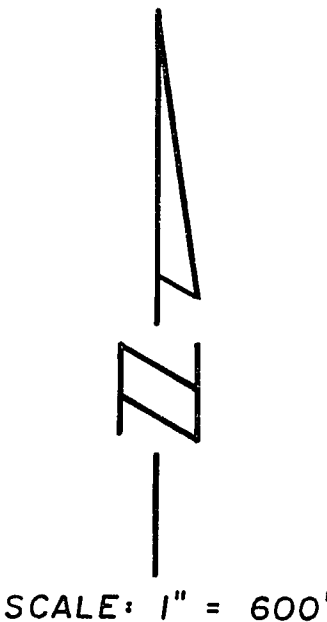


SCALE: 1" = 600'

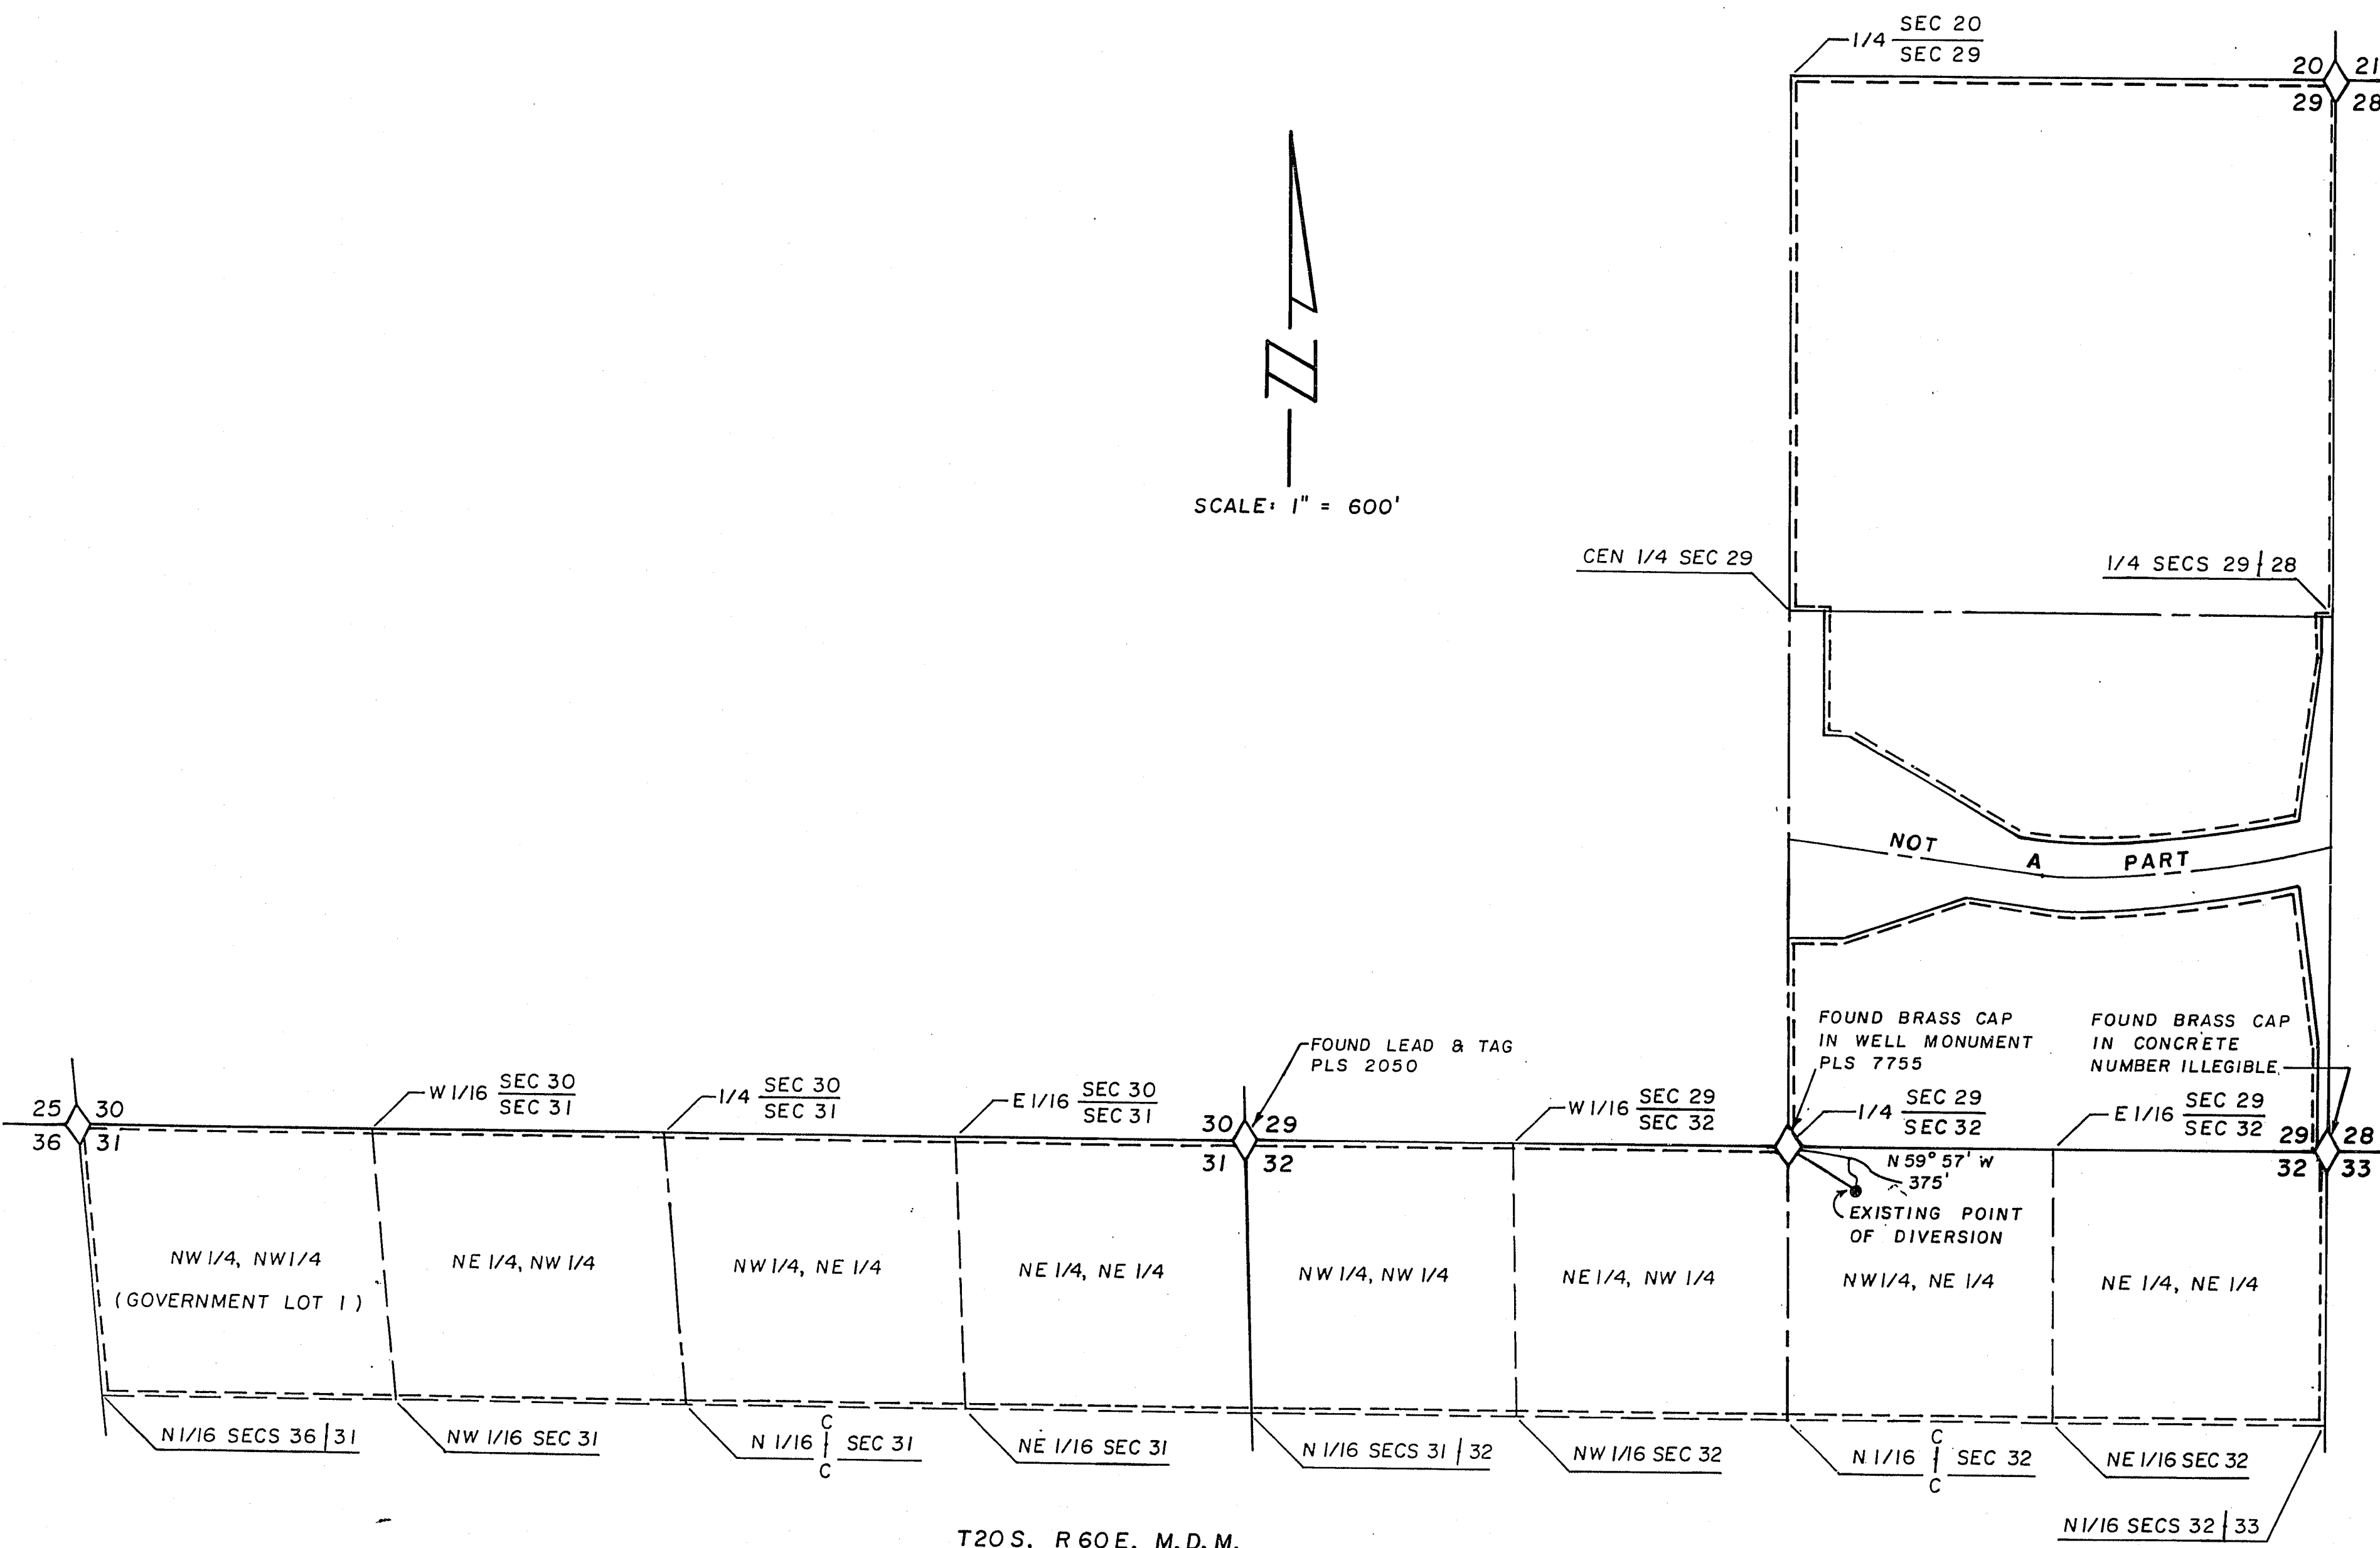


STATE OF NEVADA
COUNTY OF CLARK

I, CHARLES KAJKOWSKI, BEING FIRST DULY SWORN, DEPOSE AND SAY THAT THIS MAP, CONSISTING OF ONE SHEET, HAS BEEN CORRECTLY DRAWN TO THE DESIGNATED SCALE FROM FIELD NOTES OF A SURVEY MADE BY ME, (OR UNDER MY SUPERVISION AND DIRECTION), ON THE TENTH DAY OF MAY, 1995;
THAT IT TRULY AND CORRECTLY REPRESENTS THE EXISTING LOCATION AND EXTENT OF THE WORKS USED TO DIVERT WATER FROM THE LAS VEGAS VALLEY WATER BASIN, IN CLARK COUNTY, BY THE CITY OF LAS VEGAS FOR IRRIGATION, RECREATION AND DOMESTIC PURPOSES. THAT THE EXISTING POINT OF DIVERSION, AND THE BOUNDARY OF ALL LANDS, SHOWING BY 40-ACRE SUBDIVISIONS THE AREAS PROPOSED TO BE IRRIGATED, ARE FULLY AND CORRECTLY DESIGNATED THEREON.

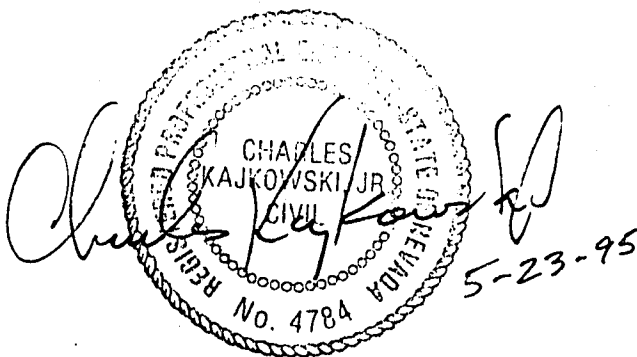

Charles Kajkowski
(STATE WATER RIGHT SURVEYOR No. 692)

SUBSCRIBED AND SWORN TO BEFORE ME THIS 23rd DAY OF May, 1995

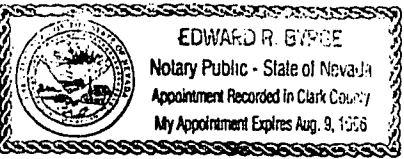

Edward R. Byrge
NOTARY PUBLIC IN AND FOR CLARK COUNTY, NEVADA

MY COMMISSION EXPIRES Aug. 9, 1996



SCALE: 1" = 600'

EXISTING POINT OF DIVERSION AND PLACE OF USE

LEGEND

--- EXISTING PLACE OF USE

BASIS OF BEARINGS

N 89° 57' W BEING THE NORTH LINE OF SEC 32,
T20S, R60E, M.D.M., AS SHOWN BY 1881 G.L.O. SURVEY.

CITY OF LAS VEGAS, NEVADA

MAP TO ACCOMPANY APPLICATIONS TO CHANGE THE
POINT OF DIVERSION, PLACE OF USE AND MANNER OF
USE OF EXIST. PERMIT No.s 36041, 48886 & 52380

BY THE CITY OF LAS VEGAS
FROM THE LAS VEGAS VALLEY WATER BASIN
CLARK COUNTY, NEVADA

SHEET 1 OF 2